
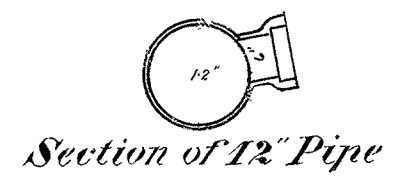
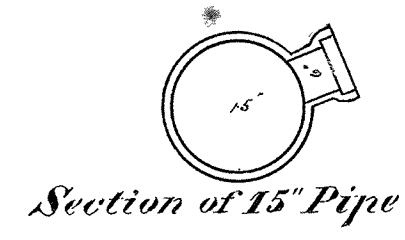


1893


Scale: { Horizontal 60' = 1"
 Vertical 4' = 1"
 Section 2' = 1"

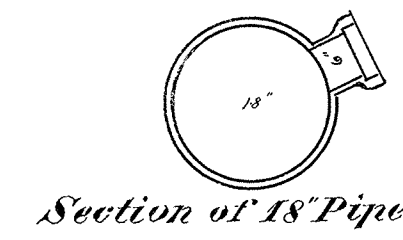

CITY OF SUPERIOR

SEWER PLAN

Contract let Oct. 4, 1892 (to 63rd St)
 completed Dec. 17, 1892
 Johnson, Dalton & Jacobs, Contractor
 Wm. Coleman, Inspector
 A. S. Cooper, City Engineer
 Contract let June 16, 1893 (from 63-64)
 completed July 24, 1893
 Rolan & Bros. Nelson & Co. Contrs.
 Cournoyer & Dever, Inspectors
 A. T. Thomas, City Engineer

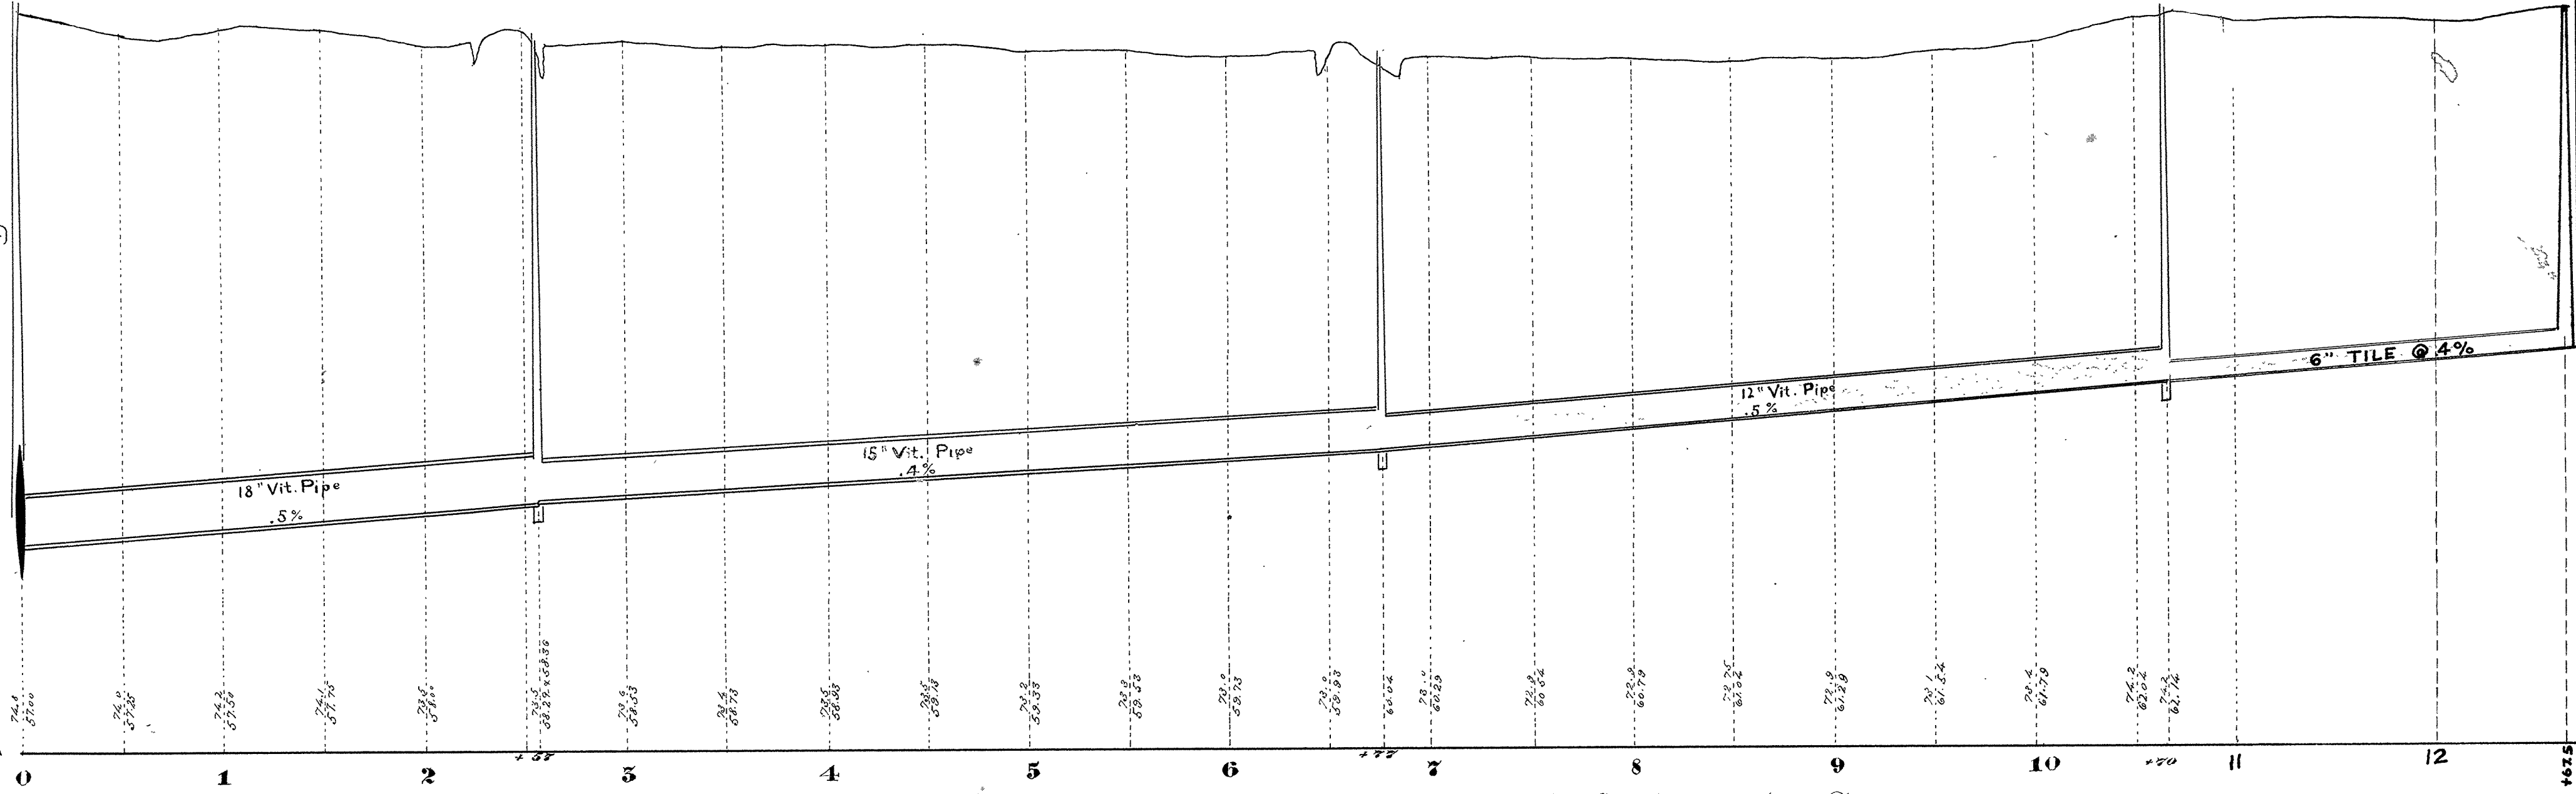

Base line 50ft. above datum

Plan & Profile of Sewer in Alley betw. John & Hughitt Aves. From Central Ave. to Sixtyfourth St.