


**CITY OF SUPERIOR  
SEWER PLAN.**

Horizontal Scale: 1 in. = 60 ft.  
Vertical Scale: 1 in. = 4 ft.

CONTRACT NO. 1190  
Contract let..... Sep 20, 09.  
Contract completed... Dec. 10, 09.  
Stack Bros..... Contractors.  
A. Solin..... Inspector.  
E. B. Banks..... City Engineer.

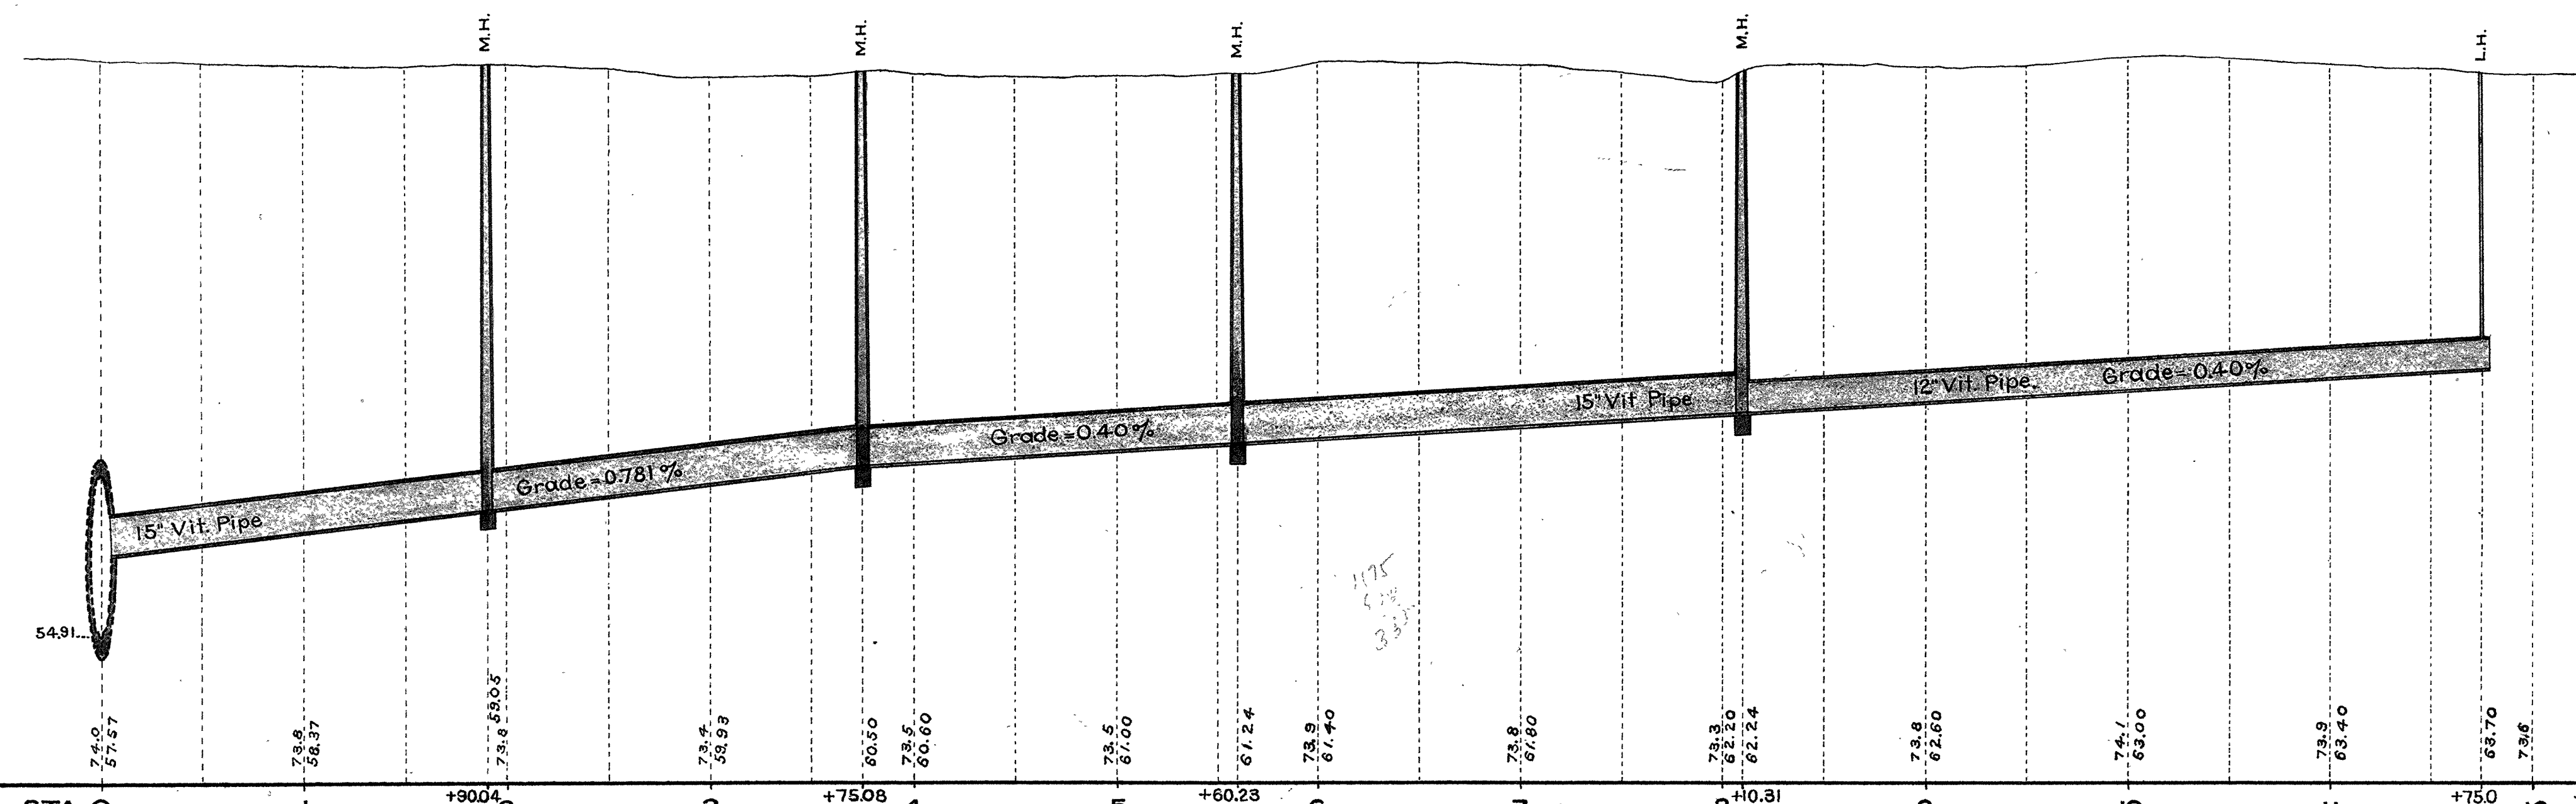

STA. 0 1 2 +800.4 3 4 +750.8 5 6 +60.23 7 8 +0.31 9 10 11 +75.0 12  
*Sewer in the Alleys between Cumming and Baxter Ave. and in Cumming Ave. from Fifty-ninth St. to Alley south of Central Street.*

5-26