

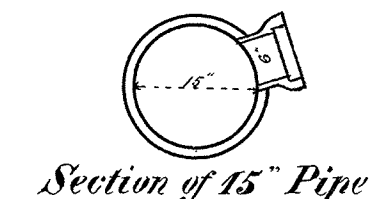


CITY OF SUPERIOR SEWER PLAN



Contract let May 23, 1892
completed Nov. 1, 1892
Johnson & Dole, Contractor
T. A. King & H. A. Carlson, Inspectors
A. S. Cooper, City Engr.

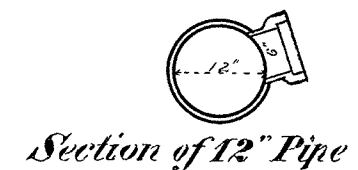

1895

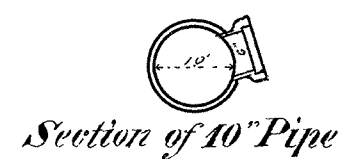

Scale: { Horizontal 60ft. = 1inch
Vertical 4ft. = 1inch
Section 2ft. = 1inch

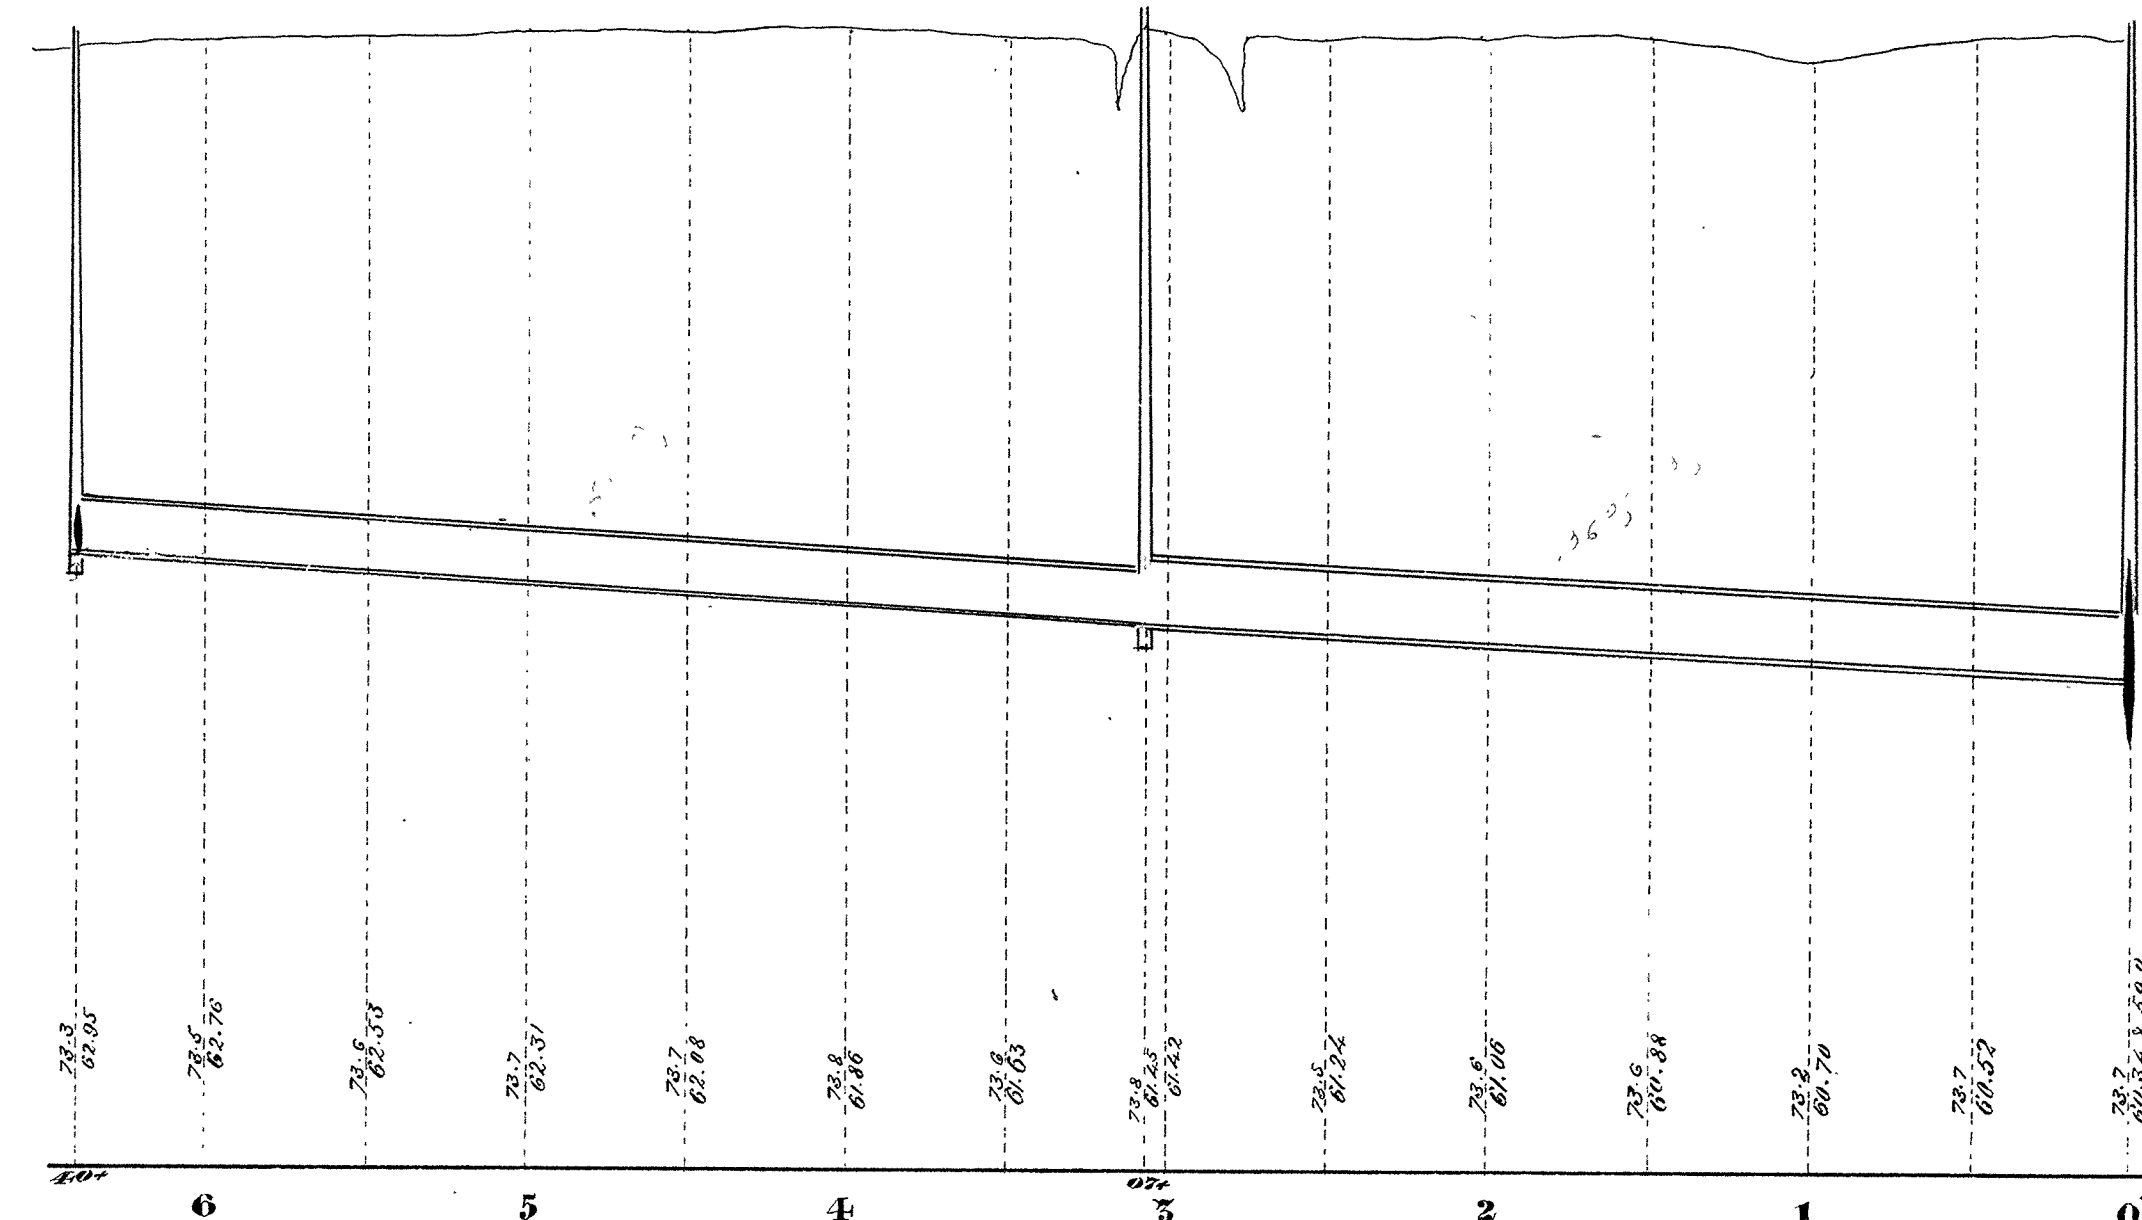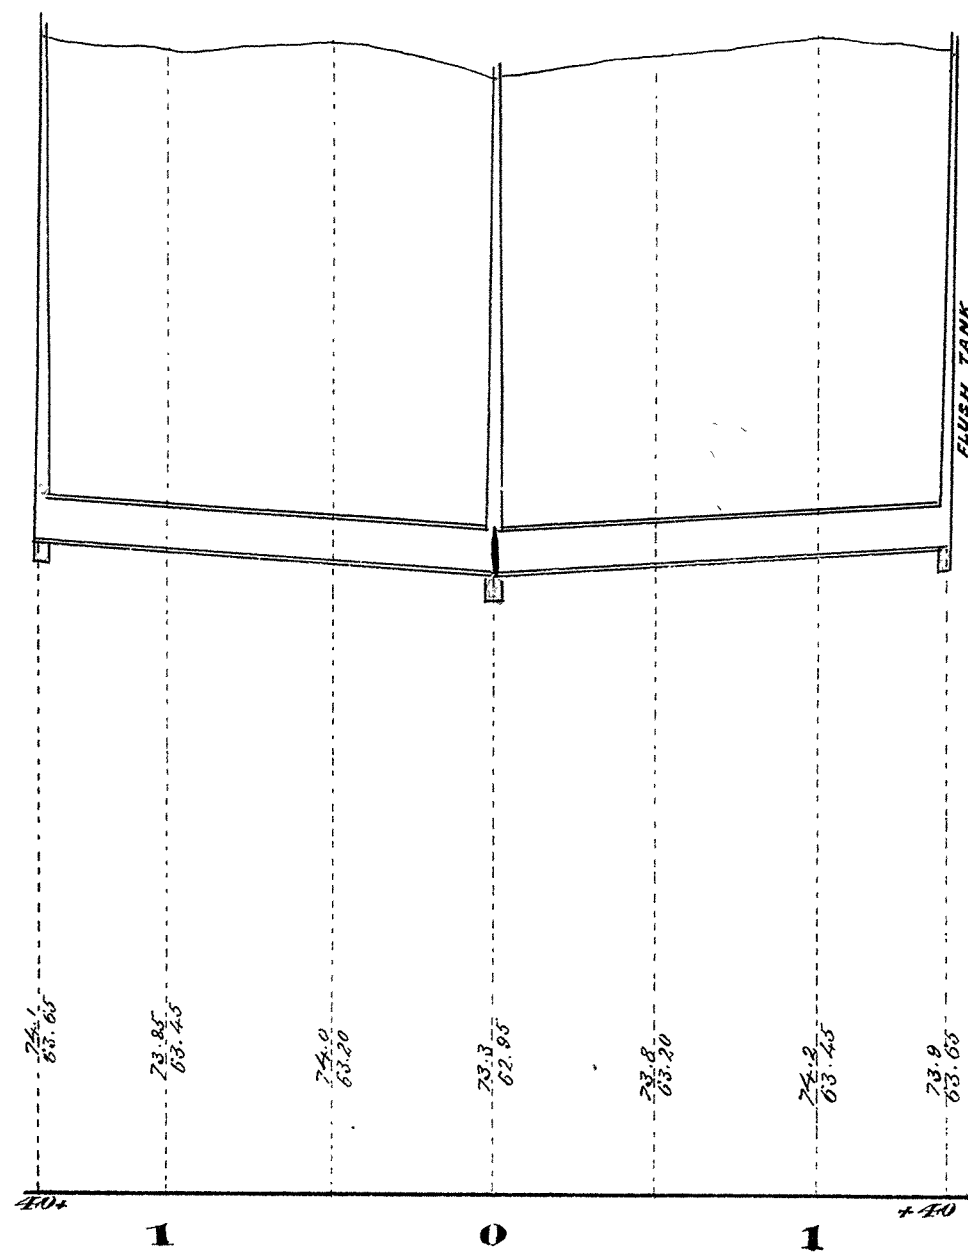

Base line 50ft. above datum