

FIFTYEIGHTH

ST.



1893

CITY OF SUPERIOR

SEWER PLAN

Contract let May 23, 1892
 completed Oct. 12, 1892
 Wolf & Kink, Contractor
 H. A. Carlson, Inspector
 A. S. Cooper, City Engr.

Scale: { Horizontal 1" = 60'
 Vertical 1" = 4'
 Section 1" = 4' x 2'

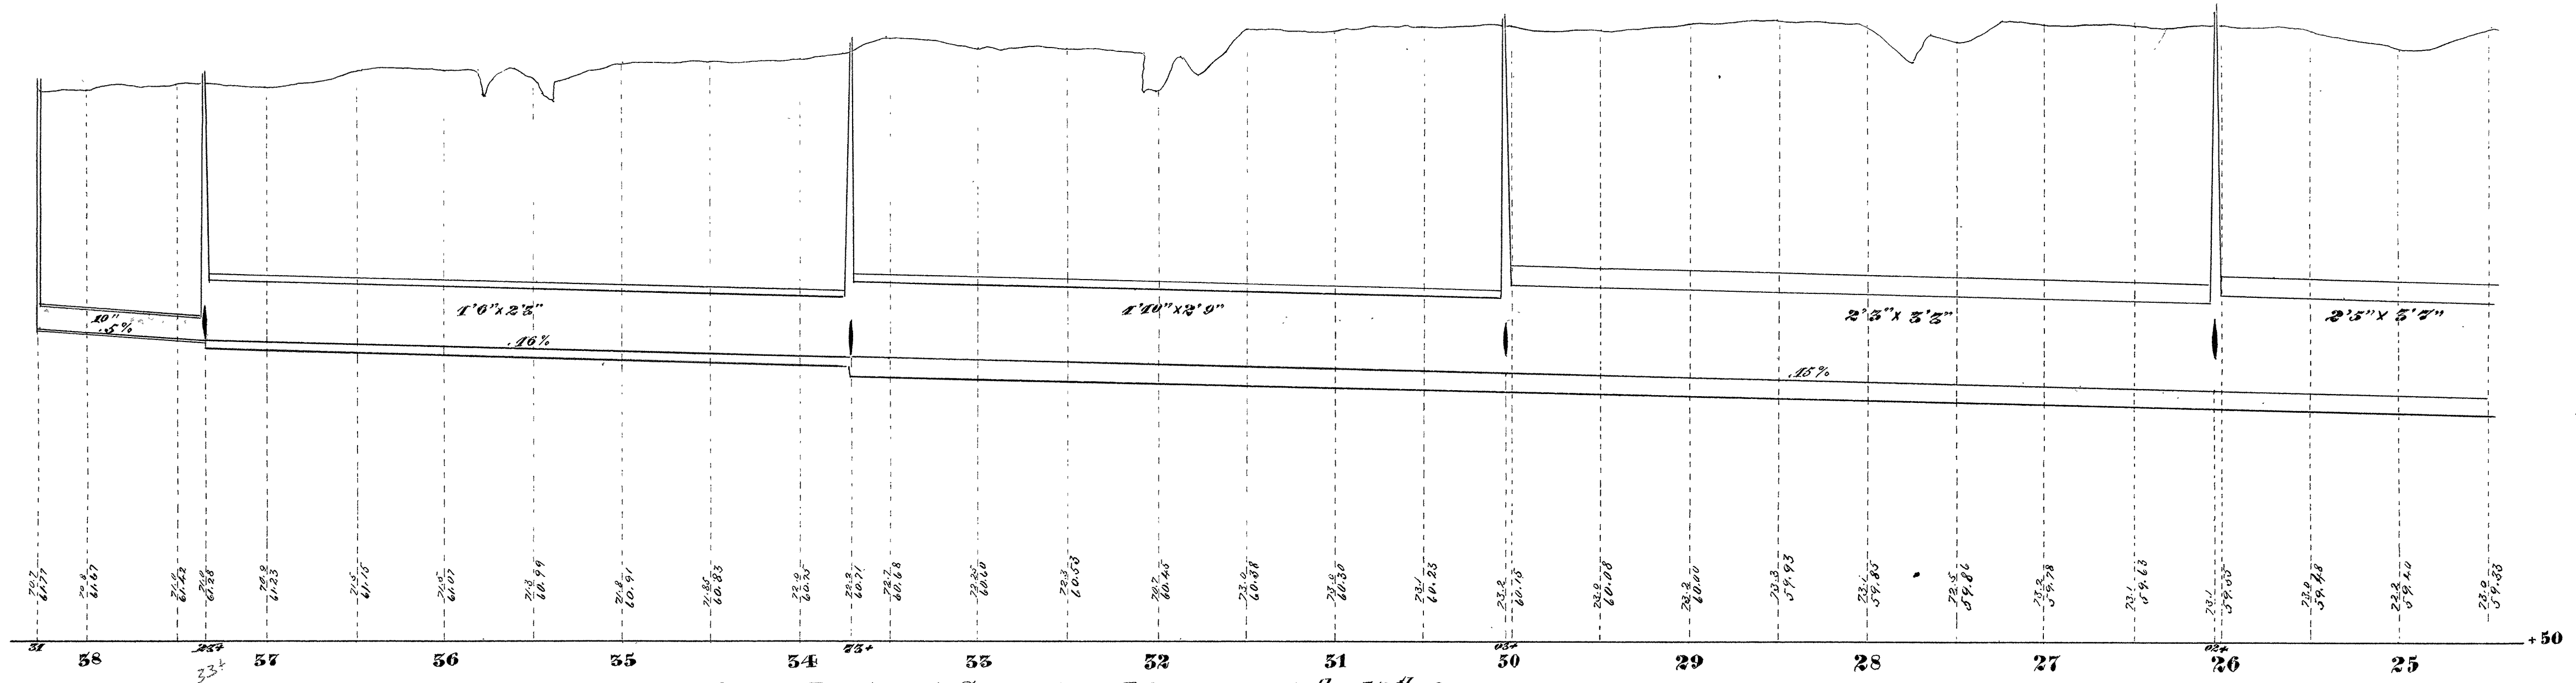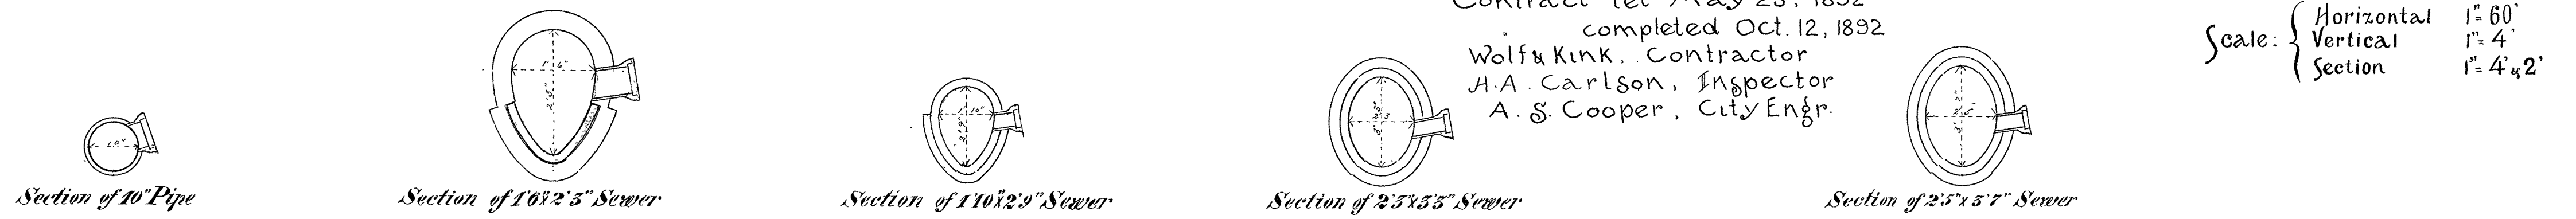

Plan & Profile of Sewer in Alley betw 58th & 57th Strs. from Ogden Ave. to Reg.

5-8