




NOTE: THIS SHEET IS TO BE USED FOR STORM SEWER PURPOSES ONLY.

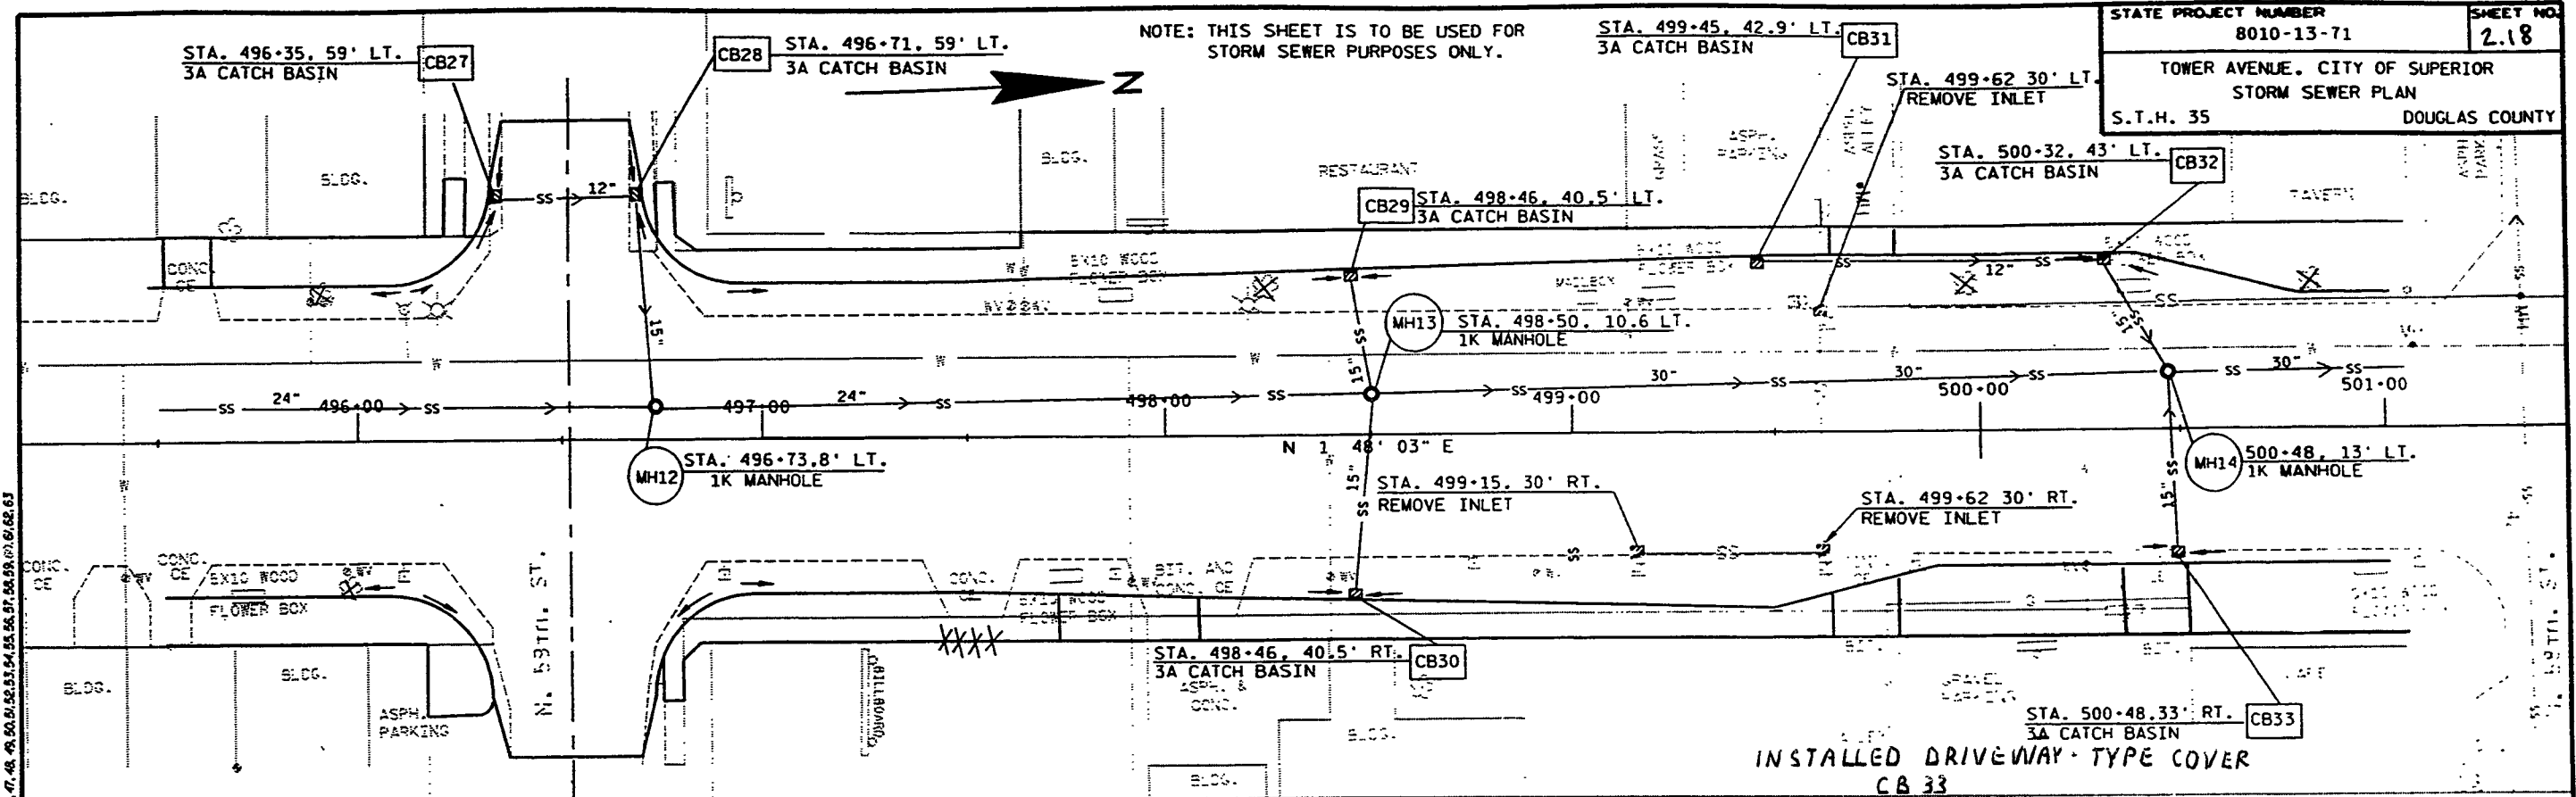

LEVELS ON - 1, 2, 3, 62, 63

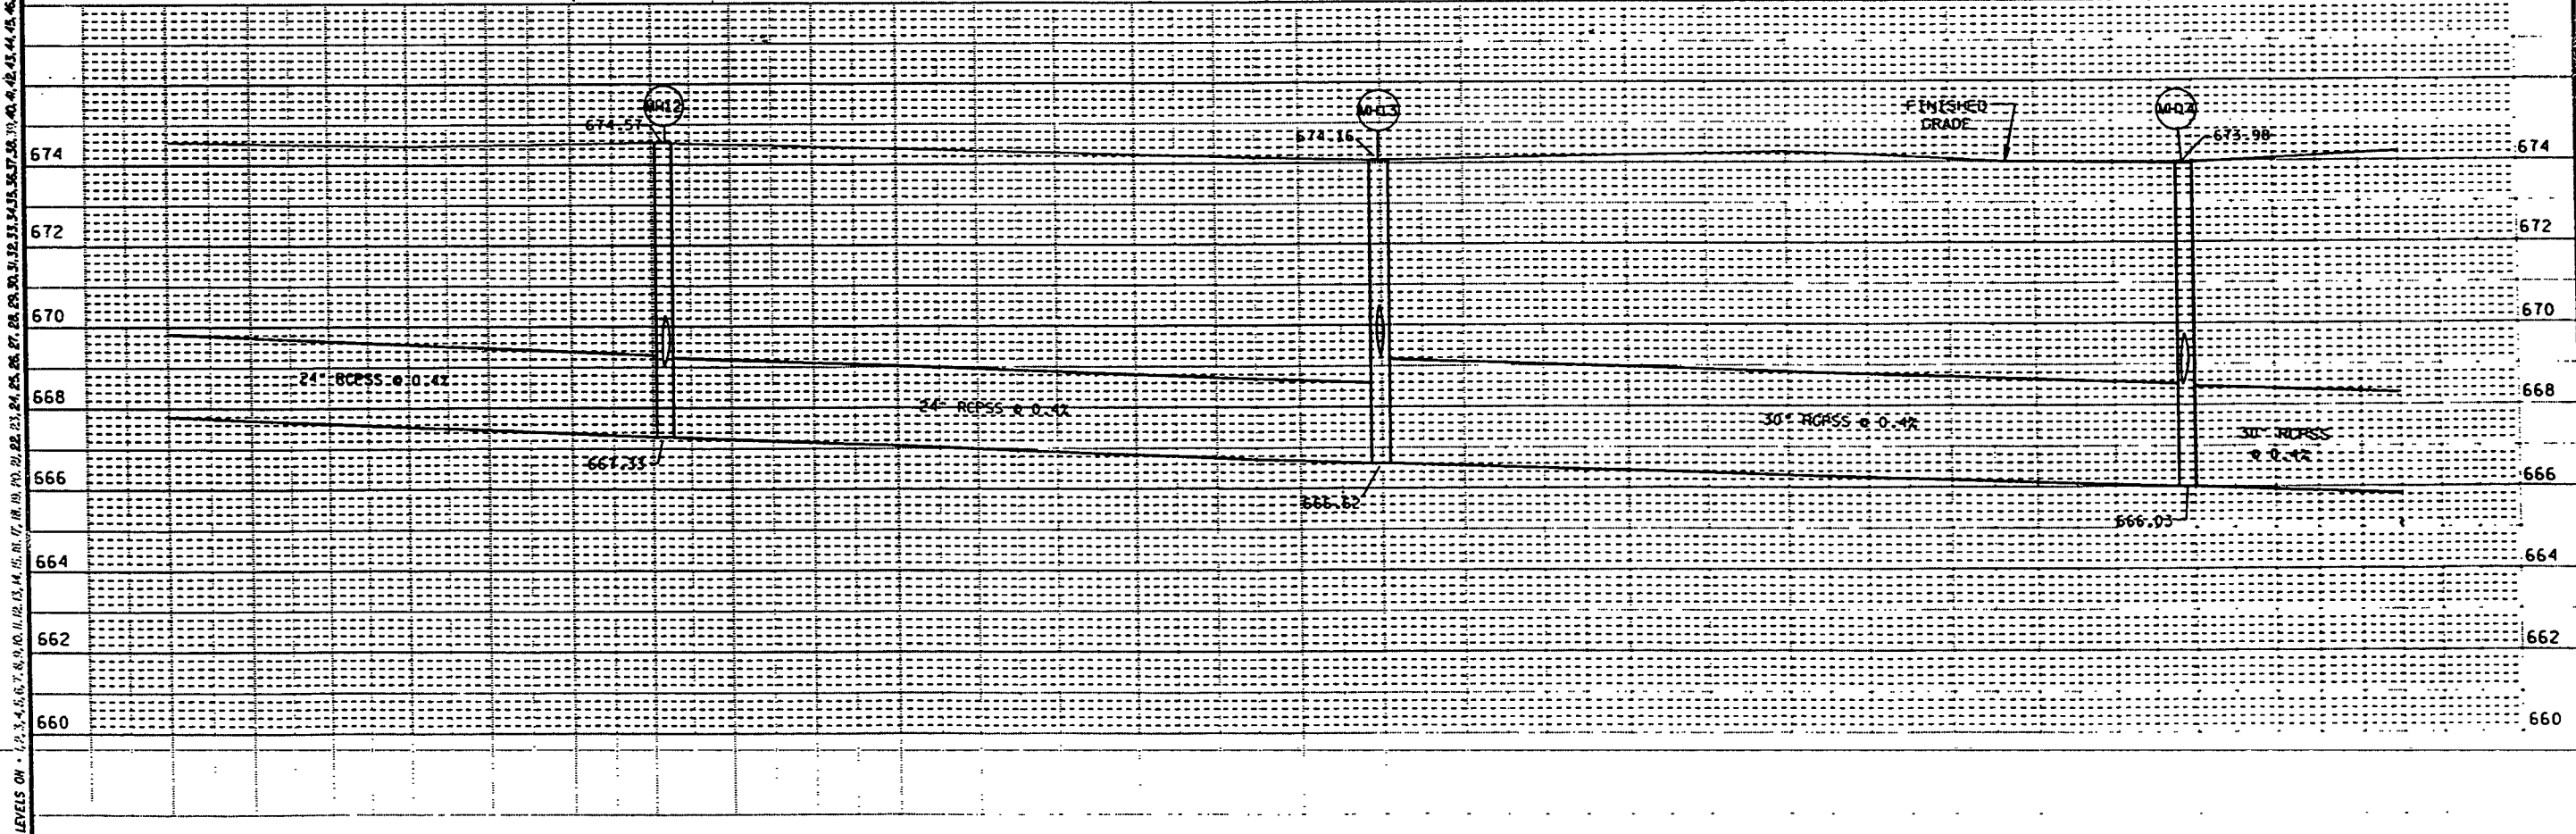

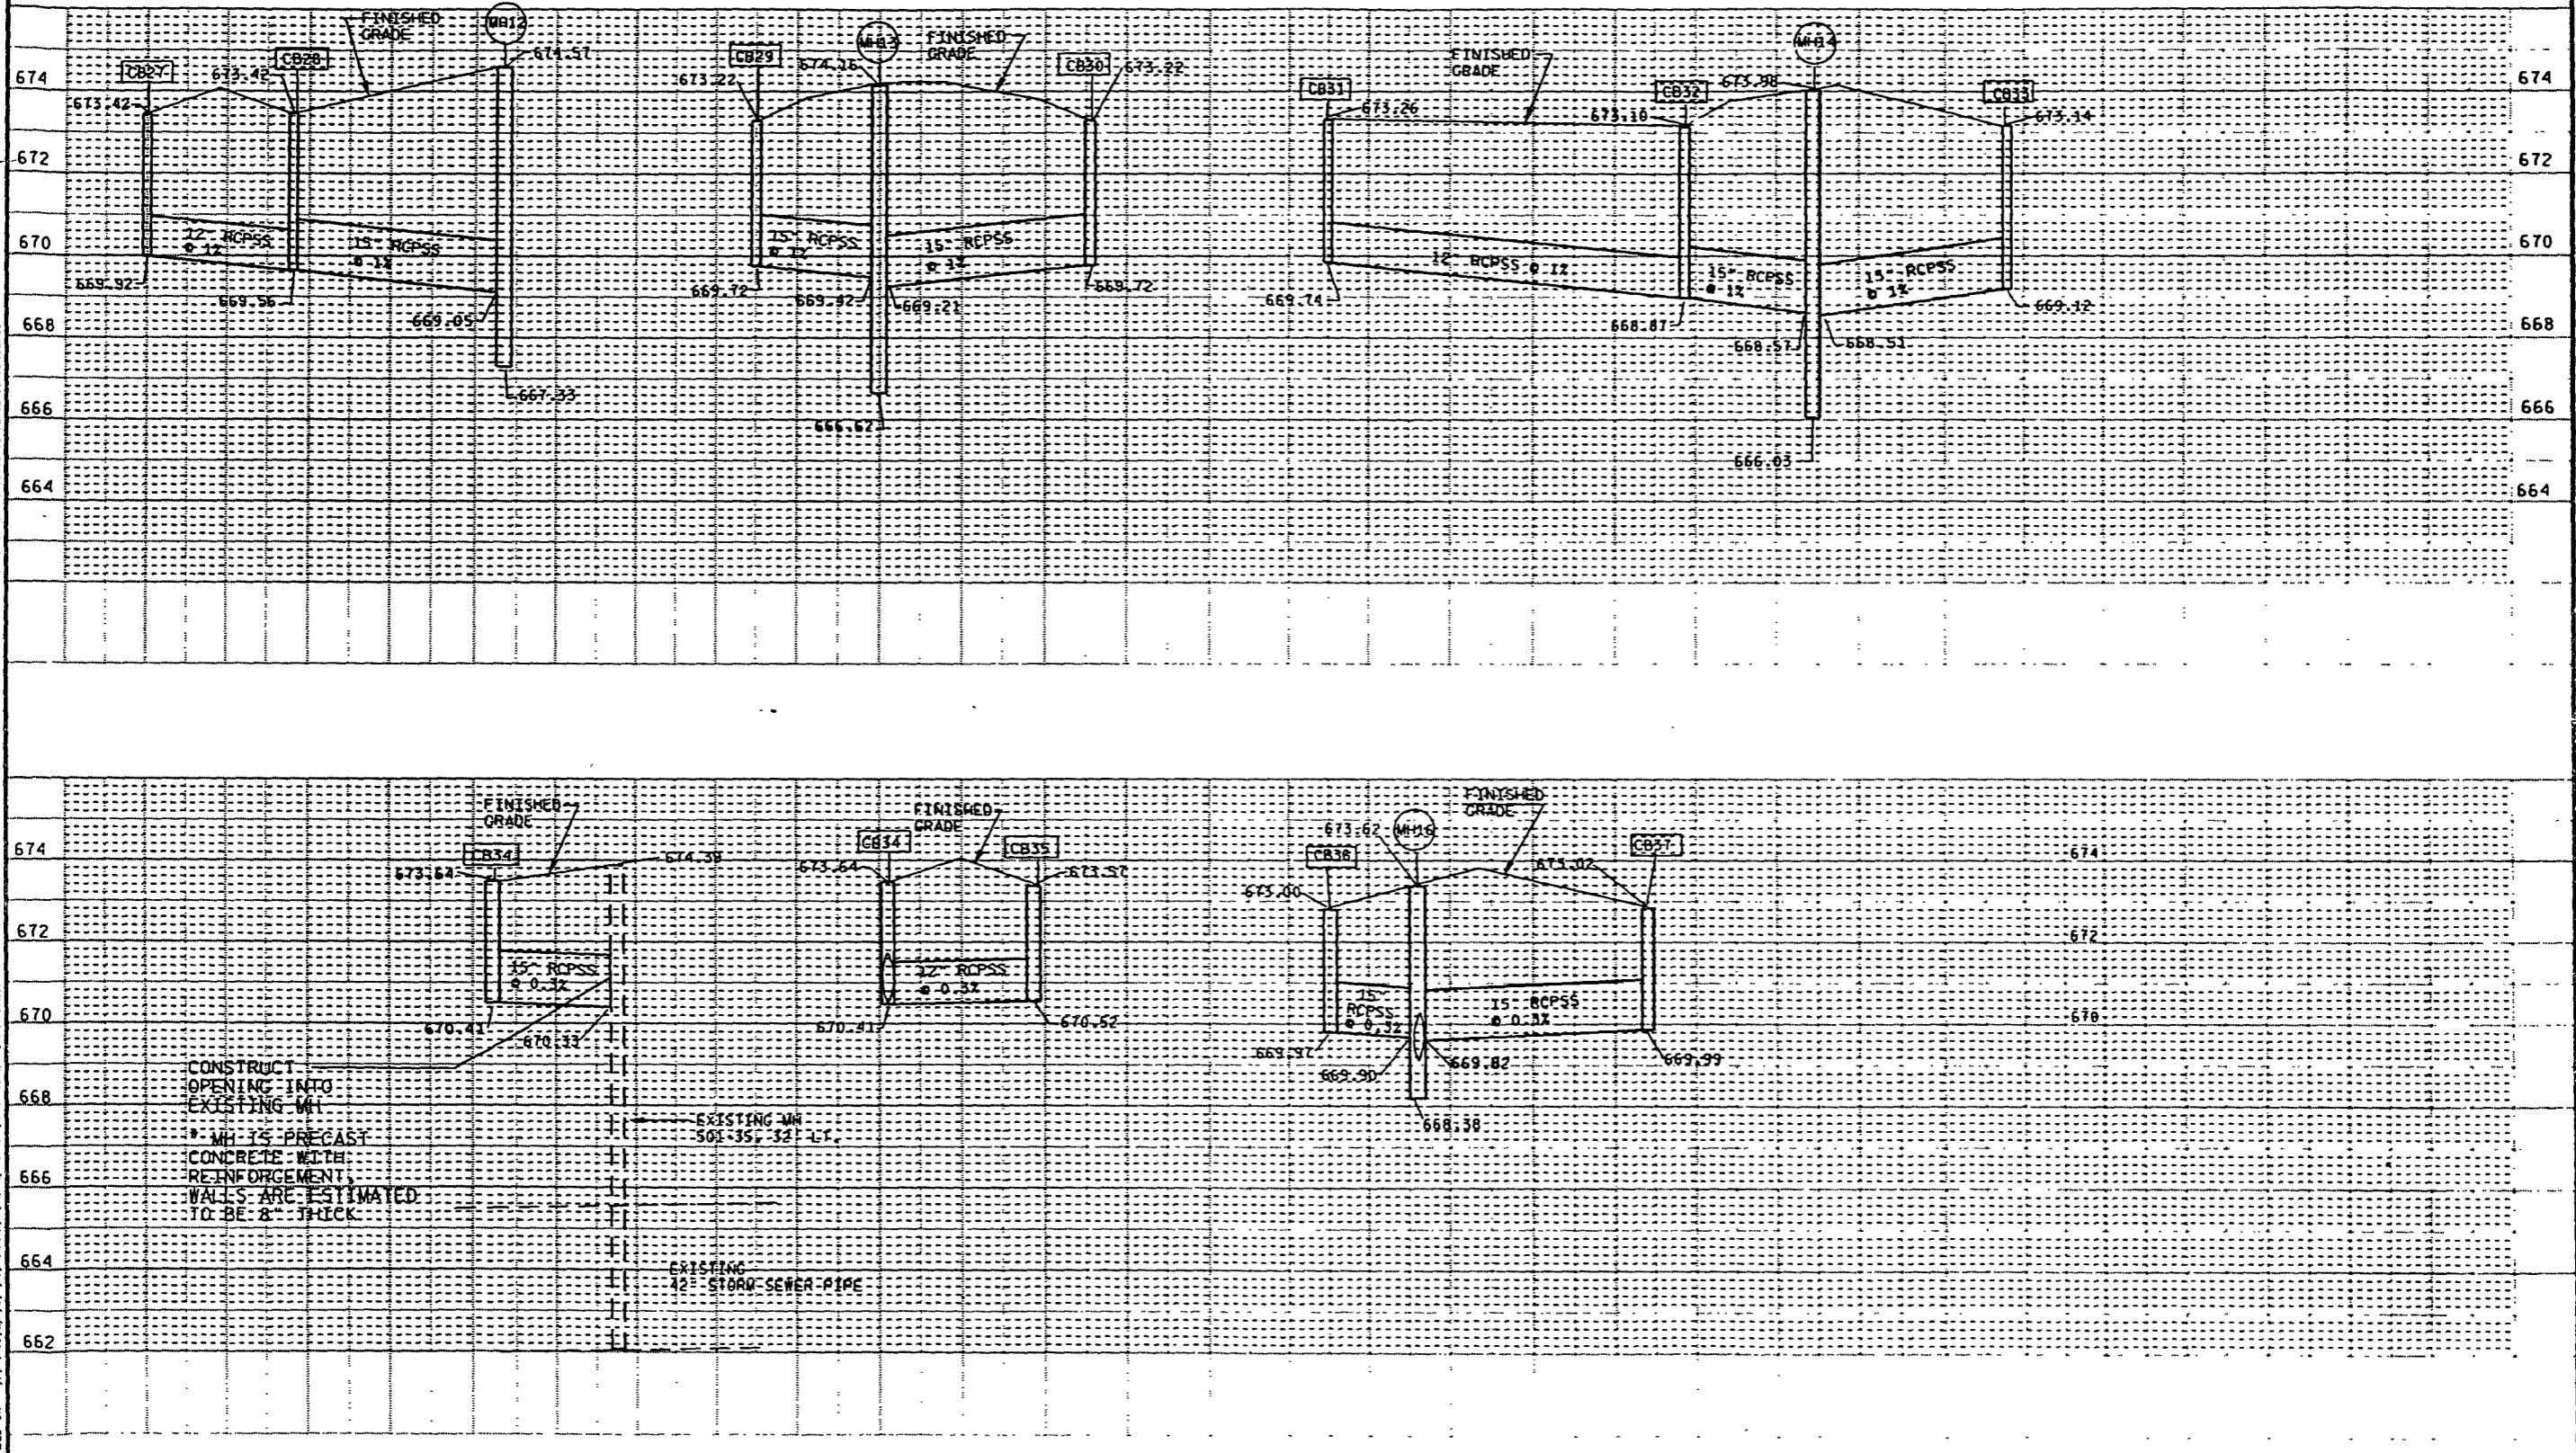

CONSTRUCT
OPENING INTO
EXISTING MH
MH IS PRECAST
CONCRETE WITH
REINFORCEMENT
WALLS ARE ESTIMATED
TO BE 8" THICK

EXISTING MH
50" 35' 32" LT.

EXISTING
12" STORM SEWER PIPE

LEVELS ON: 1, 2, 3, 62, 63