

**A**

DOUGLAS

96/02/20/190  
 HOFFMAN CONSTRUCTION COMPANIES-A JOIN  
 8010-13-71 GENERAL CONSTRUCTION  
 \$2,244,363.37

AS BUILT

STATE PROJECT	FEDERAL PROJECT	
	PROJECT	CONTRACT
8010-13-71	STP 028(52)	1

INDEX OF SHEETS

- Sheet No. 1 Title
- Sheet No. 2-2.68 Typical Sections and Details
- Sheet No. 3-3.5 Estimate of Quantities
- Sheet No. 3A-3.0 Miscellaneous Quantities
- Sheet No. Right of Way Plat
- Sheet No. 5-5.9 Plan and Profile
- Sheet No. 6-6.3 Standard Detail Drawings
- Sheet No. 7-7.29 Sign Plates
- Sheet No. - Structure Plans
- Sheet No. 9-9.1 Computer Earthwork Data
- Sheet No. 9.2-9.5 Cross Sections

TOTAL SHEETS = 218



# TOWER AVENUE, CITY OF SUPERIOR

PLAN OF PROPOSED IMPROVEMENT

(64TH. ST. TO 52ND. ST.)

S.T.H. 35  
 DOUGLAS COUNTY

STATE PROJECT NUMBER  
**8010-13-71**

8010-13-71; STP 028(52)  
 Tower Avenue (64th - 52th Street)  
 STH 35 Douglas County  
 Hoffman Construction Company  
 Gr, CABC, SS, C & G, Con Pav, lighting, etc.  
 STA 474+42 - 527+25 .0988 miles  
 Andy Stensland Cont. 1 D8


begin const. April 28, 1996  
 end const. May 31, 1997

DESIGN DESIGNATION

A.D.T. (1995)	=	12,900
A.D.T. (2015)	=	16,530
D.H.V. (2015)	=	1,770
D.	=	60-40
T. ADT	=	6.0%
DESIGN SPEED	=	25 MPH
ESALS	=	N/A

CONVENTIONAL SIGNS

COUNTY LINE		COMBUSTIBLE FLUIDS	
CORPORATE LIMITS		UNDERGROUND UTILITIES	
PROPERTY LINE		GAS	
LOT LINE		ELECTRIC	
LIMITED EASEMENT		TELEPHONE OR TELEGRAPH	
EXISTING RIGHT OF WAY		SERVICE PEDESTAL	
PROPOSED OR NEW R/W LINE		CABLE MARKER	
SURVEY LINE		POWER POLE	
SLOPE INTERCEPT		TELEPHONE POLE	
ORIGINAL GROUND		RAILROAD	
MARSH OR ROCK PROFILE		MARSH AREA	
EXISTING CULVERT		WOODED OR SHRUB AREA	
PROPOSED CULVERT (Box or Pipe)			
CULVERT (Profile View)			

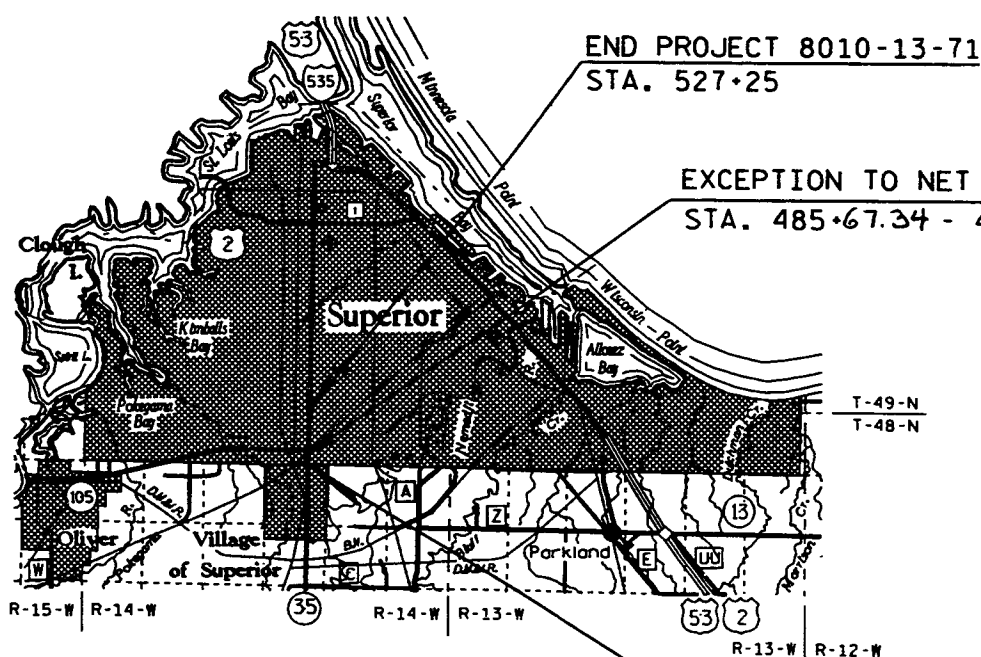

END PROJECT 8010-13-71  
 STA. 527+25

EXCEPTION TO NET & LENGTH  
 STA. 485+67.34 - 485+80.14

BEGIN PROJECT 8010-13-71  
 STA. 474+42  
 N. 552,300 (±100')  
 E. 1,471,800 (±100')

LAYOUT  
 SCALE 0 2 MI.

TOTAL NET LENGTH OF CENTERLINE = 0.998 MI. (URBAN)

COORDINATE NOTE:  
 ALL COORDINATES ARE REFERENCED TO THE WISCONSIN COORDINATE SYSTEM, CENTRAL ZONE AND SCALED FROM U.S.G.S. TOPOGRAPHIC MAP SUPERIOR, WISCONSIN-MINNESOTA QUADRANGLE FOR IDENTIFICATION ONLY.

ELECTRICAL/LIGHTING CONSULTANT:

DATE 10-20-95

---

APPROVED FOR CITY OF SUPERIOR

DATE 11-1-95

---

STATE OF WISCONSIN  
 DEPARTMENT OF TRANSPORTATION

PREPARED BY

Surveyor GARY GALLFORD

Designer BARBARA KERBER

District Examiner ORVILLE KING

District Supervisor RICHARD H. WASHBURN

C.O. Coordinator  

C.O. Examiner  

---

APPROVED FOR DISTRICT OFFICE

DATE 11-1-95

---

AUTHORIZED FOR CENTRAL OFFICE DESIGN

DATE 12-15-95

60V  
2.00T