
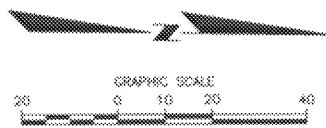


G:\2000\PROJ\100552090\dwg\Apron\Plan-Sheets-Plot.DWG, 6/27/2005 2:51:26 PM, M.R.E.

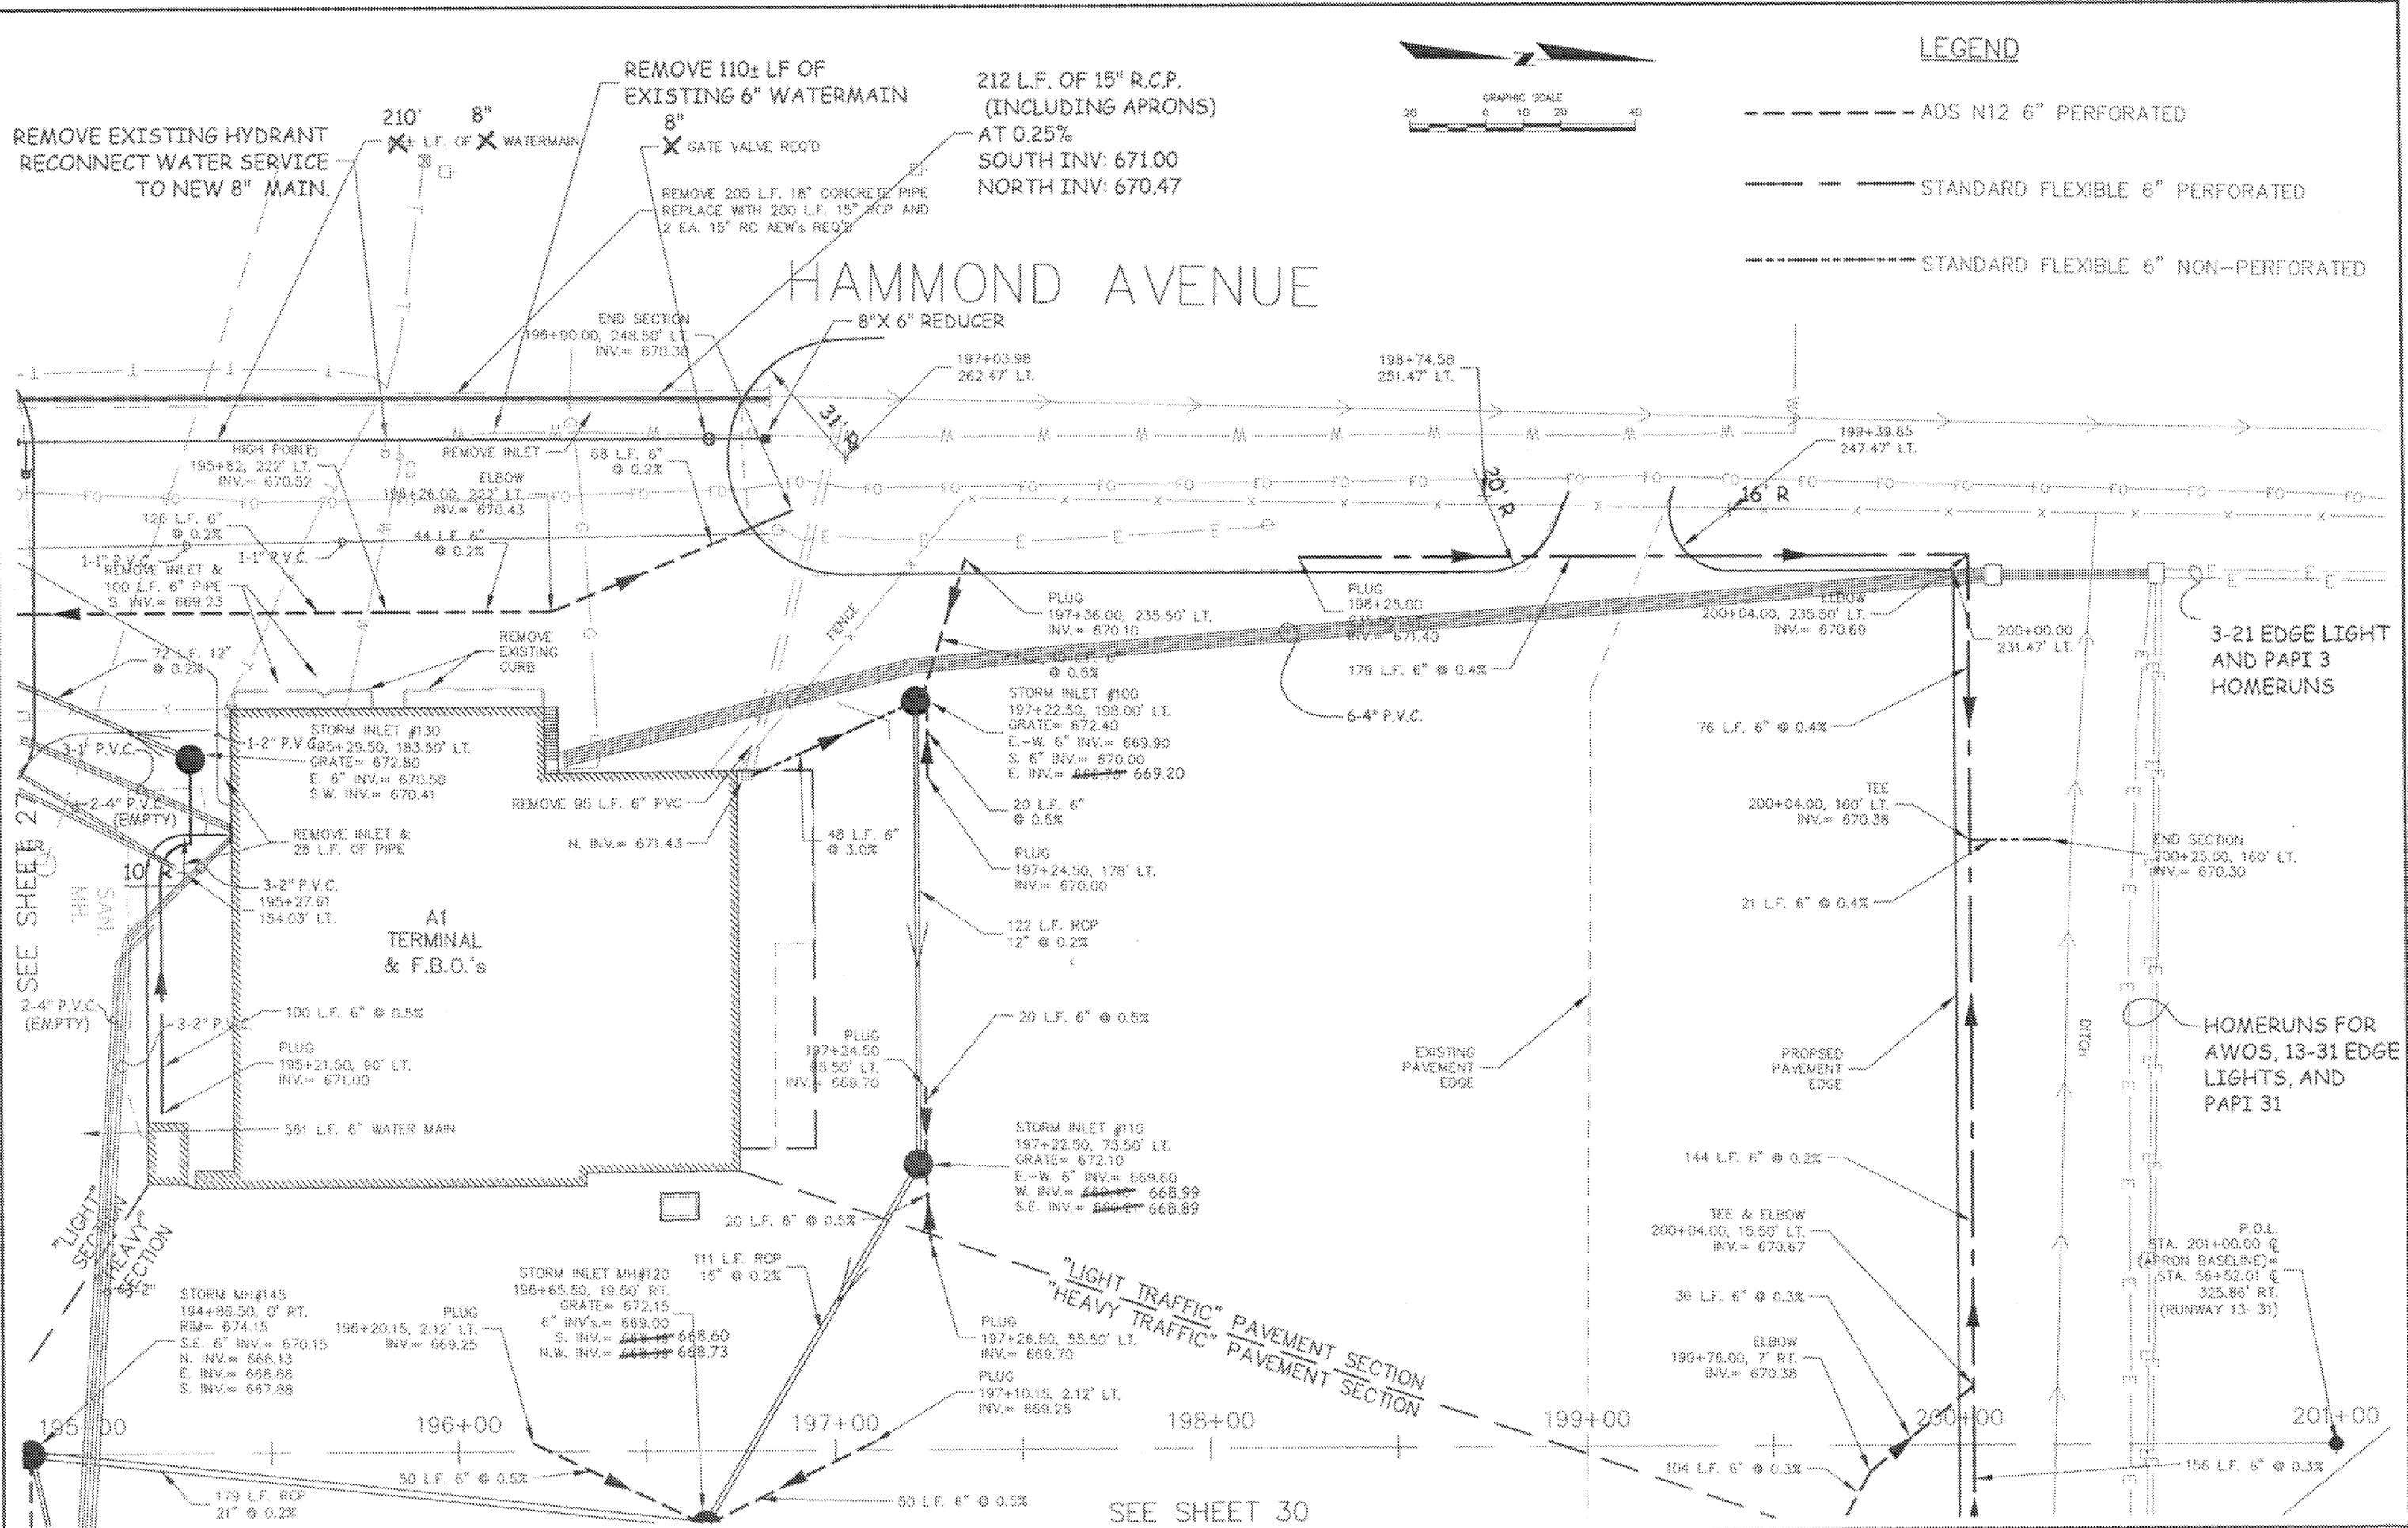

LEGEND

- ADS N12 6" PERFORATED
- STANDARD FLEXIBLE 6" PERFORATED
- STANDARD FLEXIBLE 6" NON-PERFORATED

SEE SHEET 30

PROJECT MANAGER BRAD VOLKER		310 WEST SOUTH STREET, P.O. BOX 230 RICE LAKE, WISCONSIN 54868-0230 TELEPHONE (715) 234-7008 FAX (715) 234-1025		RICHARD I. BONG MEMORIAL AIRPORT SUPERIOR, WISCONSIN		SHEET DESCRIPTION PLAN SHEETS 3-55-0083-07		DATE 05-'03		DRAWN BY J.T.D.	
CHECKED BY: W.R.		COOPER ENGINEERING						SCALE AS NOTED		PROJECT NO. 00552090	
APPROVED BY: B.R.M.										SHEET NO. 29	