


LEGEND

EXIST. SAN SEWER	→ → → → →
SAN. SEWER TO INSTALL	→ → → → →
SAN. M.H.'s TO INSTALL	●
EXIST. WATER LINES	— — — —
WATER LINES TO INSTALL	— — — —
GATE VALVES TO INSTALL	⊗
HYDRANTS TO INSTALL	⊗
EXIST. OIL LINES	— ○ — ○ — ○ — ○ —
OIL LINES TO INSTALL	— ○ — ○ — ○ — ○ —

NOTE: This sheet shows the general layout of the proposed sanitary sewer and water facilities, and the oil line relocation. For details and profiles see the following sheets.

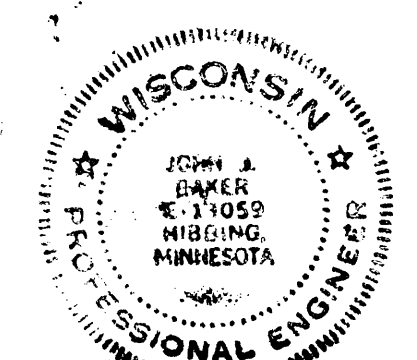

I hereby certify that these plans were prepared by me or under my direct supervision and that I am a duly Registered Professional Engineer under the laws of the State of Wisconsin.

John A. Baker
 John A. Baker
 February 11, 1974 Reg. No. E13059

As Built Nov. 1975

OVERALL PLAN - SANITARY SEWER, WATER LINE & OIL LINE RELOCATION

SUPERIOR INDUSTRIAL PARK

SCALE 1" = 100'
 DATE
 ROBERT R. WALLACE & ASSOC., INC.
 HIBBING, MINNESOTA

PROJ. NO. EDA 06-01-01121 Sheet No. 10 of 29

12+51
 12+18
 36'
 12+18
 11+54
 34'
 8+16
 8+12
 34'