


KIRK ROLSON ST.
LOOKING EAST

KIRK ROLSON ST.
LOOKING EAST

FINAL SURVEY SURVEYED BY DATE
PLOTTED BY
NOTE BOOK NO. TEMPLATE AREAS CHECKED

ORIGINAL SURVEY SURVEYED BY DATE
PLOTTED BY
NOTE BOOK NO. TEMPLATE AREAS CHECKED

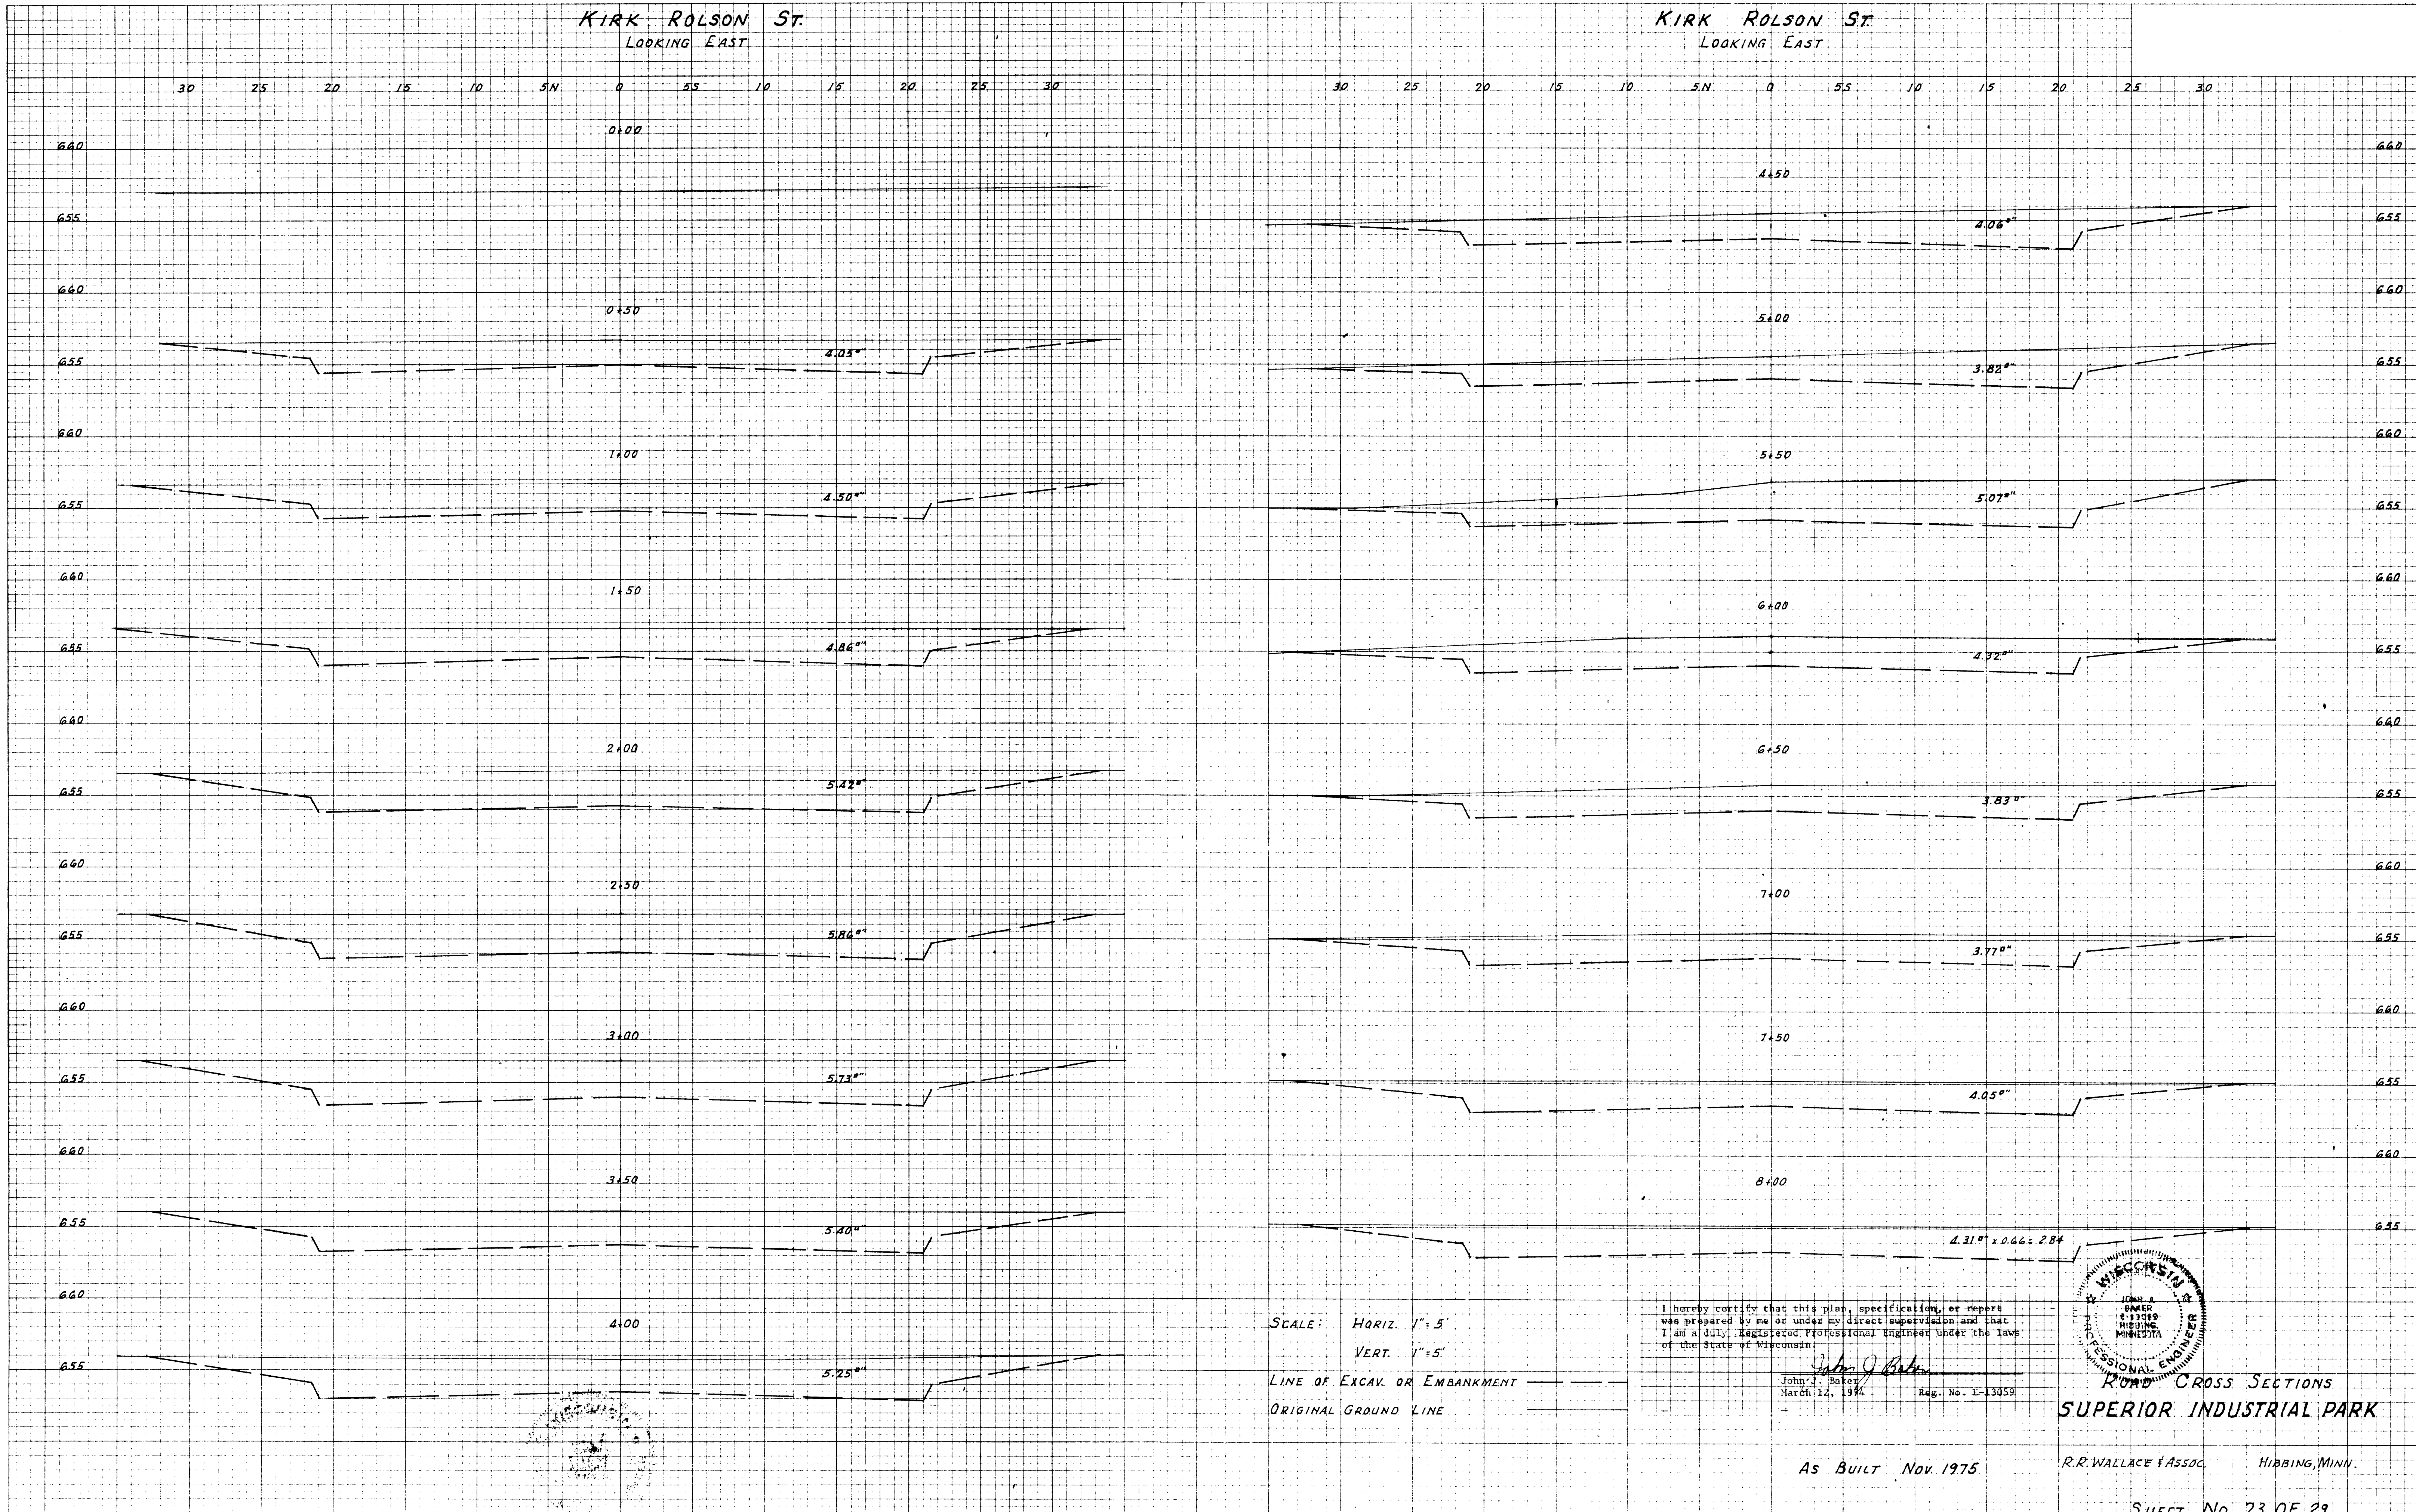


SCALE: HORIZ. 1" = 5'
VERT. 1" = 5'

LINE OF EXCAV. OR EMBANKMENT
ORIGINAL GROUND LINE

I hereby certify that this plan, specification, or report was prepared by me or under my direct supervision and that I am a duly Registered Professional Engineer under the laws of the State of Wisconsin.

John J. Baker
March 12, 1974 Reg. No. E-13059

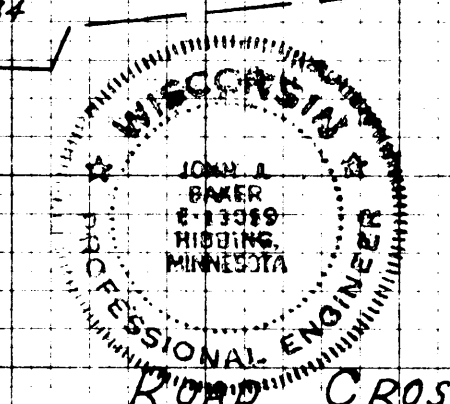

R.R. WALLACE & ASSOC.
SUPERIOR INDUSTRIAL PARK
HIBBING, MINN.

AS BUILT NOV. 1975

R.R. WALLACE & ASSOC. HIBBING, MINN.

SHEET NO. 23 OF 29