

JAMES DAY AVE.
LOOKING SOUTH



JAMES DAY AVE.
LOOKING SOUTH

30 25 20 15 10 5E 0 5W 10 15 20 25 30

30 25 20 15 10 5E 0 5W 10 15 20 25 30

FINAL SURVEY
BY: _____ DATE: _____
SURVEYED _____
PLOTTED _____
NOTE BOOK, TEMPLATES, _____
NO. _____ AREAS CHECKED _____

ORIGINAL SURVEY
BY: _____ DATE: _____
SURVEYED _____
PLOTTED _____
NOTE BOOK, TEMPLATES, _____
NO. _____ AREAS CHECKED _____

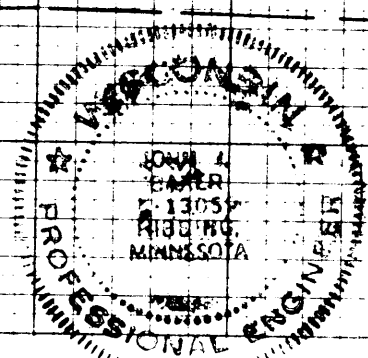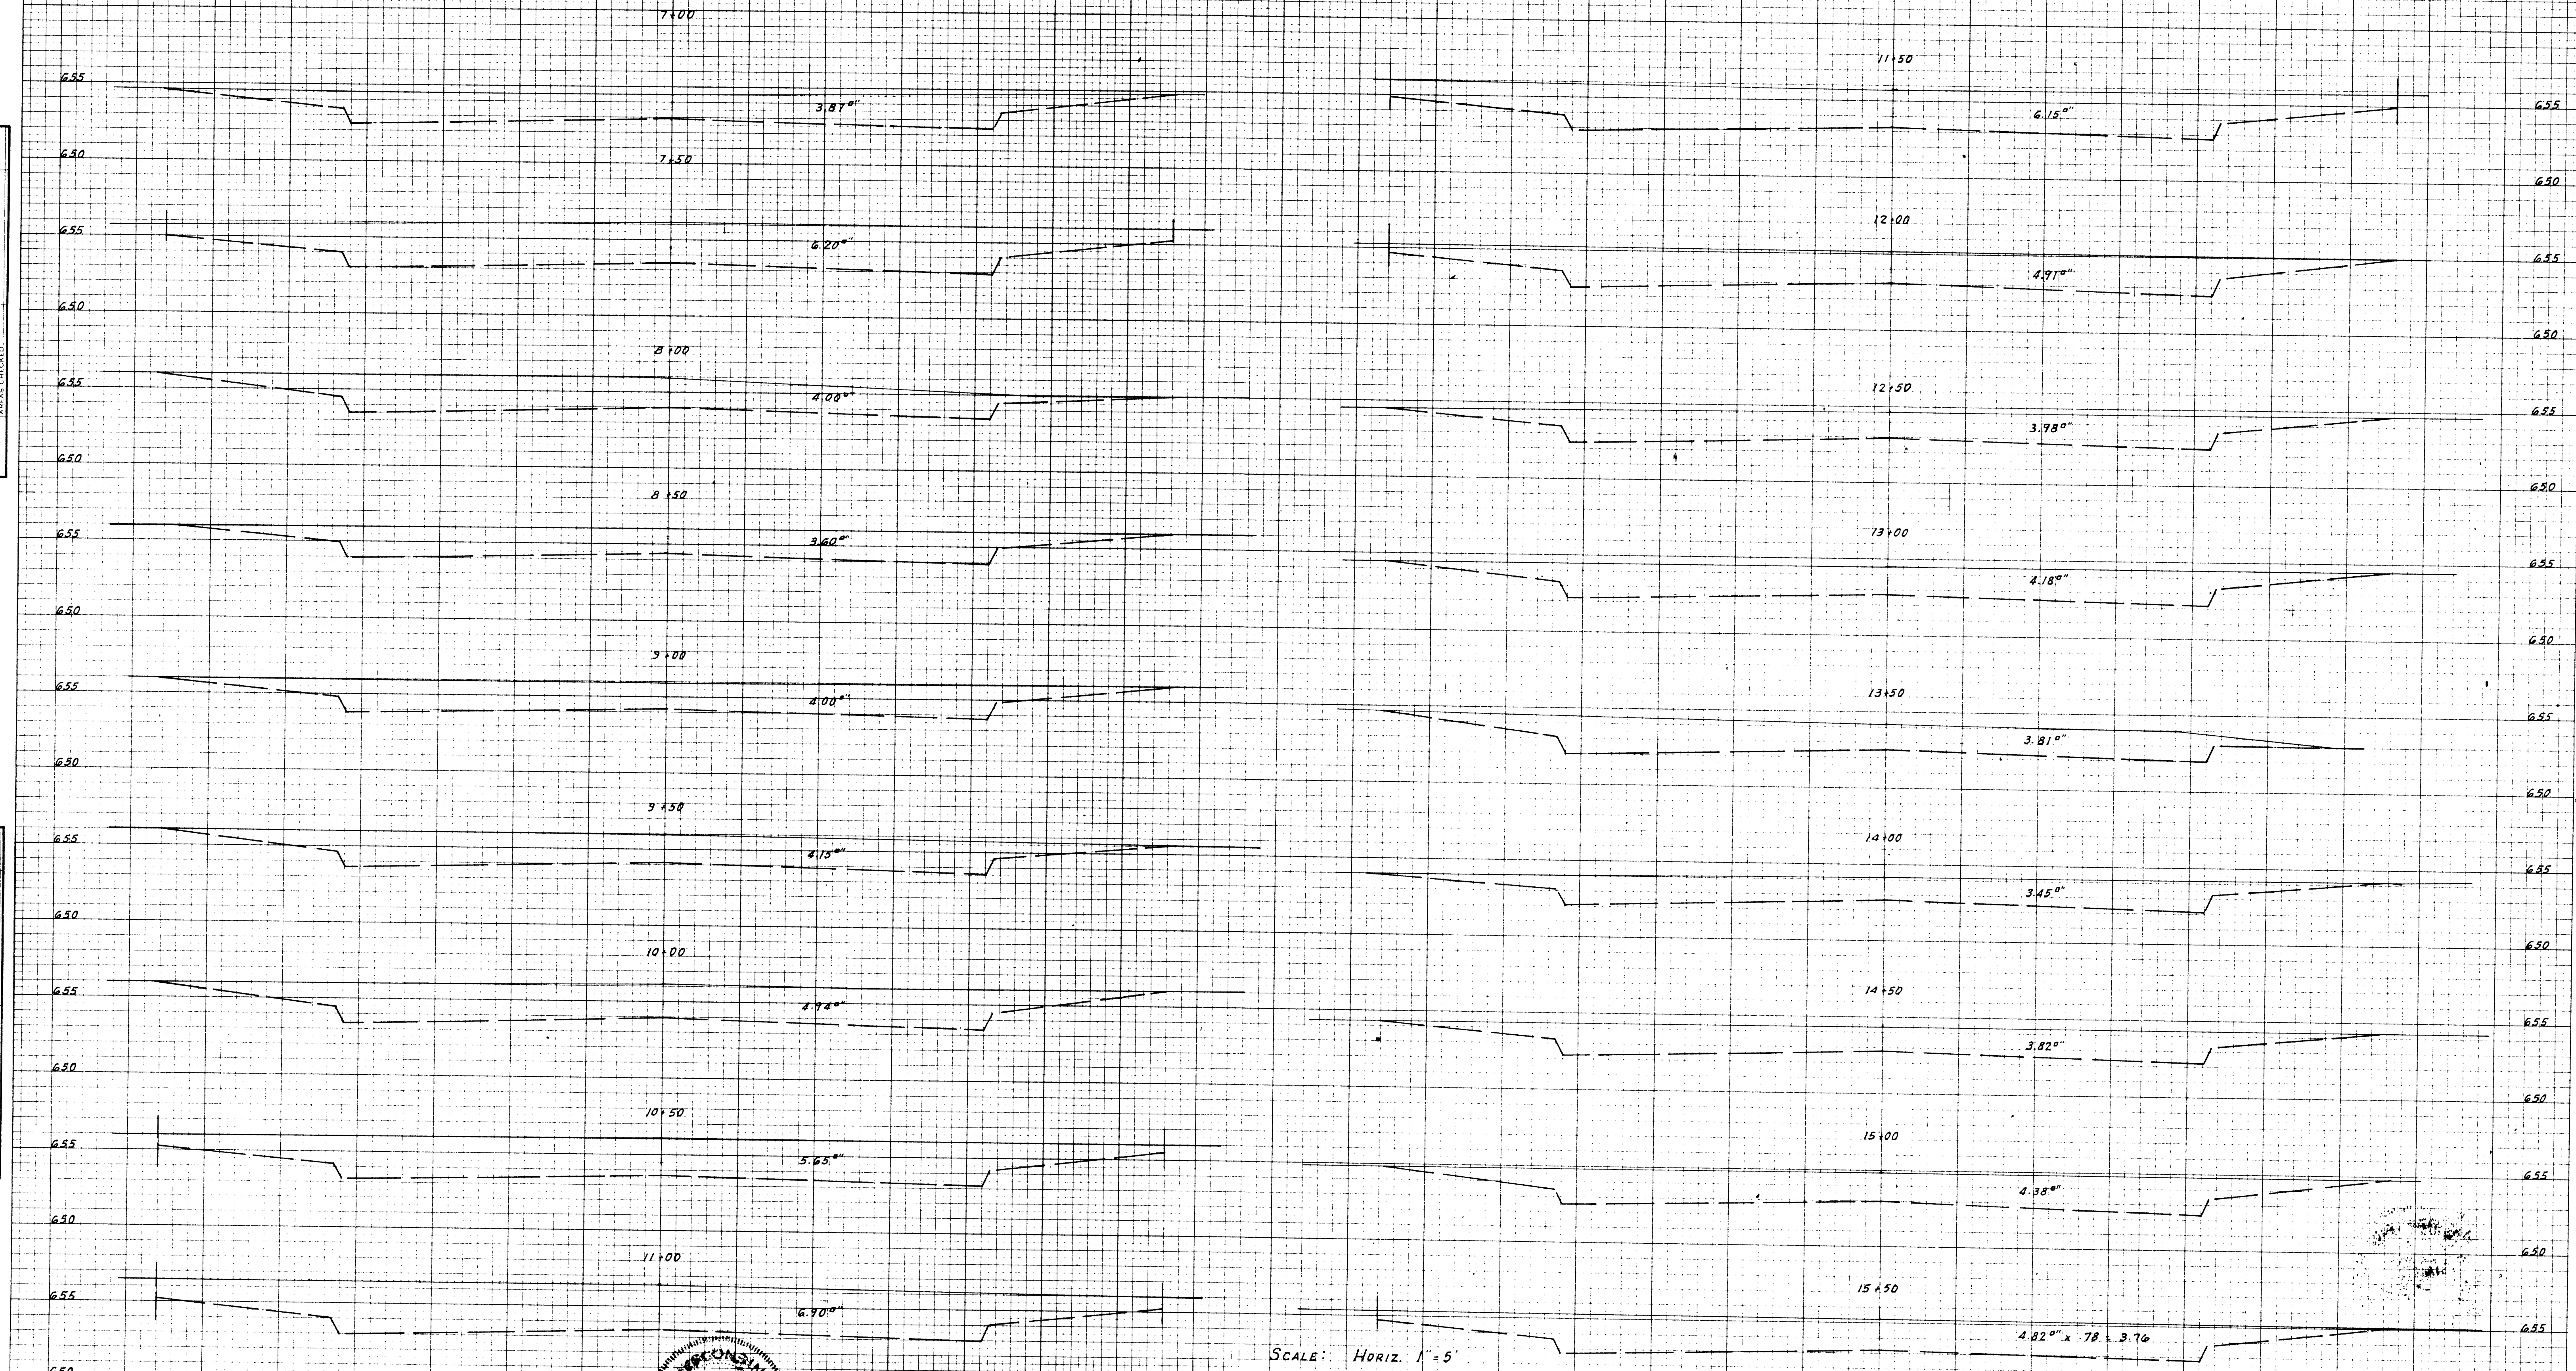

I hereby certify that this plan, specification, or report was prepared by me or under my direct supervision and that I am a duly Registered Professional Engineer under the laws of the State of Wisconsin.
John A. Baker
March 12, 1964

SCALE: HORIZ. 1" = 5'
VERT. 1" = 5'
LINE OF EXCAV. OR EMBANKMENT
ORIGINAL GROUND LINE

AS BUILT NOV 1975

ROAD CROSS SECTIONS
SUPERIOR INDUSTRIAL PARK
R.R. WALLACE & ASSOC.
HIBBING, MINN.
SHEET NO. 25 OF 29

NATIONAL TRACING PAPER DIVISION