



WEST SIDE
LOOKING NORTH (0 IS RAILROAD R/W)

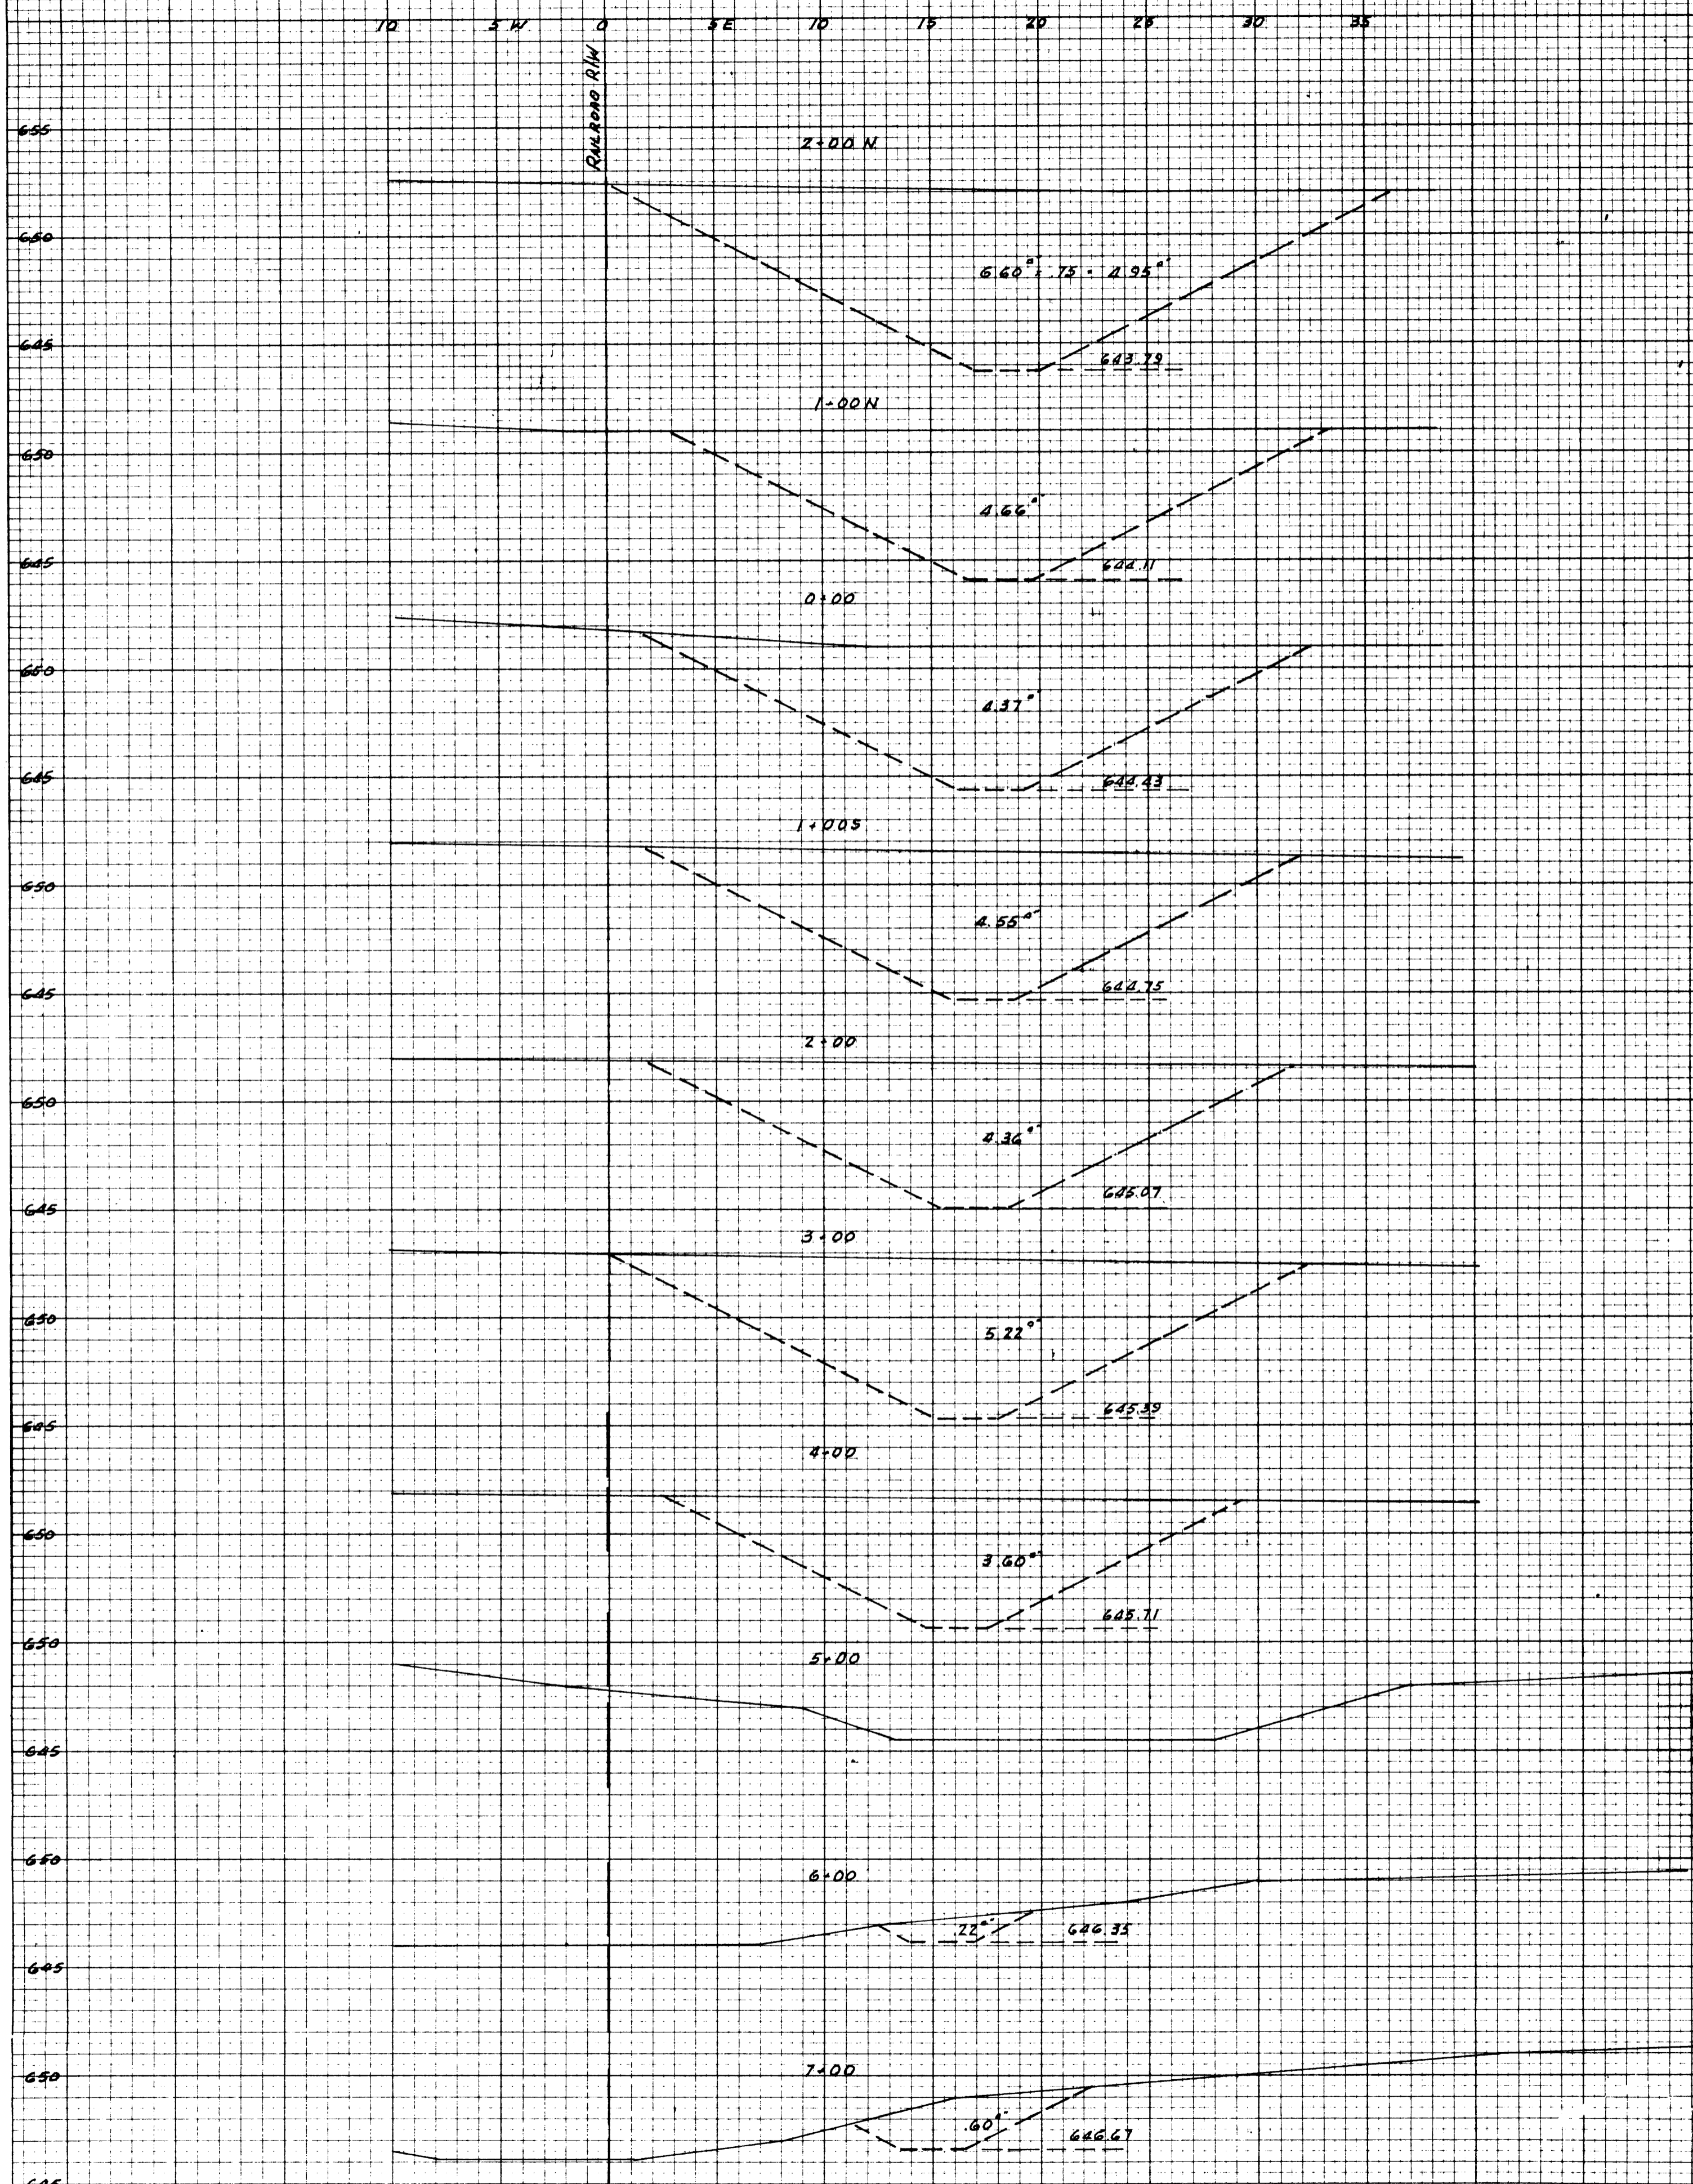

FINAL SURVEY PLOTTED TEMPLATE AREAS CHECKED
BY DATE

ORIGINAL SURVEY PLOTTED TEMPLATE AREAS CHECKED
BY DATE

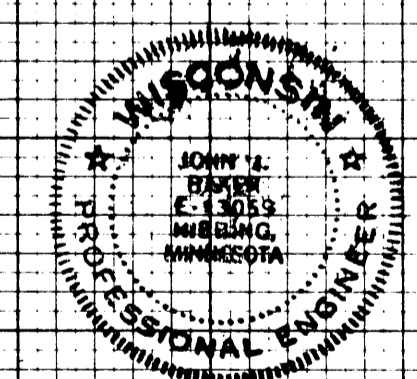

I hereby certify that this plan, specification, or report was prepared by me or under my direct supervision and that I am a duly registered Professional Engineer under the laws of the State of Wisconsin.
John J. Baker
John J. Baker
March 13, 1974 Reg. No. E-13059

SCALE Horiz: 1" = 50'
VERT: 1" = 5'
LINE OF EXCAV OR EMBANKMENT
ORIGINAL GROUND LINE

As BUILT Nov 1975
DITCH CROSS SECTIONS
SUPERIOR INDUSTRIAL PARK
R.R. WALLACE & ASSOC. HIBBING, MINN.
SHEET No. 29 OF 29