



Section of 20x30" Sewer

**CITY OF SUPERIOR
SEWER PLAN**

Contract let Aug. 31, 1892
completed Nov. 18, 1892
Johnson & Dole, Contract or
H. E. Brooks & Frank Schwabach, Insp.
A. S. Cooper, City Engineer

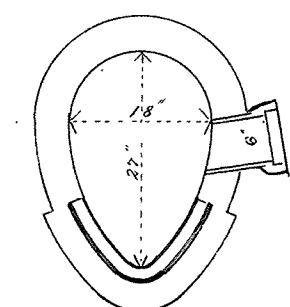


Section of 18x27" Sewer

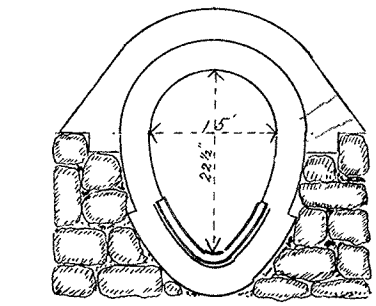

Section of 15x22 1/2" Sewer in Masonry

Scale: { Horizontal 60 ft. = 1 inch
Vertical 4 ft. = 1 inch
Section 2 ft. = 1 inch

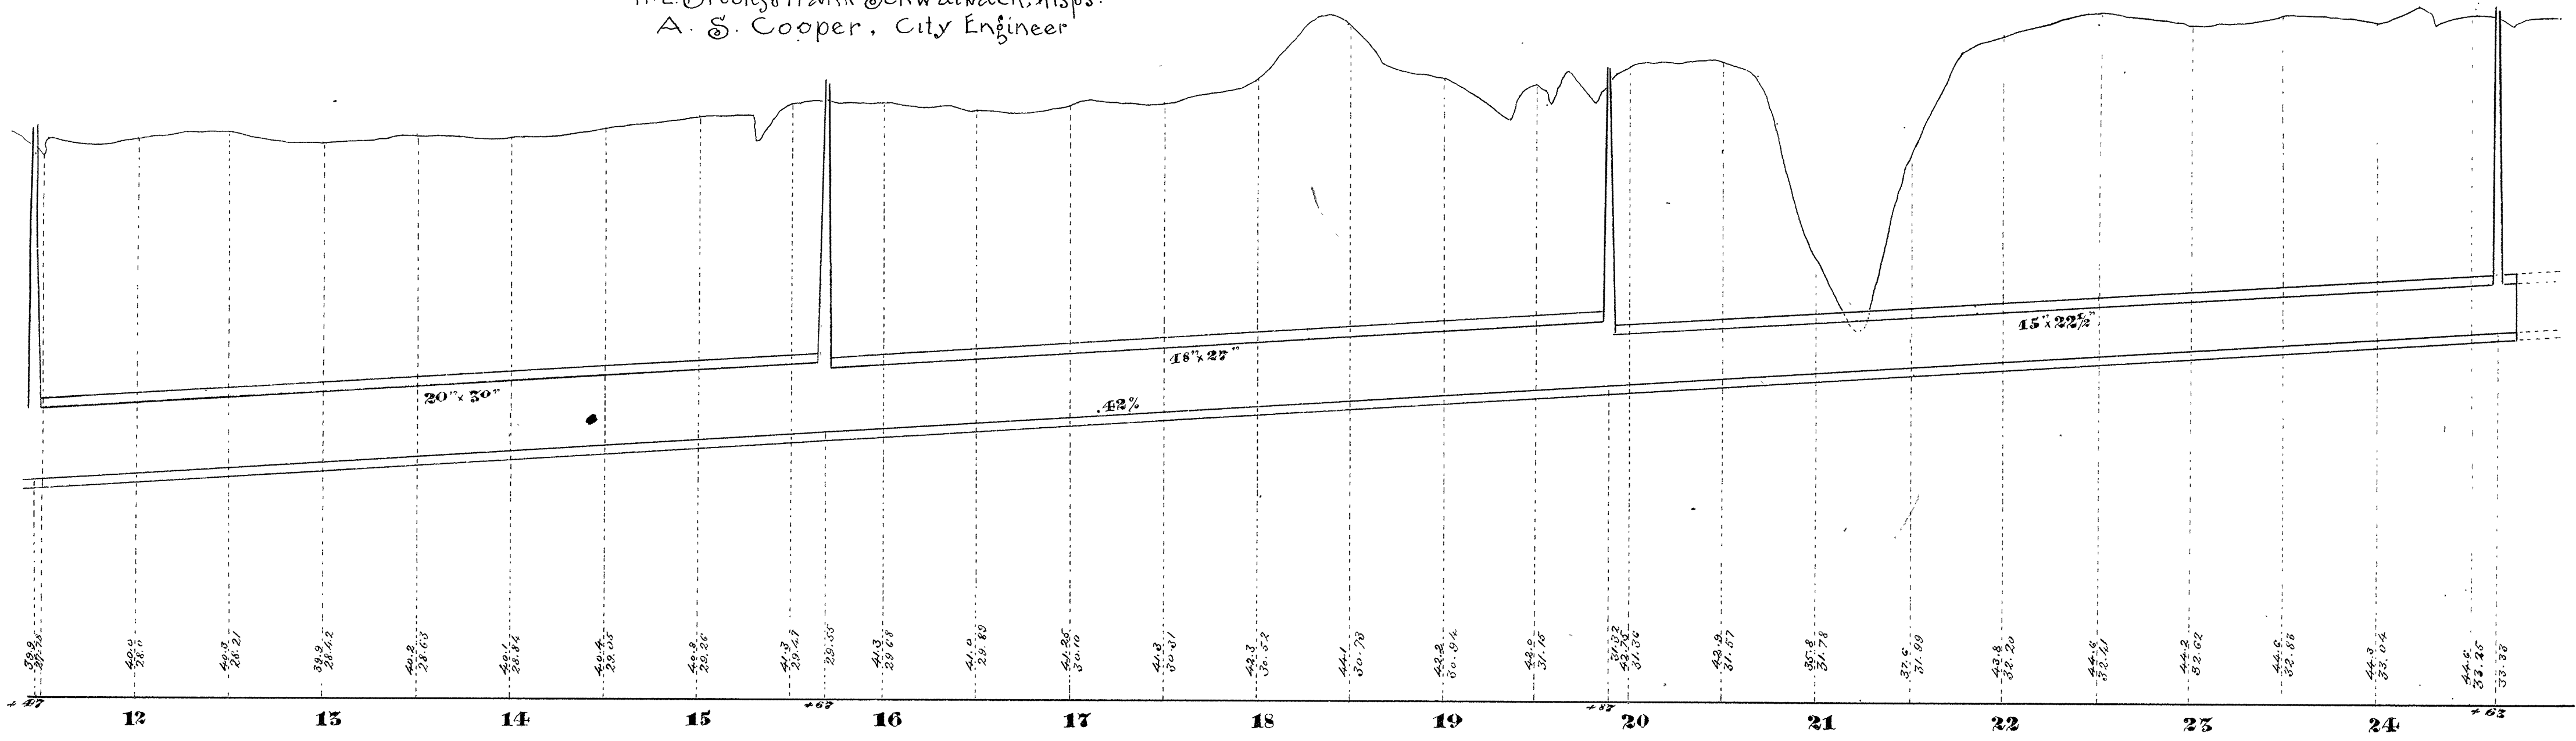

Base line 20' above Datum

12 15 14 15 16 17 18 19 20 21 22 23 24 25

Plan & Profile of Sewer in Alley betw. Iowa & Lackawanna Aves. from 18th St. to Ritchie Ave.