



**CITY OF SUPERIOR,
SEWER PLAN.**

Horizontal Scale : 1 inch = 60 feet.
Vertical Scale : 1 inch = 4 feet.

CONTRACT NO 1266
Contract let.....Oct. 12, 1910.
Contract completed.....Jan. 22, 1911.
Peterson & Holm.....Contractors.
Andrew Salin.....Inspector.
E. B. Banks.....City Engineer.

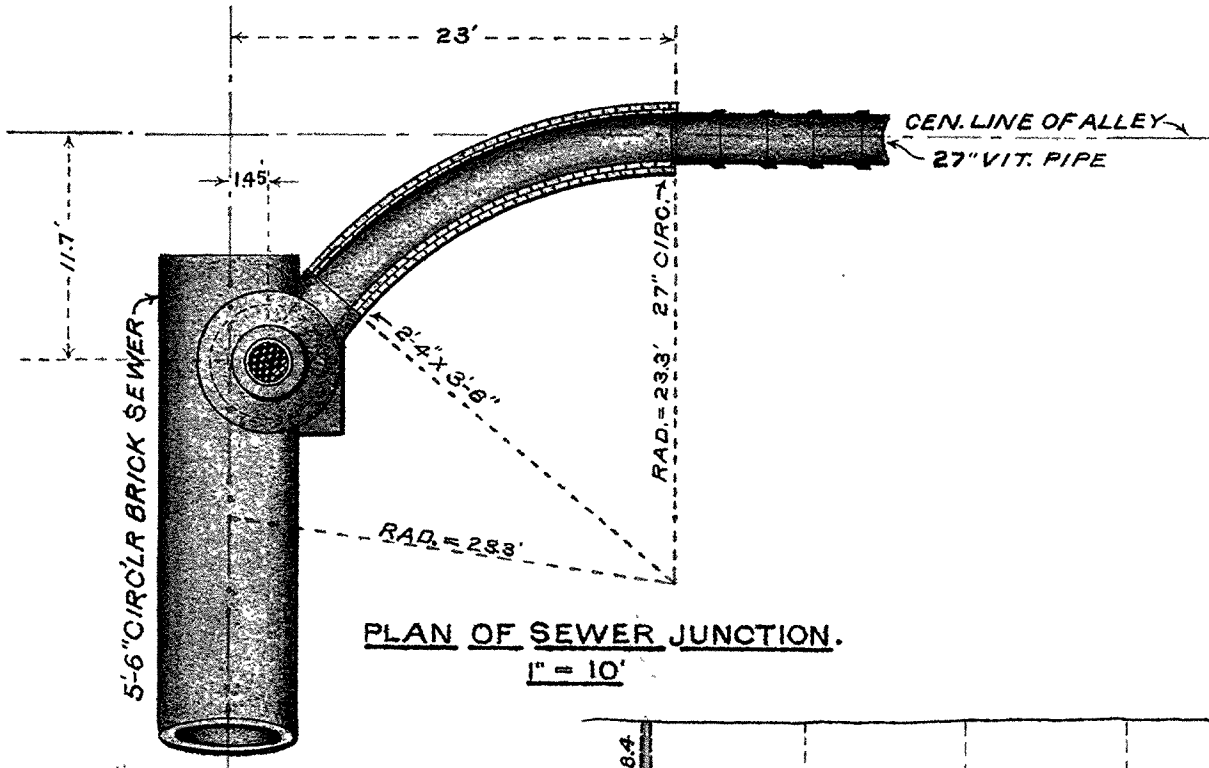

PLAN OF SEWER JUNCTION.
1" = 10'

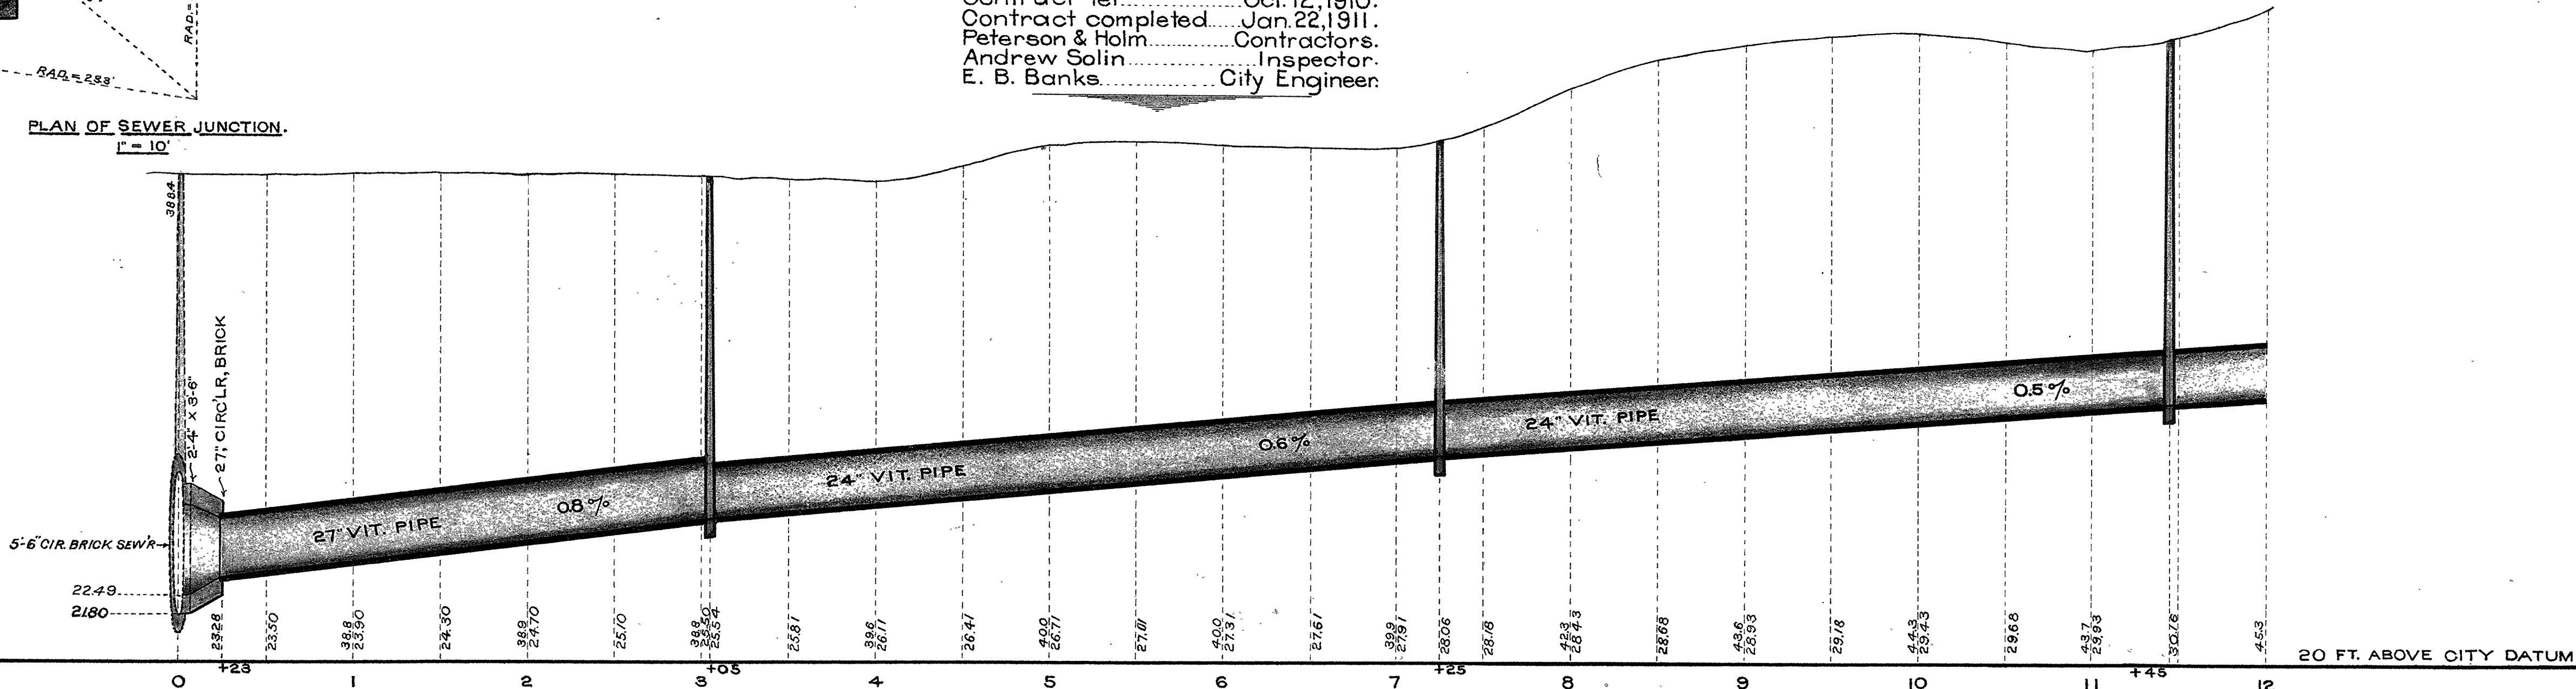

Sewer in the Alley between Susquehanna and Lackawanna Ave. from Alley sou. of Belknop St. to Twenty-first St.

6-19