



GARFIELD AVE.

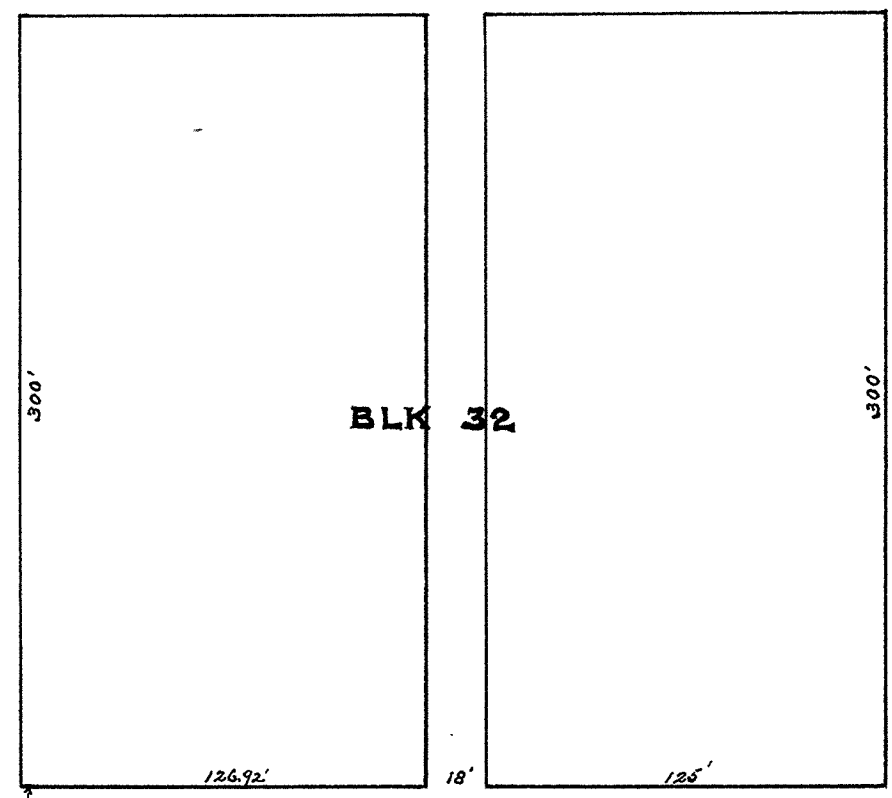

BLK 32


LOGAN

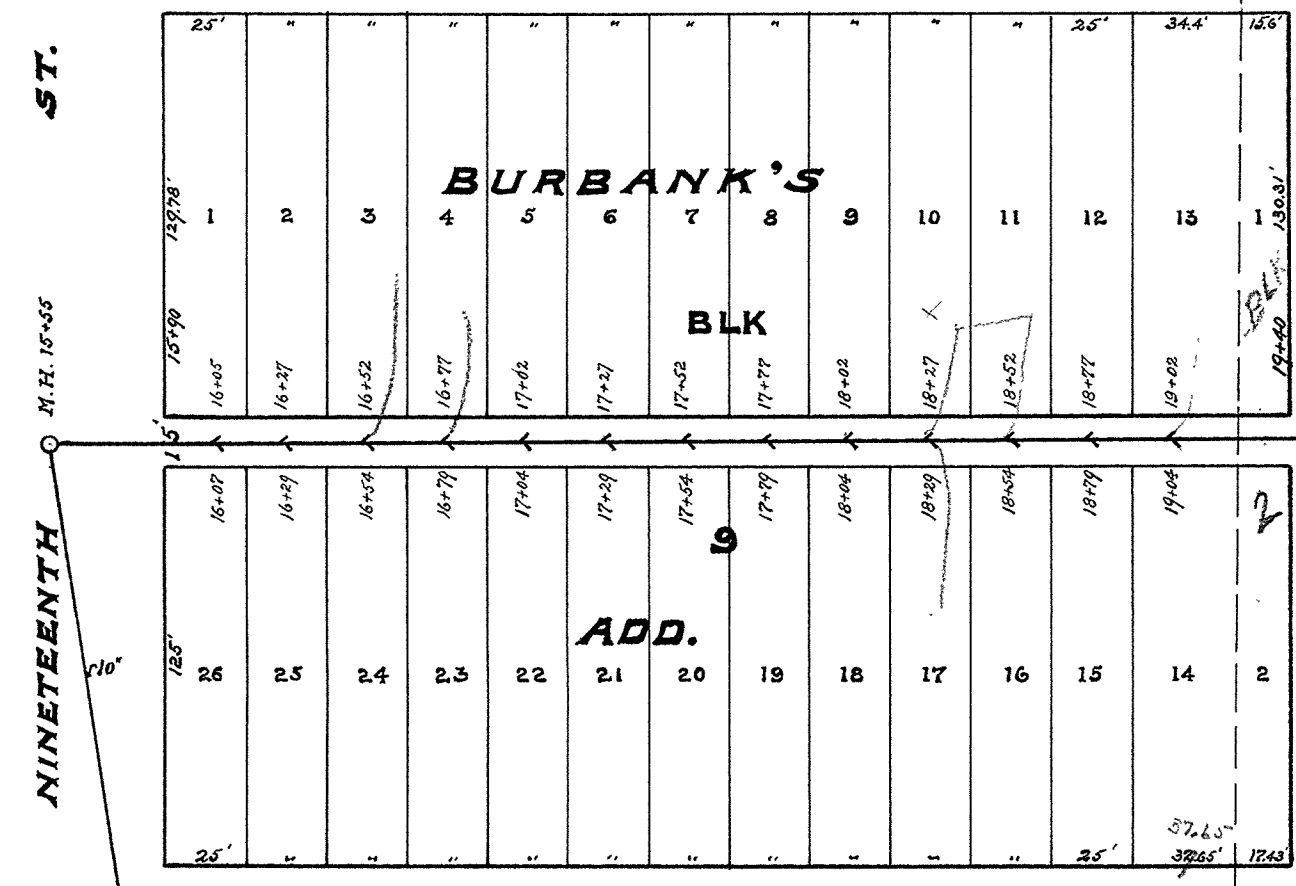

BURBANK'S

BLK

ADD.

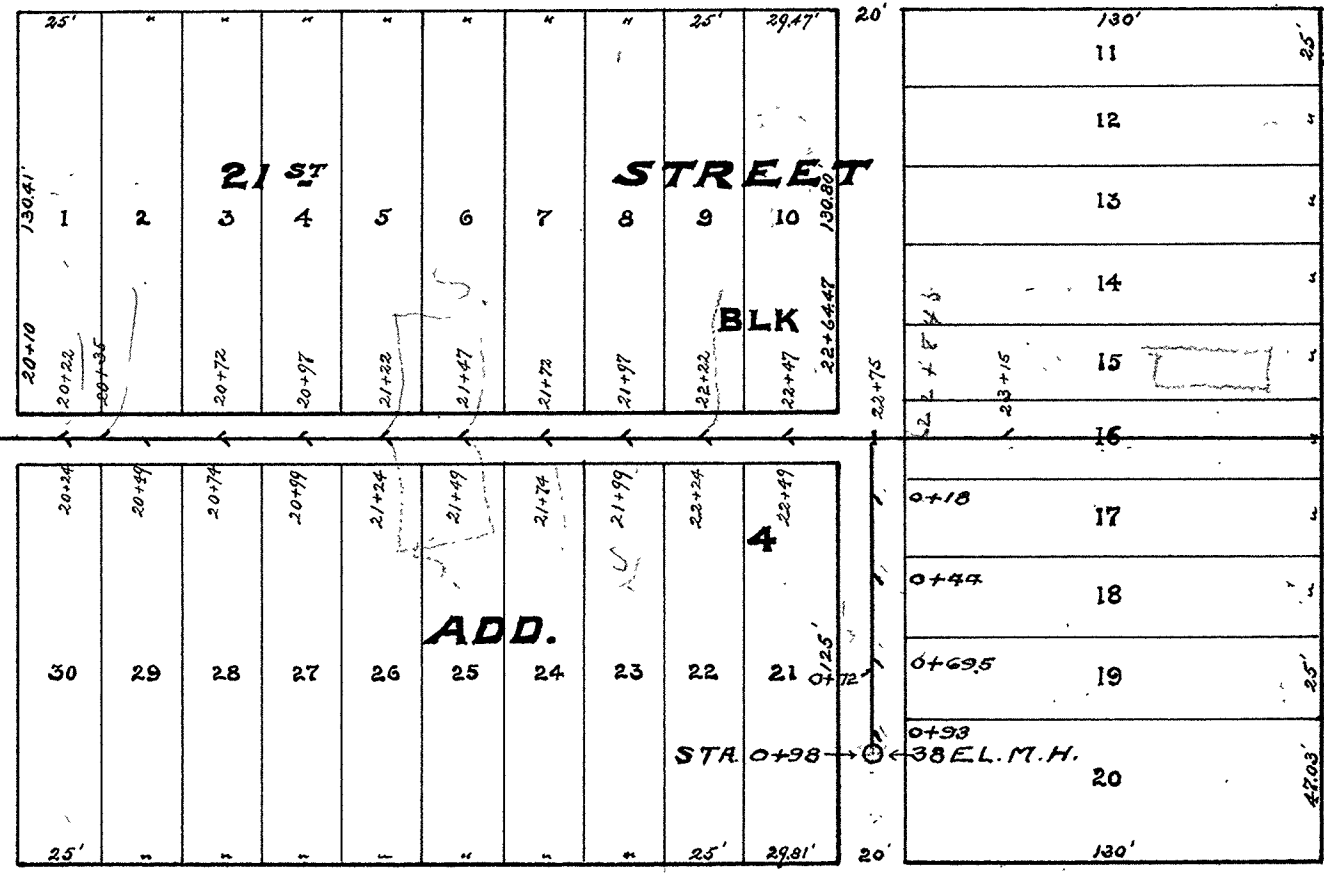

21 ST

ADD.

M.H.

AVE.


CITY OF SUPERIOR SEWER PLAN

Horizontal Scale: lin. = 60 ft.
Vertical Scale: lin. = 4 ft.

CONTRACT No 1352
Contract let _____ May 14, 13.
Contract completed _____ Dec. 31, 13.
S. A. Riches & Anderson _____ Contractors
John Monks _____ Inspector
E. B. Banks _____ City Engineer.

MARYLAND

AVE.

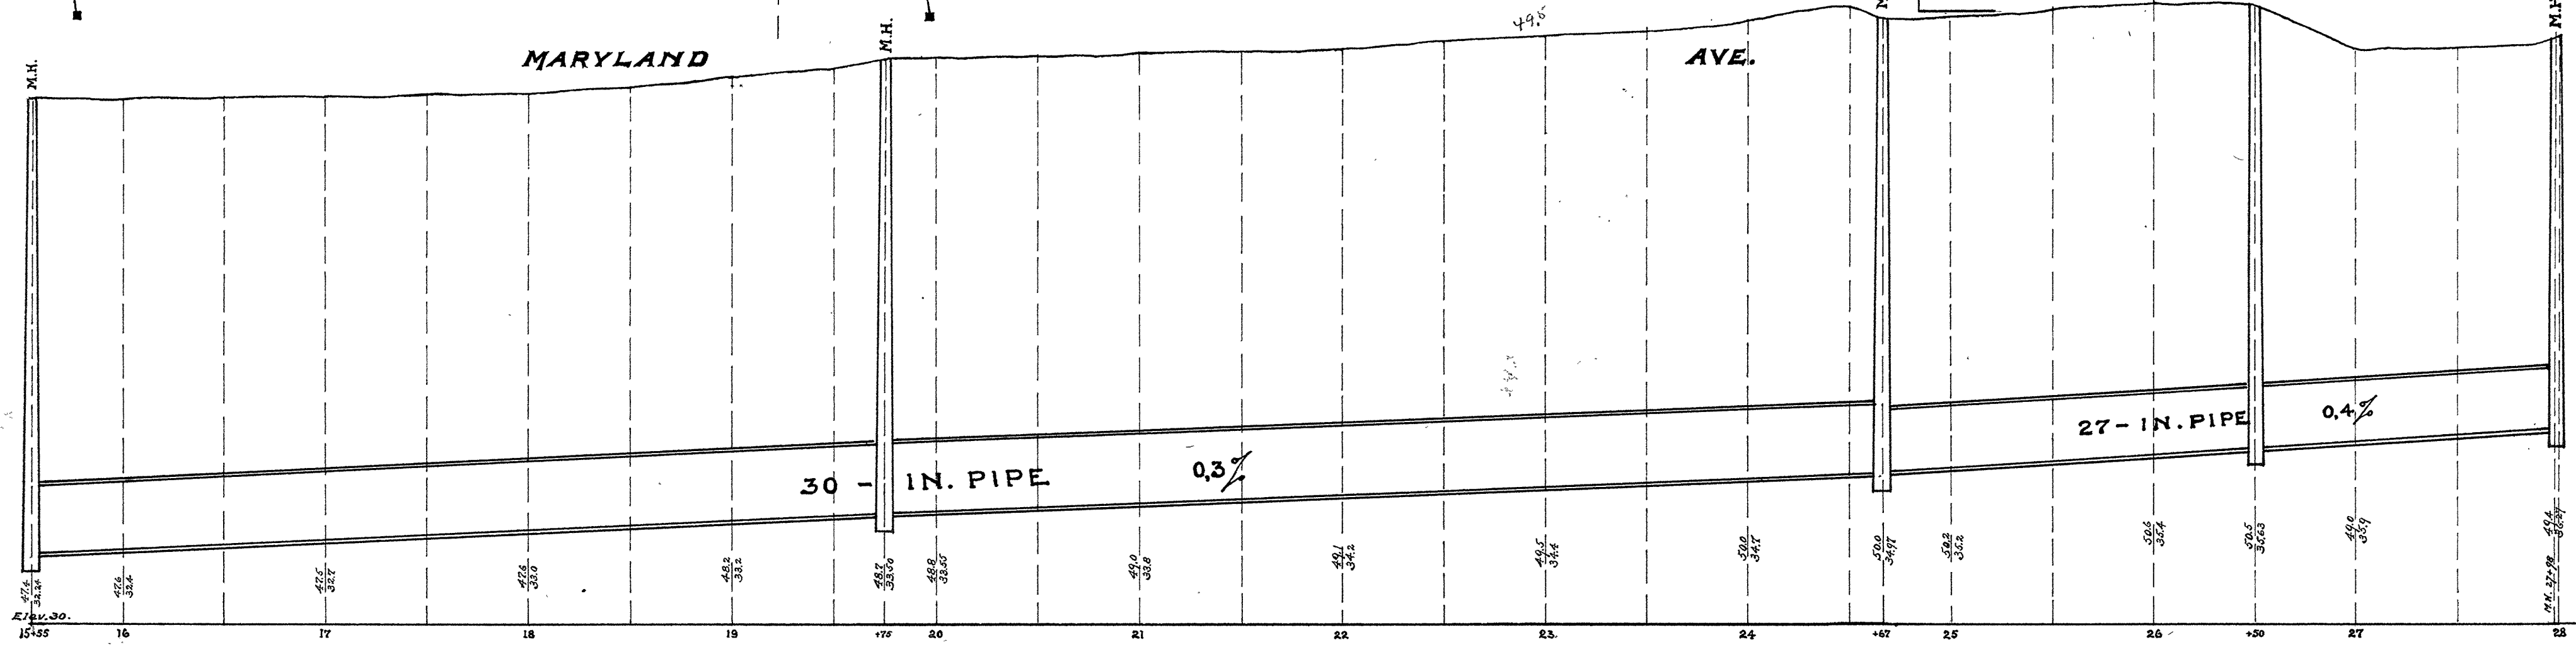

30 - IN. PIPE

0.3%

27 - IN. PIPE

0.4%