


**CITY OF SUPERIOR  
SEWER PLAN**

Horizontal Scale: 1 in. = 60 ft.  
Vertical Scale: 1 in. = 4 ft.

← CONTRACT No 1352 →

Contract let \_\_\_\_\_ May 14, 13.  
Contract completed \_\_\_\_\_ Dec. 31, 13.  
S.A. Riches & Anderson \_\_\_\_\_ Contractors  
Otto Smith \_\_\_\_\_ Inspector  
E.B. Banks \_\_\_\_\_ City Engineer.

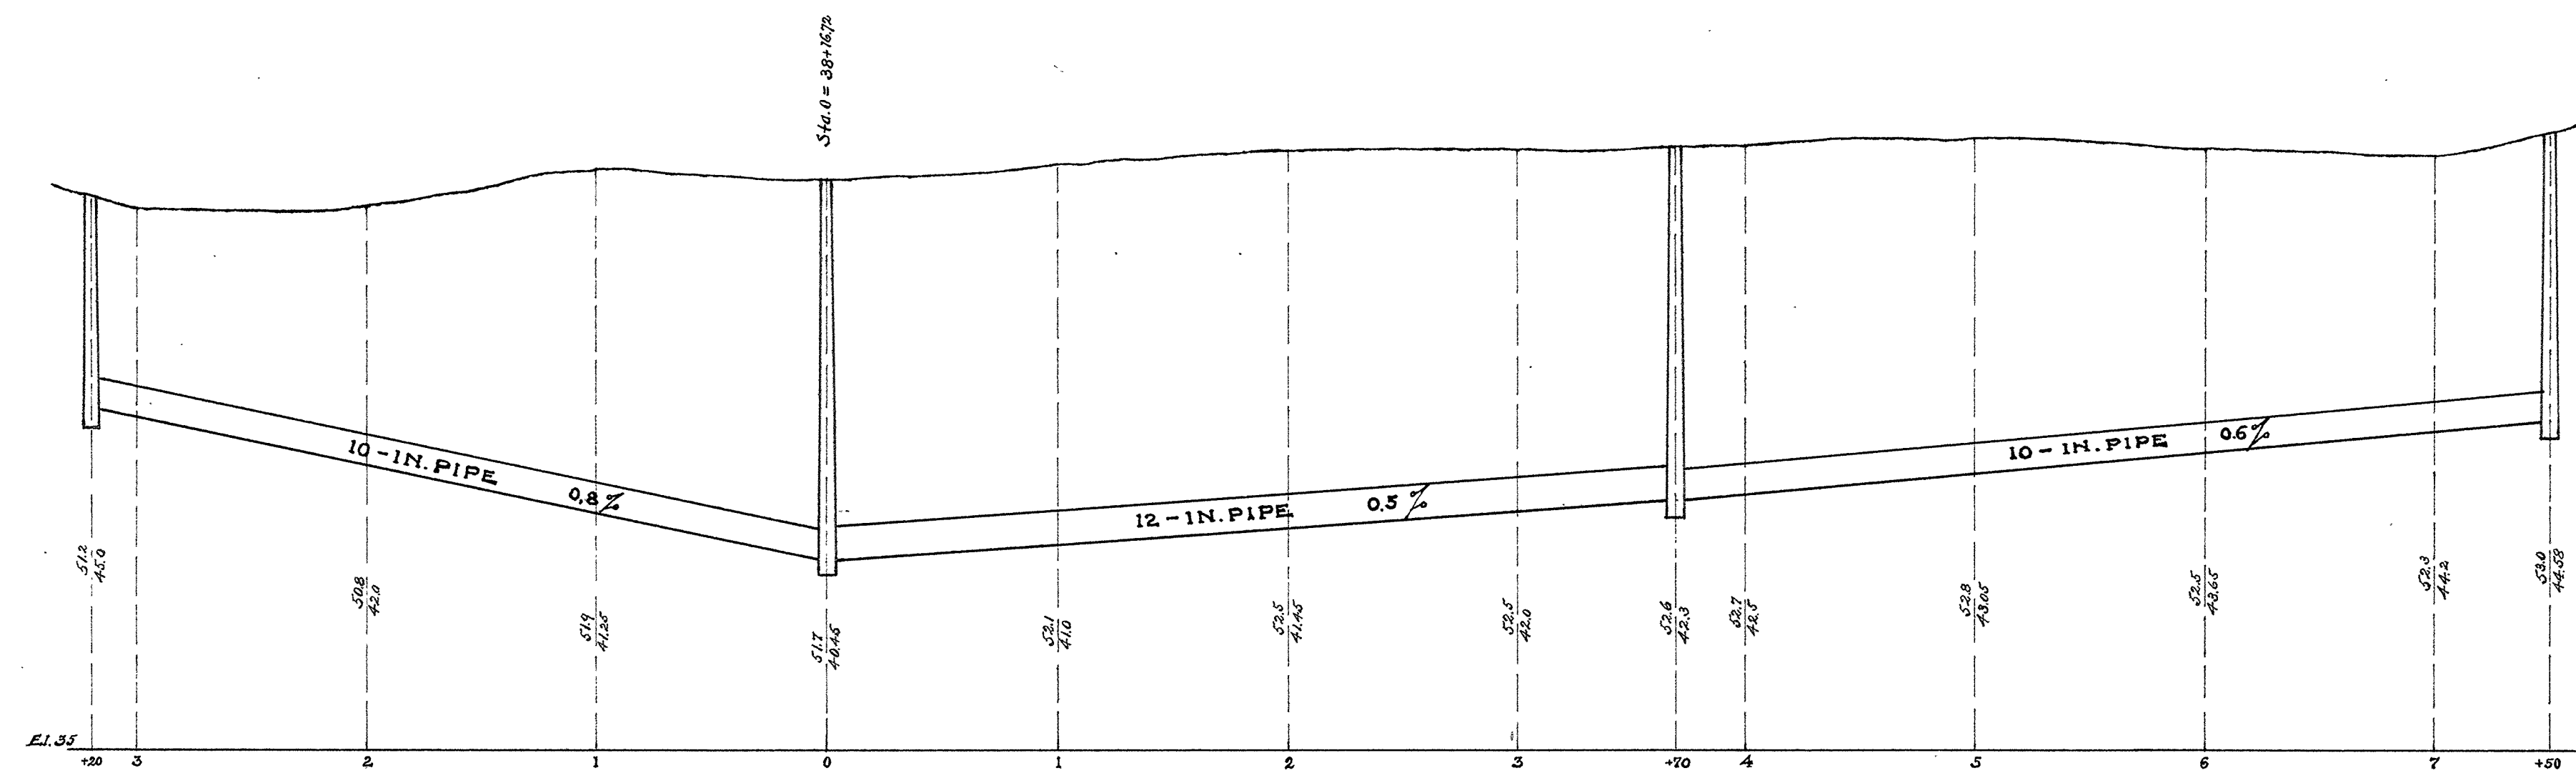

6-26