
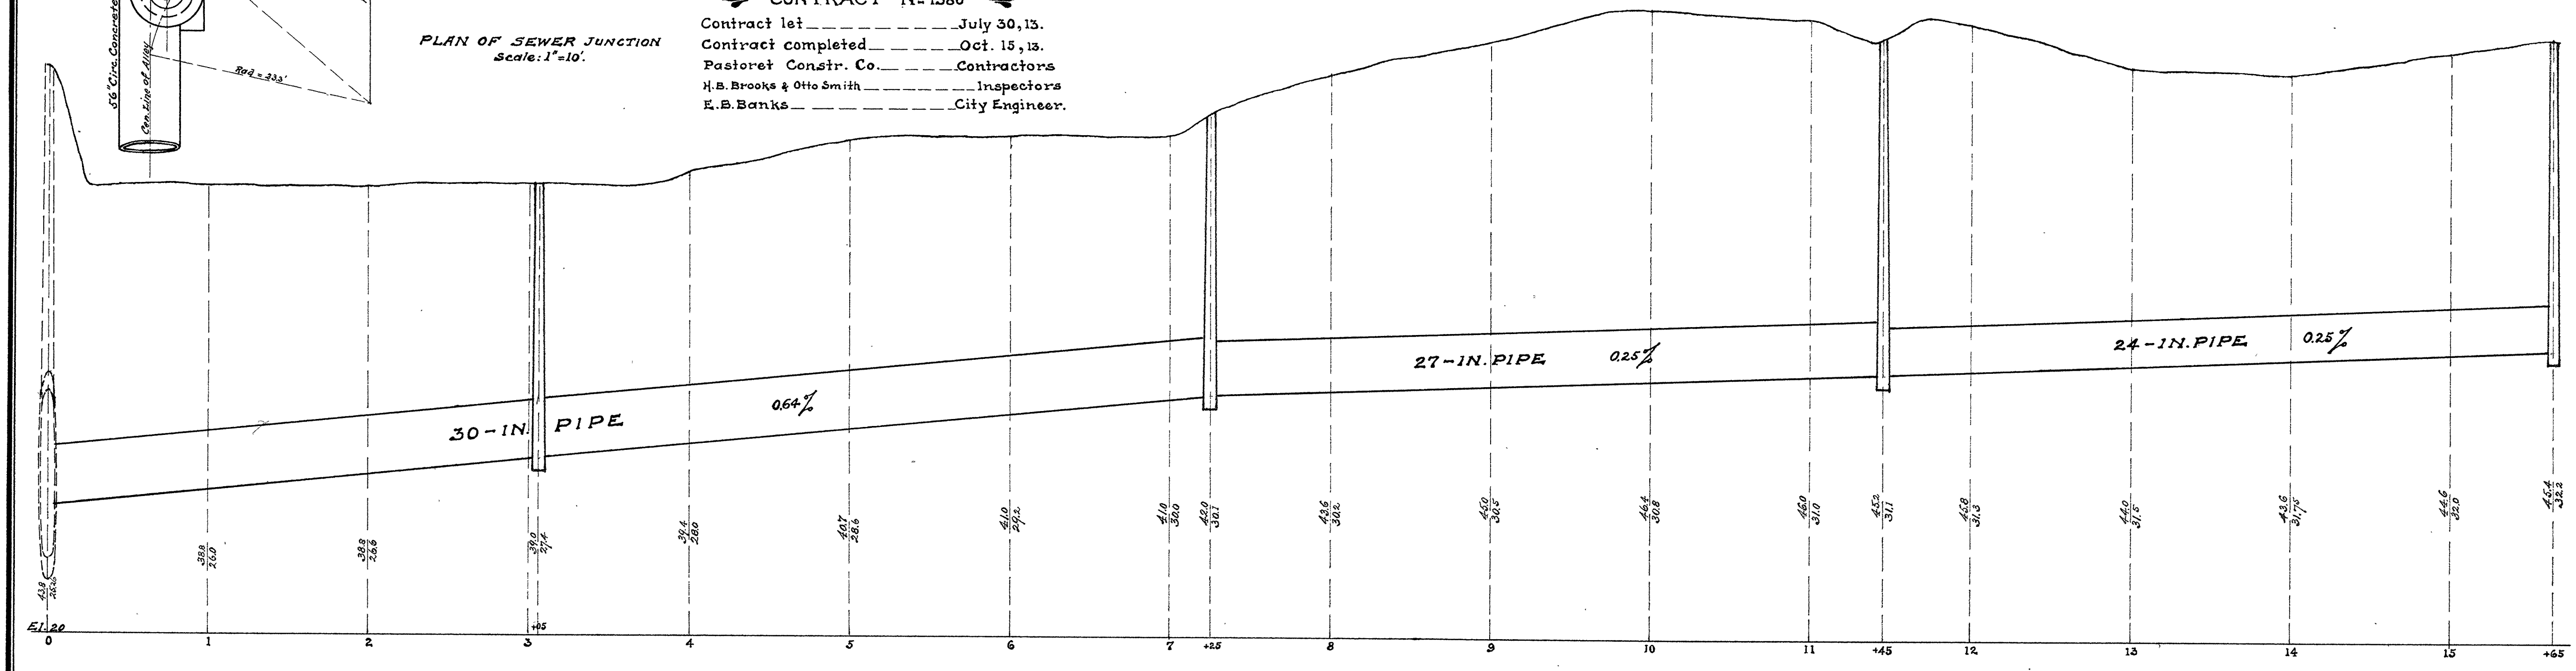


**CITY OF SUPERIOR  
SEWER PLAN**

Horizontal Scale: lin.=60 ft.  
Vertical Scale: lin.=4 ft.

CONTRACT N<sup>o</sup> 1380

Contract let July 30, 13.  
Contract completed Oct. 15, 13.  
Pastorel Constr. Co. Contractors  
H. B. Brooks & Otto Smith Inspectors  
E. B. Banks City Engineer.

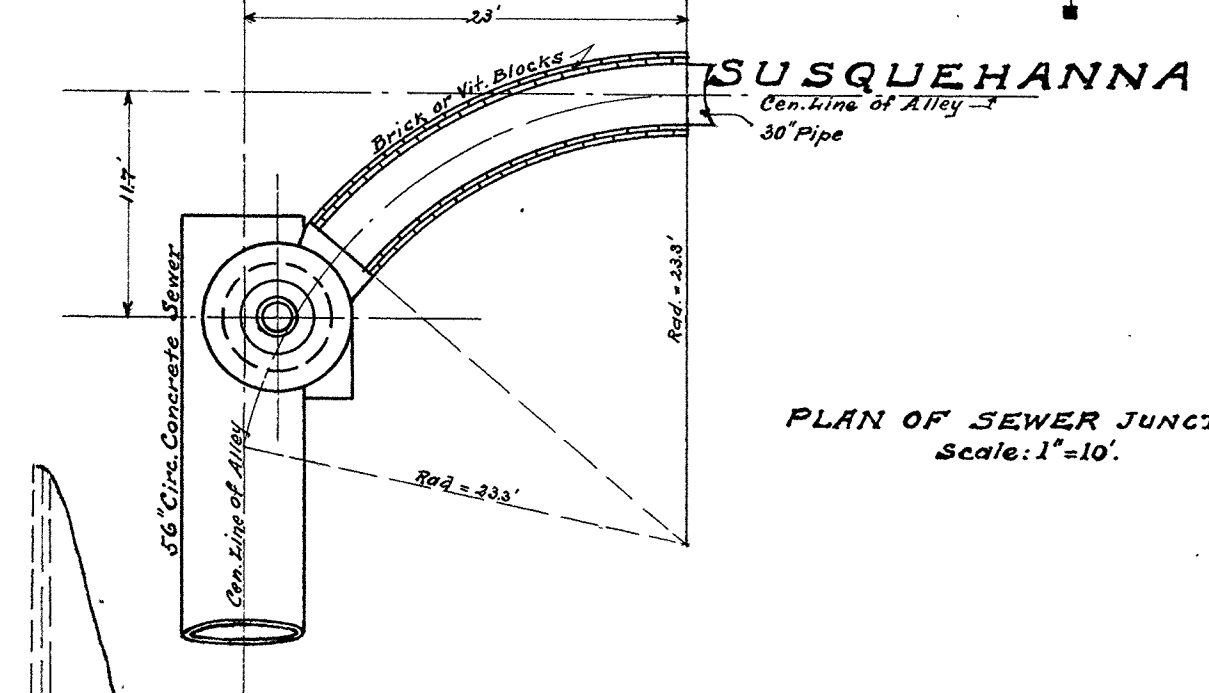

6-27