


Horizontal Scale: 1 in = 80 ft.  
 Vertical Scale: 1 in = 4 ft.  
 CONTRACT No 1514  
 Contract let May 4th 1916  
 Contract completed November 20th 1916  
Riches & Son Contractor  
J. B. Graham Inspector  
E. B. Banks City Engineer.  
 RICHES CEMENT PIPE USED

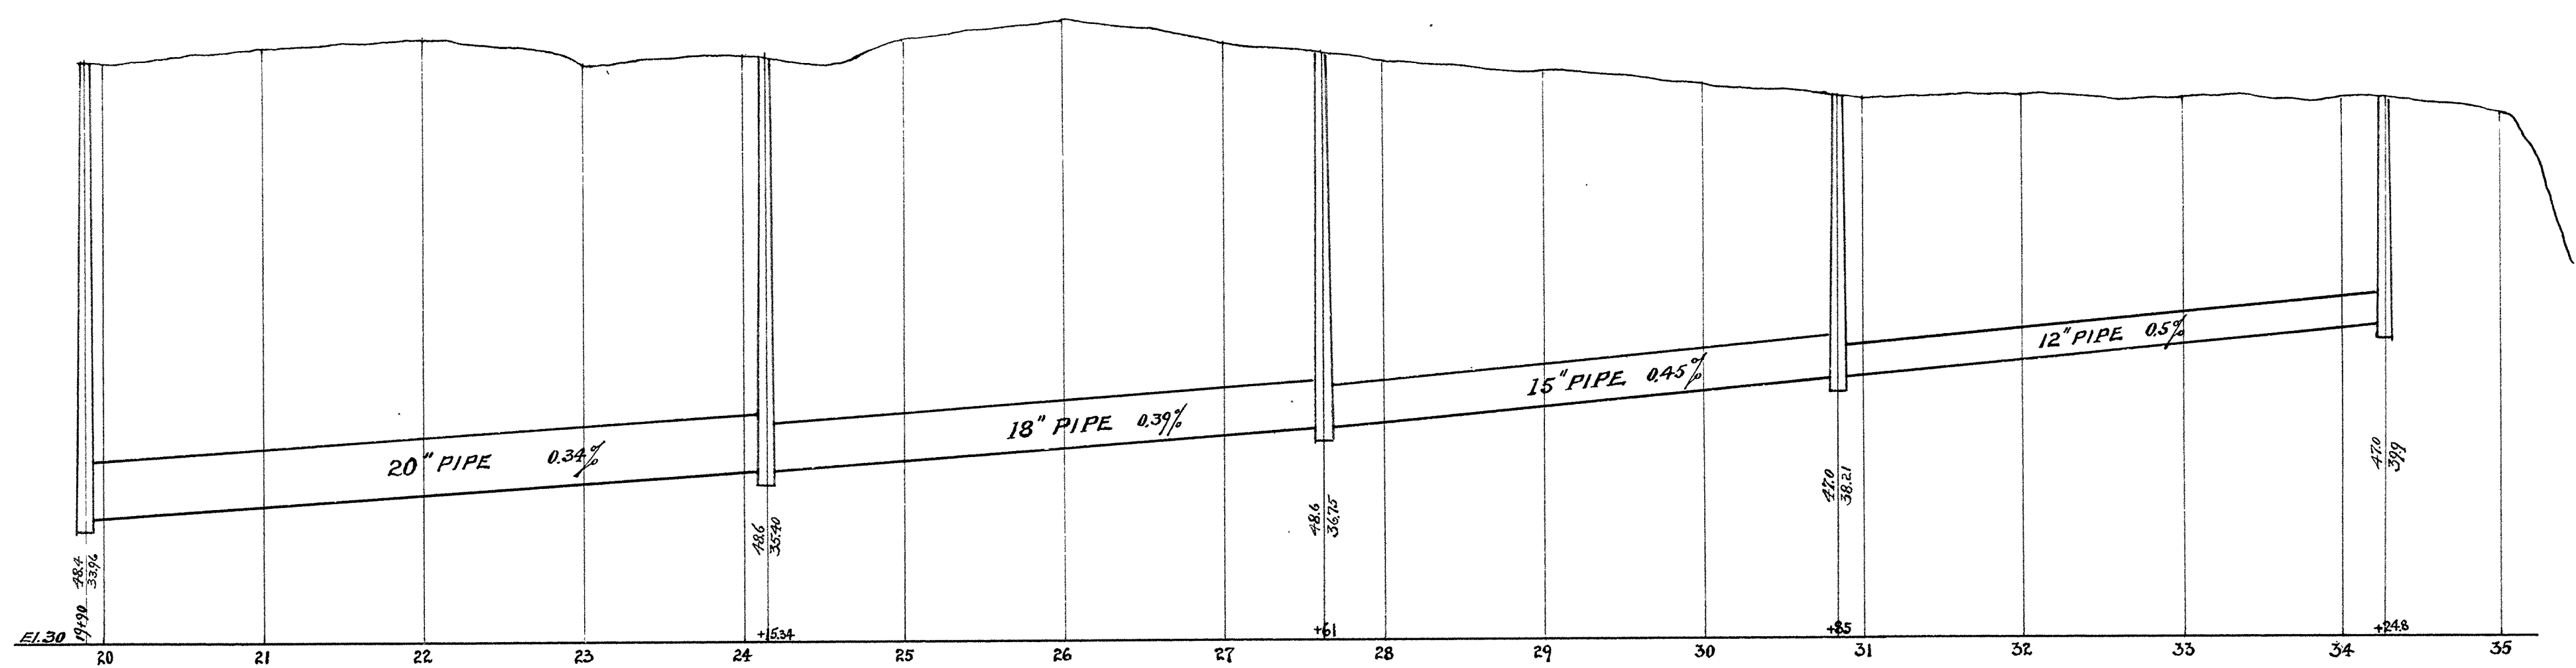

6-34