


HORIZONTAL SCALE 1" = 80'  
 VERTICAL SCALE 1" = 6'  
 CONTRACT COMPLETED JAN. 25, 1918  
 MAGNUS PETERSON - CONTRACTOR  
 E. B. BANKS - CITY ENGINEER  
 0+11.6 TO 7+11.5 L.H.

1979 EXTENSION: 7+11.5 - 14+55 RON GUSTAFSON

IOWA AVE.

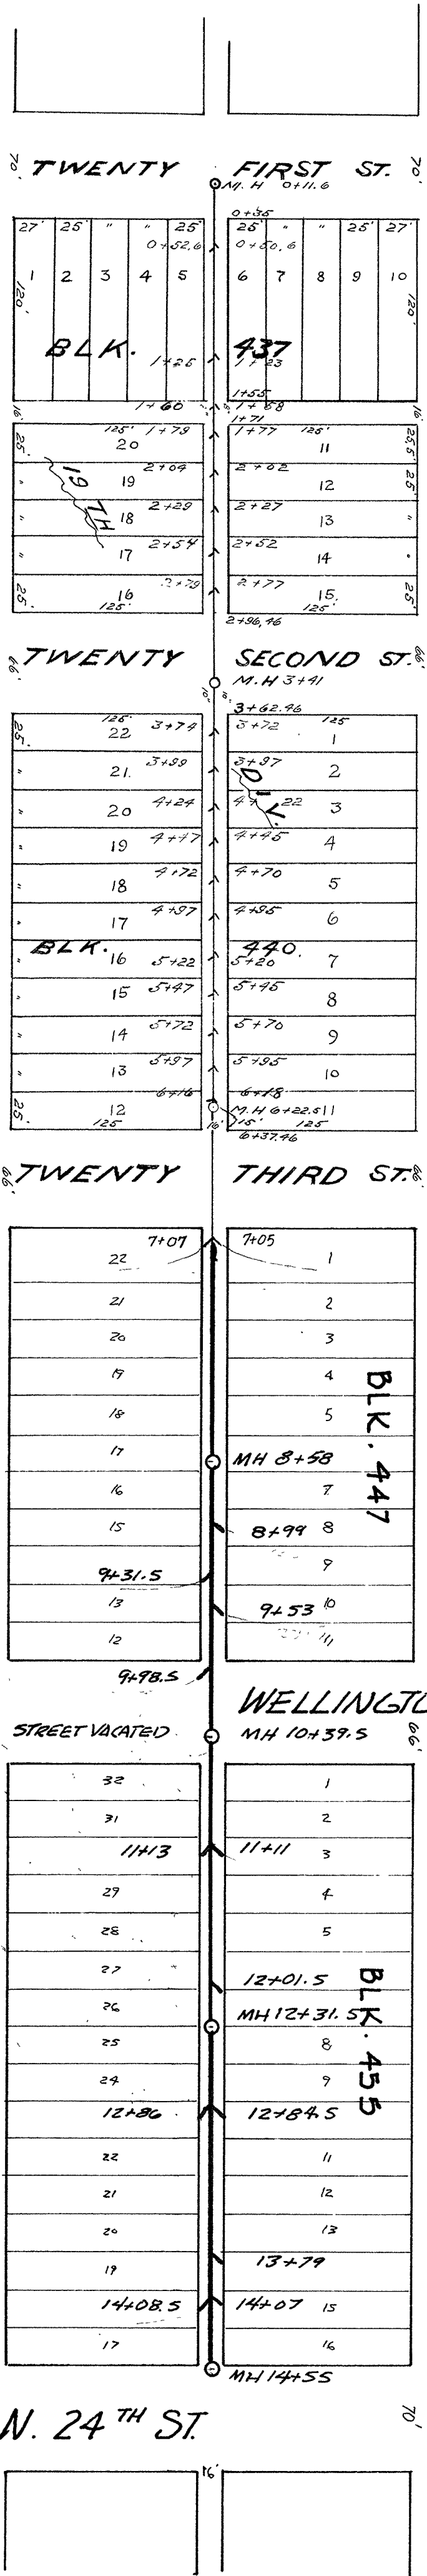

LACKAWANNA AVE.