
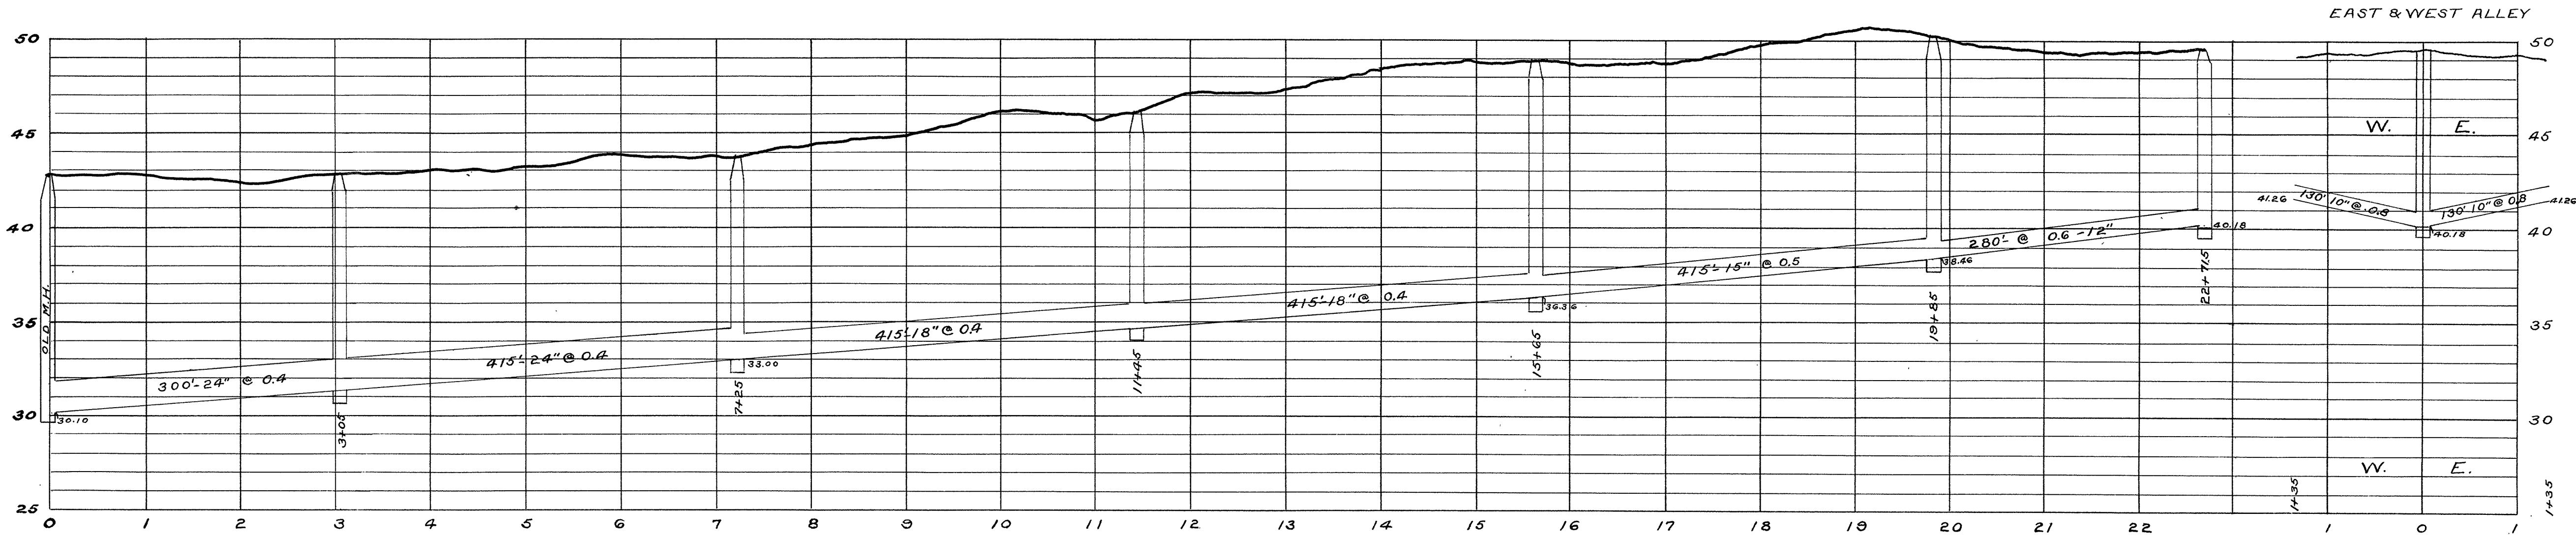


MAP AND PROFILE  
 SHOWING SEWER IN THE ALLEY BET.  
 GARFIELD AND LOGAN AVENUES FROM  
 ALLEY SO. OF BELKNAP TO ALLEY NO. OF  
 21<sup>ST</sup> ST. AND IN ALLEY NO. OF 21<sup>ST</sup> FROM  
 GARFIELD TO LOGAN

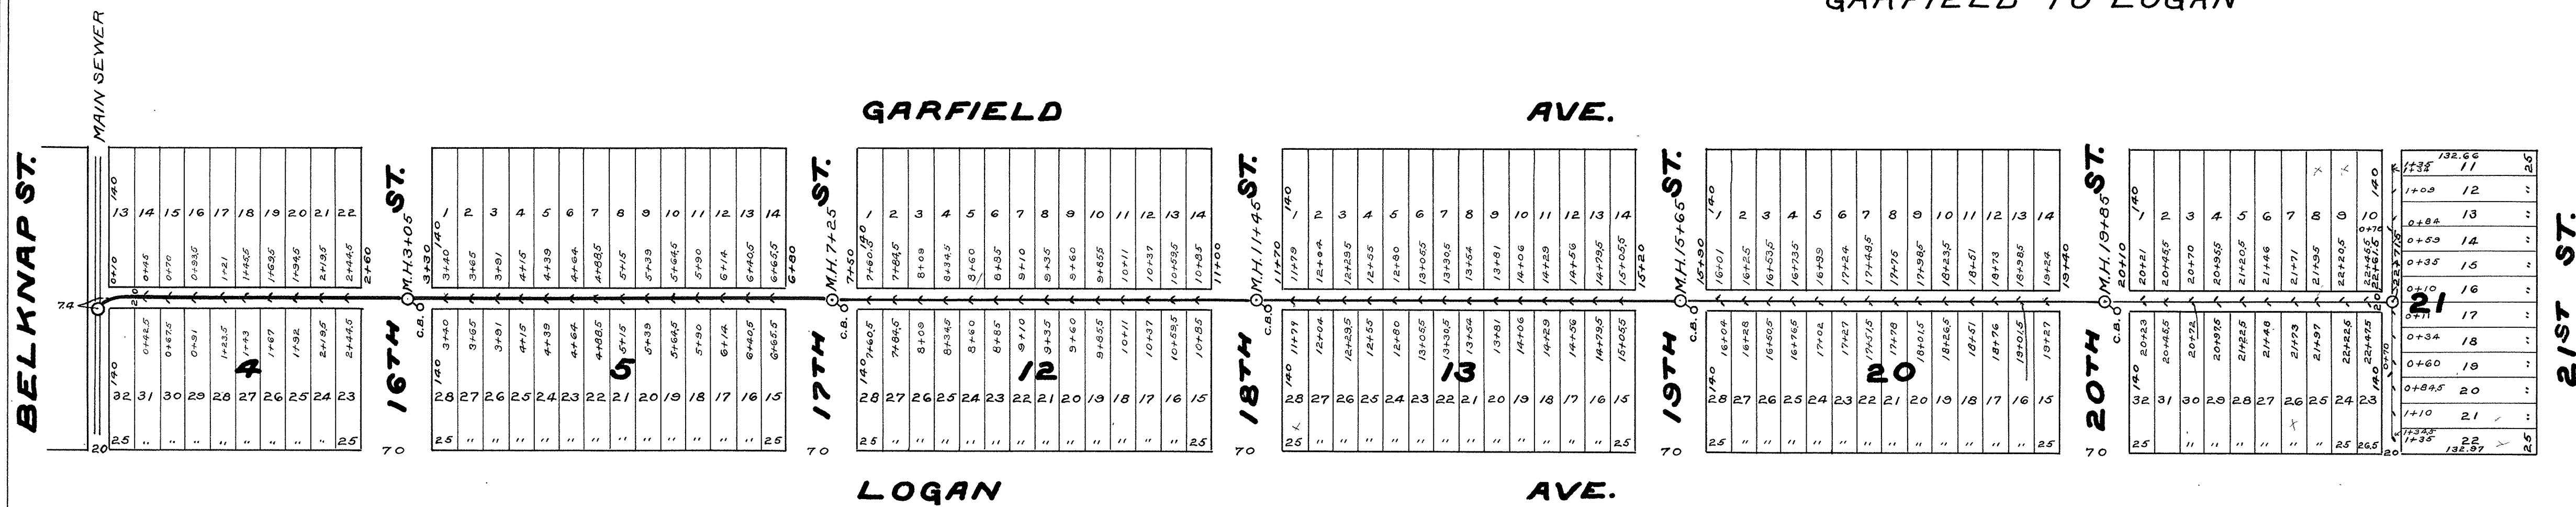

HORIZONTAL SCALE: 1"=100 FT.  
 VERTICAL SCALE: 1"= 5 FT.  
 CONTRACT No. 1649  
 CONTRACT LET JAN. 25<sup>TH</sup> 1922  
 CONTRACT COMPLETED MAY 1922  
 CONTRACTOR CITY OF SUPERIOR  
 INSPECTOR E.M. STEFFENSON  
 CITY ENGINEER E.B. BANKS