


PROSPECT

CITY OF SUPERIOR SEWER PLAN

HORIZONTAL SCALE 1" = 60'
 VERTICAL SCALE 1" = 4'
 W. P. A. F. BIRCH INSPECTOR
 JOB STARTED MARCH, 1938
 COMPLETED JUNE, 1938
 T. M. BASTERASH CITY ENGINEER

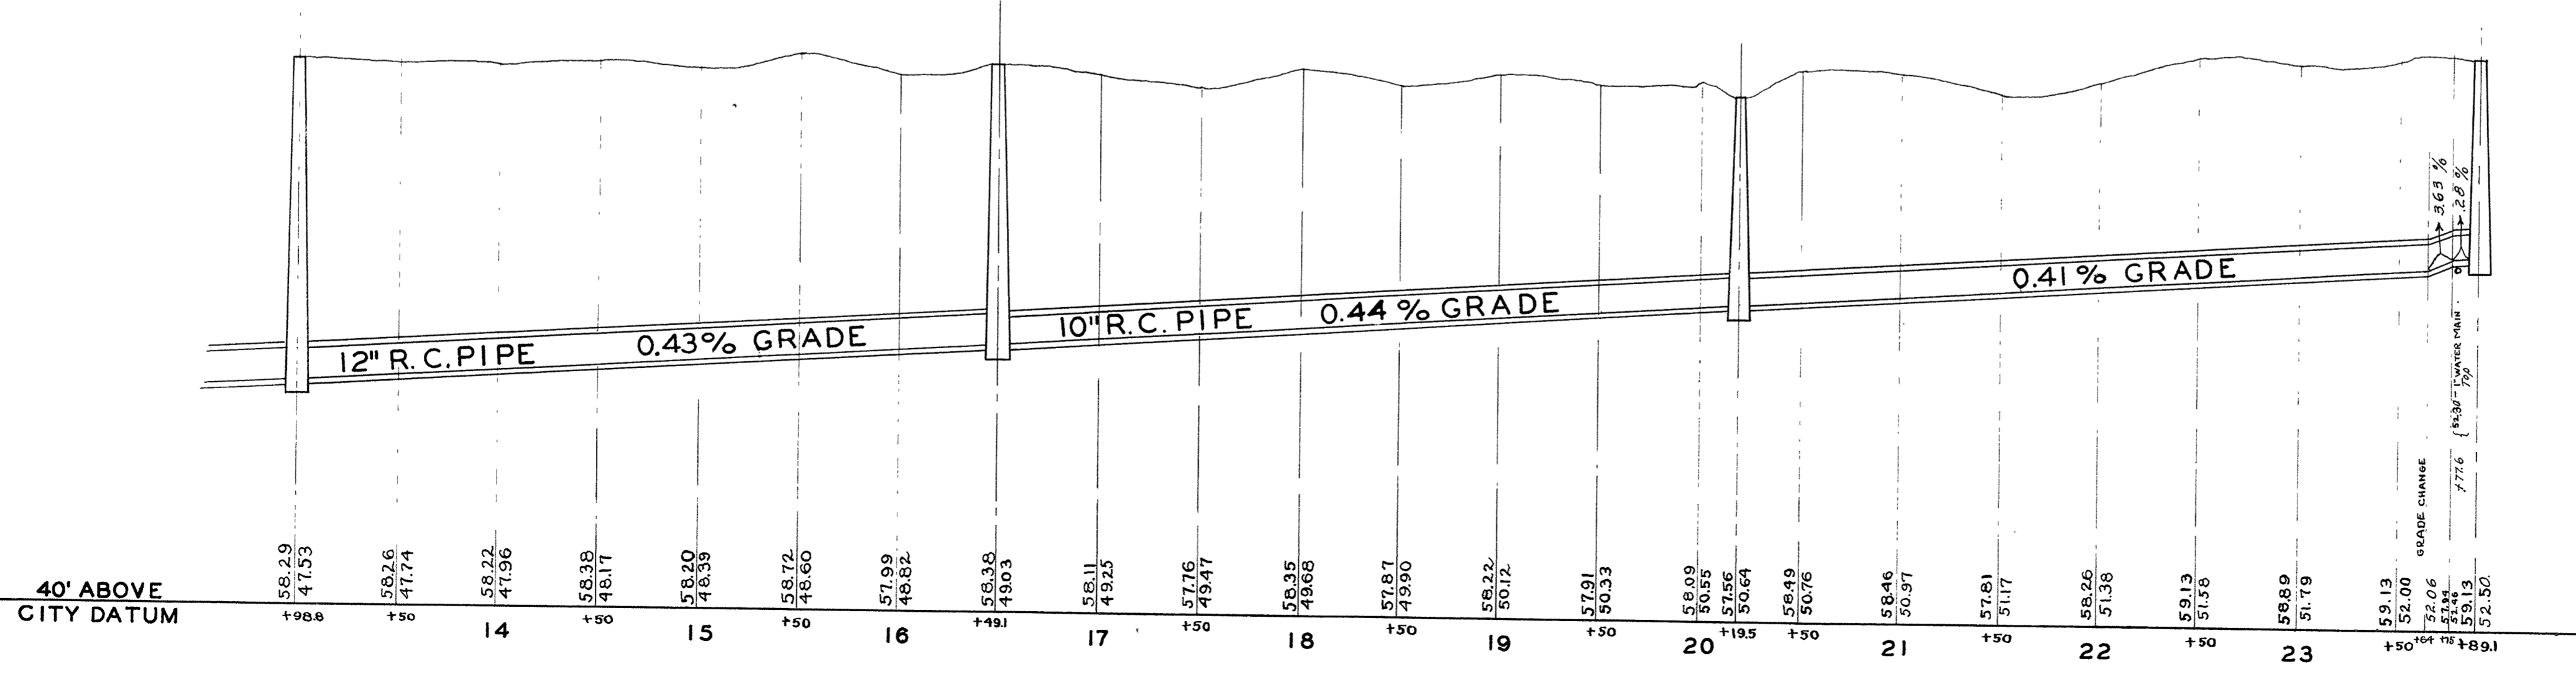

6-44A 6-44A