



TWENTYEIGHTH

S T.


WASHINGTON AVE.

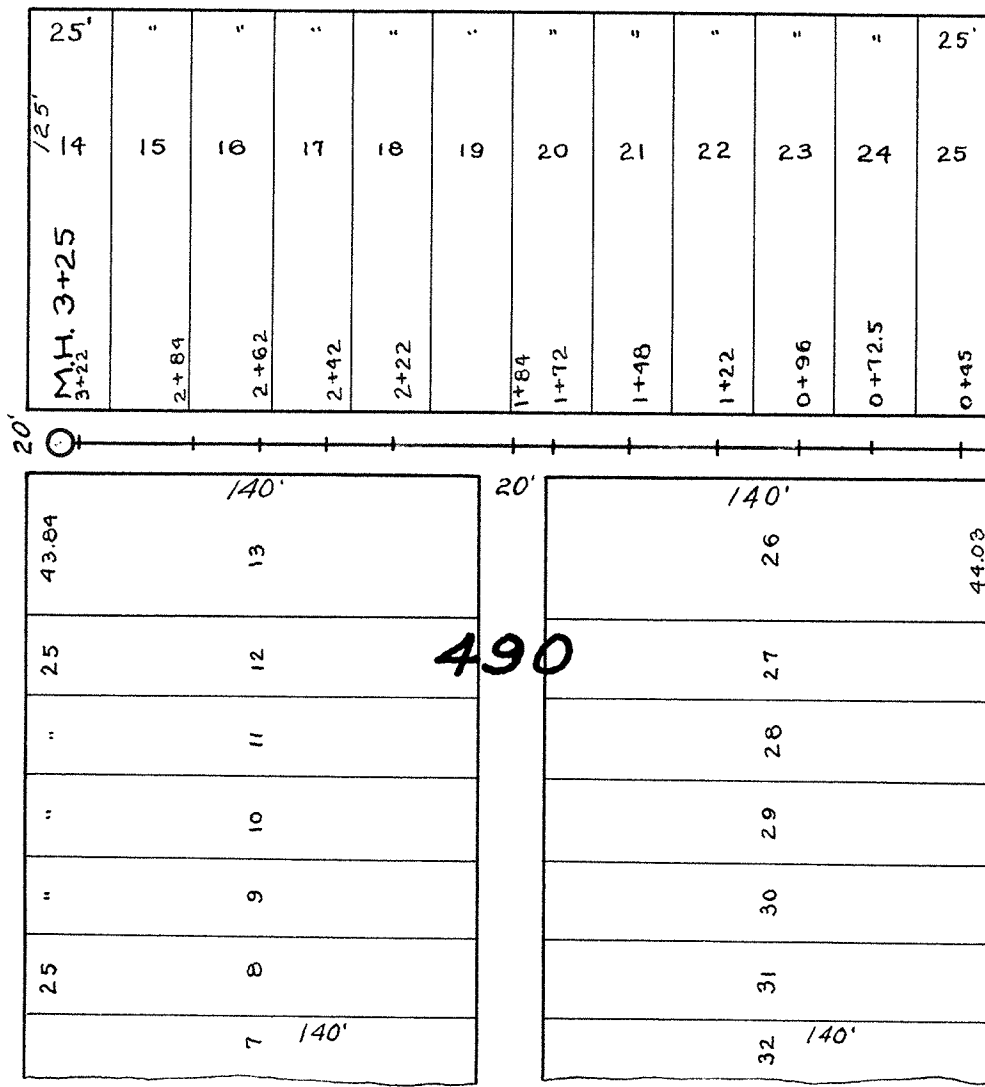

GARFIELD AVE.

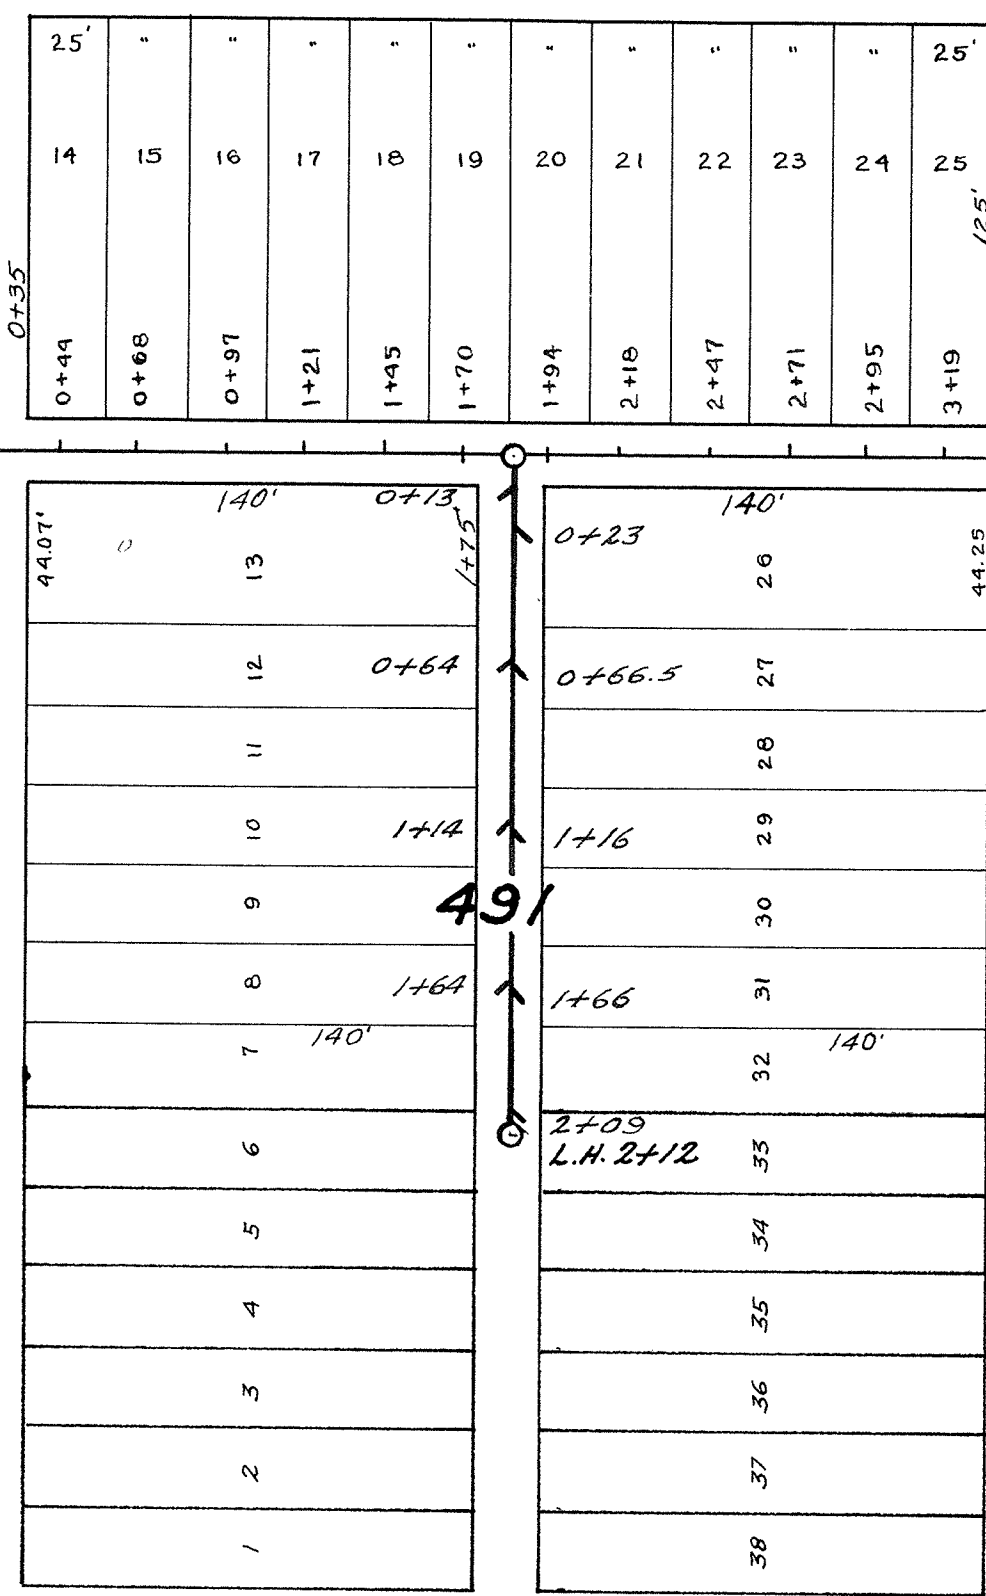

LOGAN AVE.

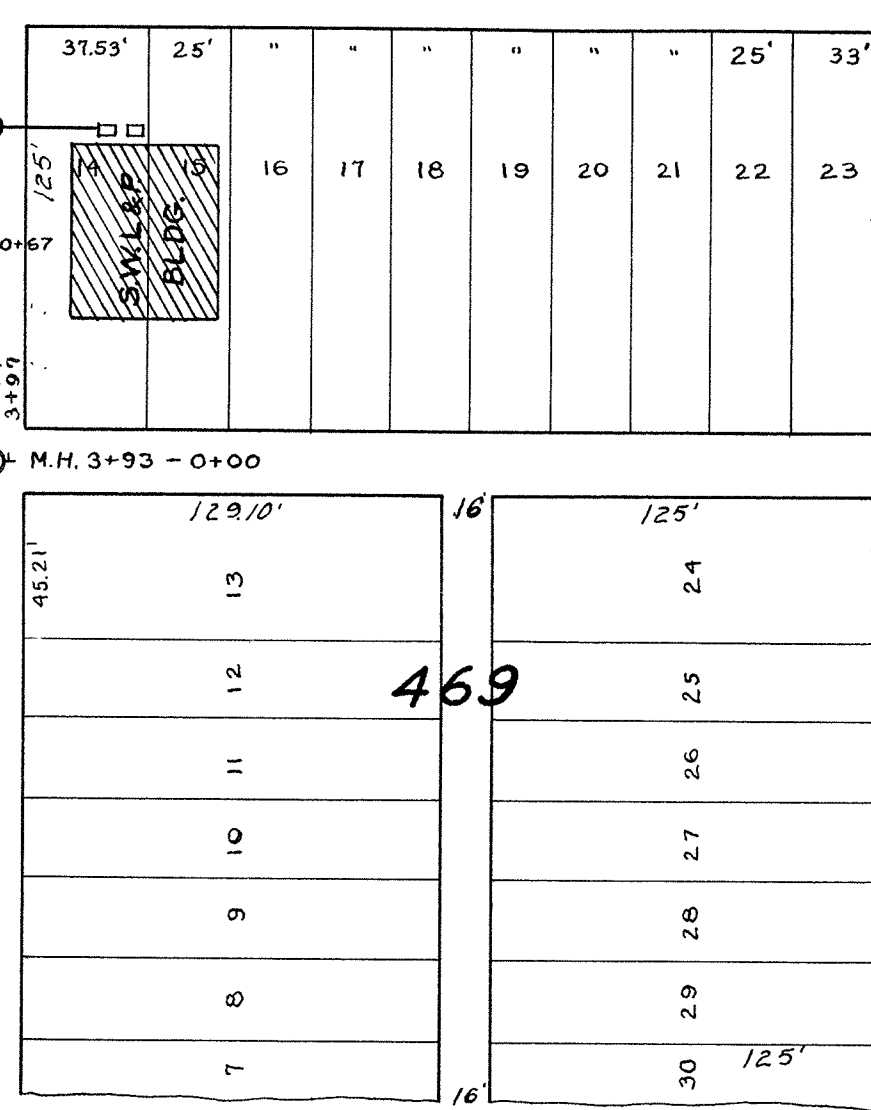


MARYLAND AVE.

CITY OF SUPERIOR SEWER PLAN

HORIZONTAL SCALE 1"=60'
VERTICAL SCALE 1"=4'

W.P.A. LABOR
F. BIRCH INSPECTOR
JOB STARTED MARCH, 1938
COMPLETED JUNE, 1938
T. M. BASTERASH CITY ENGINEER

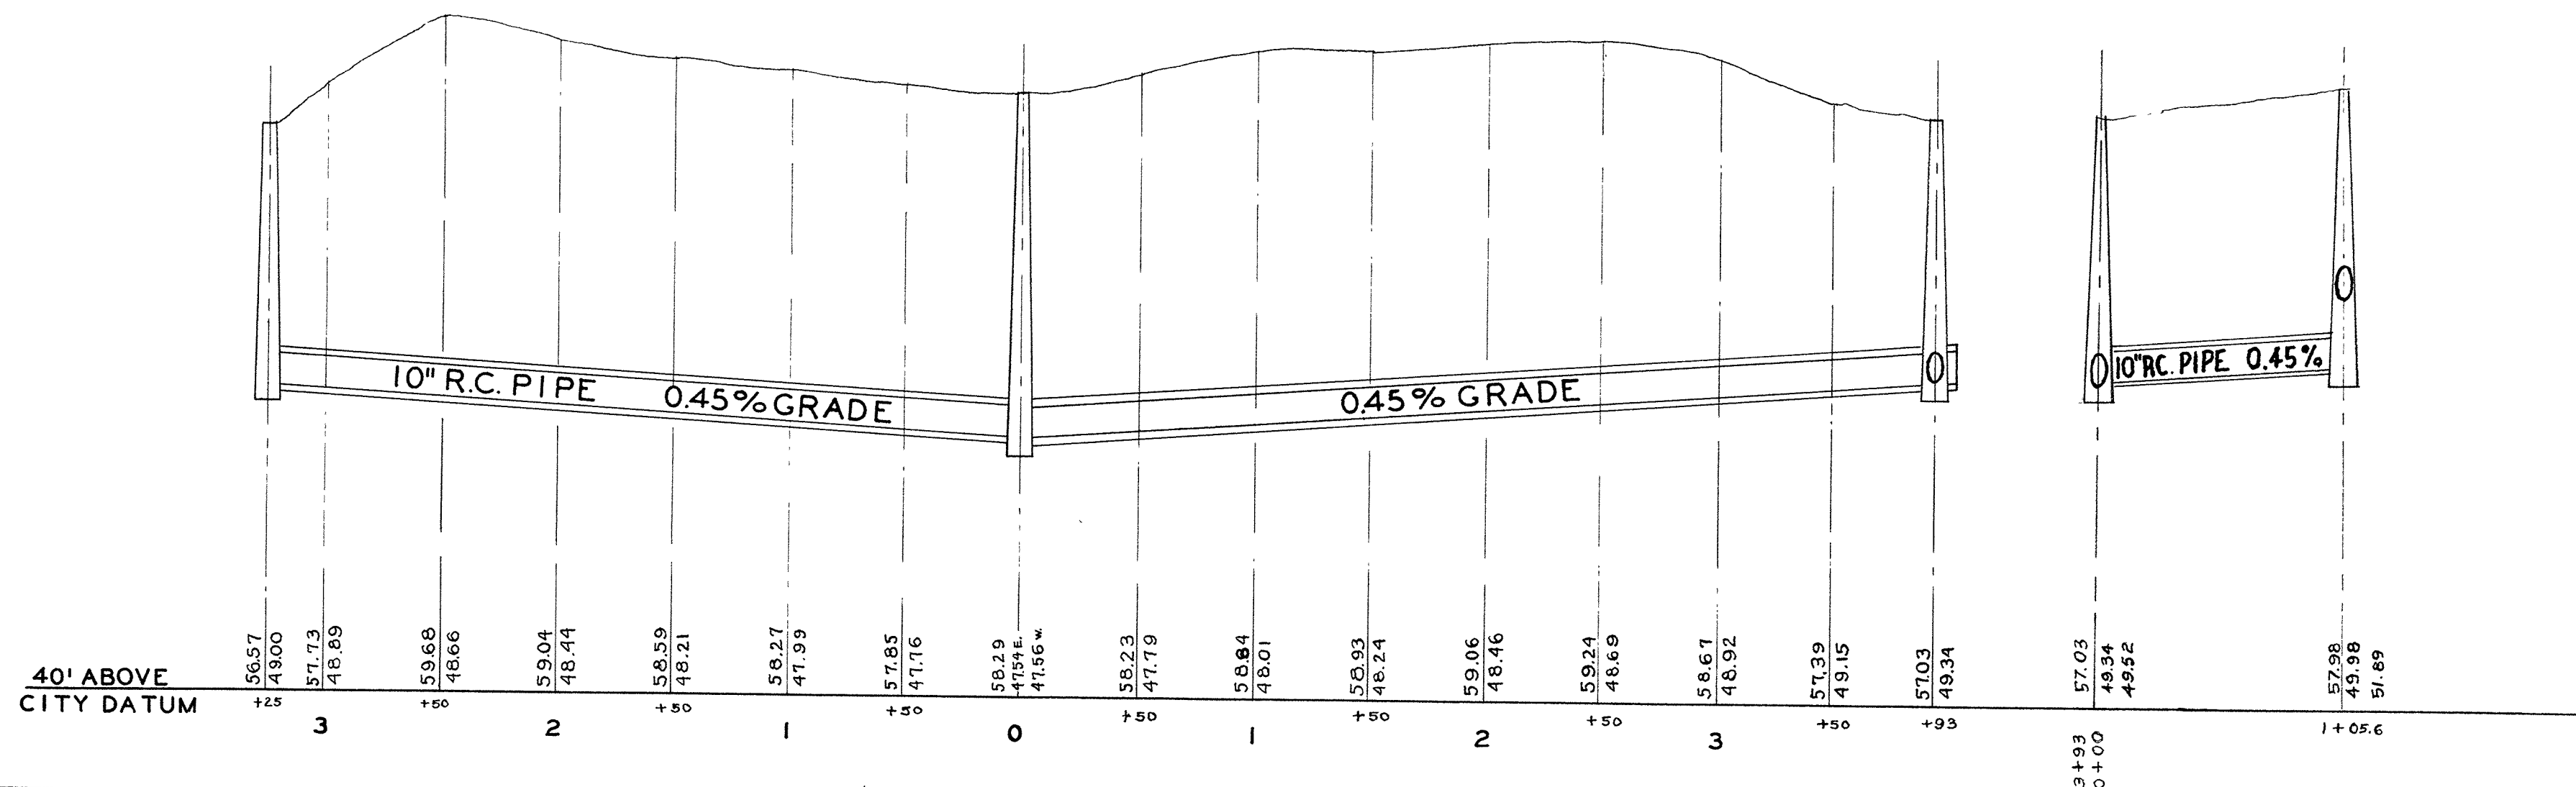

6-45