


CITY OF SUPERIOR SEWER PLAN

HORIZONTAL SCALE: 1"=60'
VERTICAL SCALE: 1"=4'

JOB STARTED FEB. 11, 1936.
JOB COMPLETED APRIL 23, 1936.
W.P.A. LABOR
R.H. DANN INSPECTOR

L.W. PELESKE CITY ENGINEER

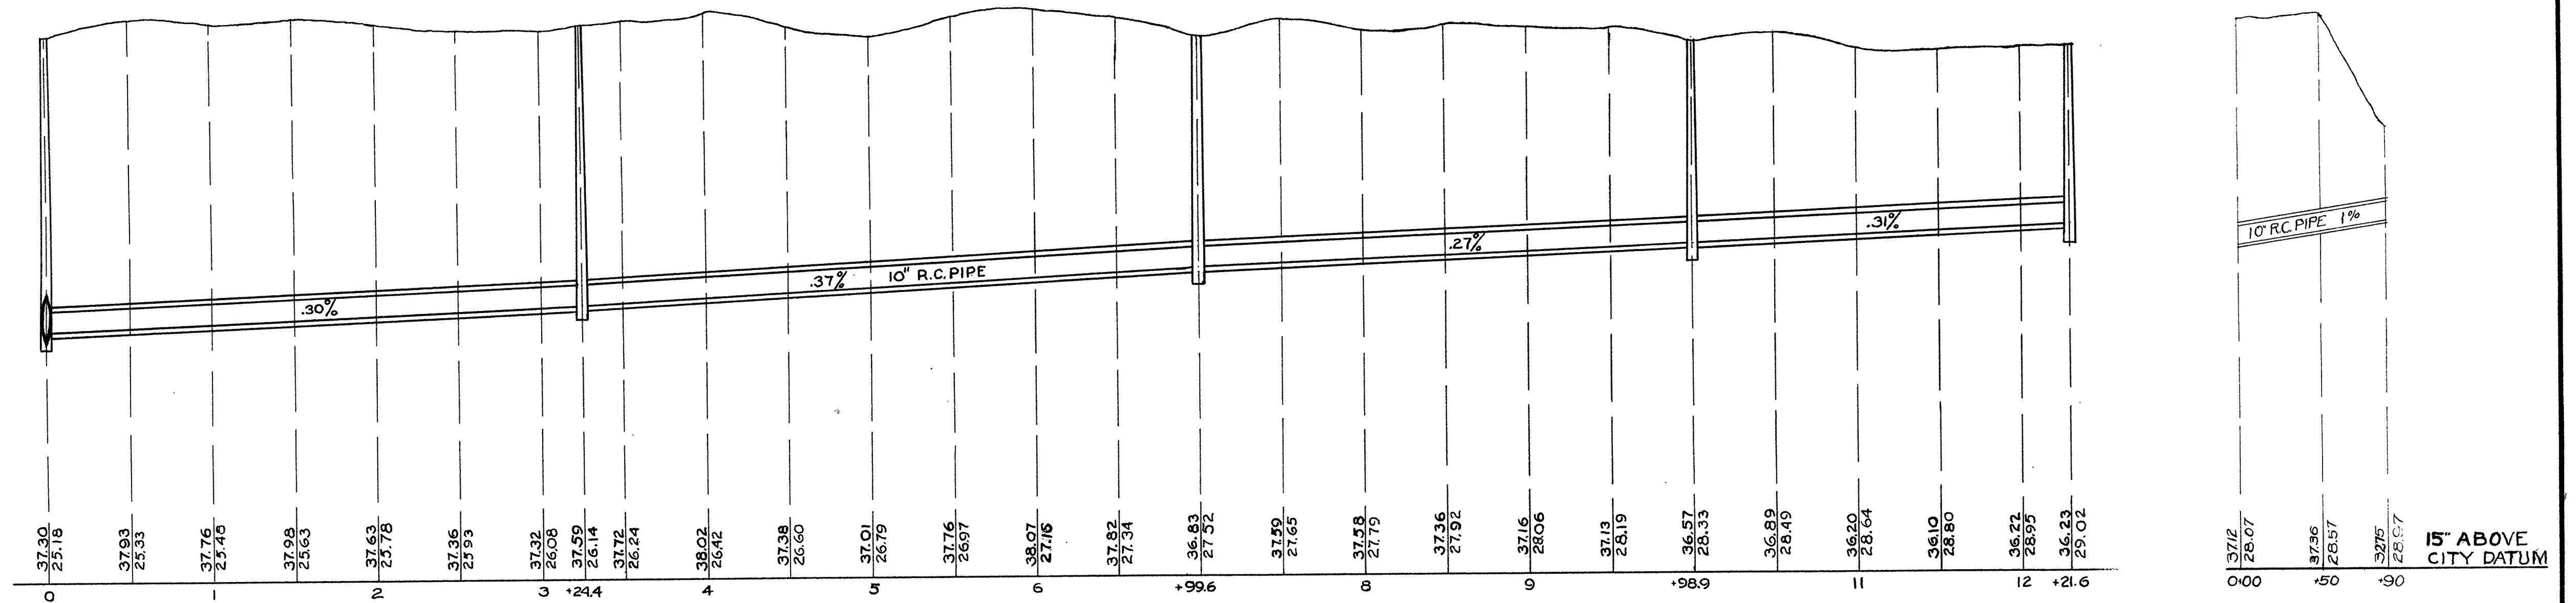

BILLINGS PARK FIRST POINT SEWER

6-8

6-48
WOODSTOCK