

PLAN
5-39
6-39
W.H.S.
R.H.L.

PROFILE
5-39
6-39
W.H.S.

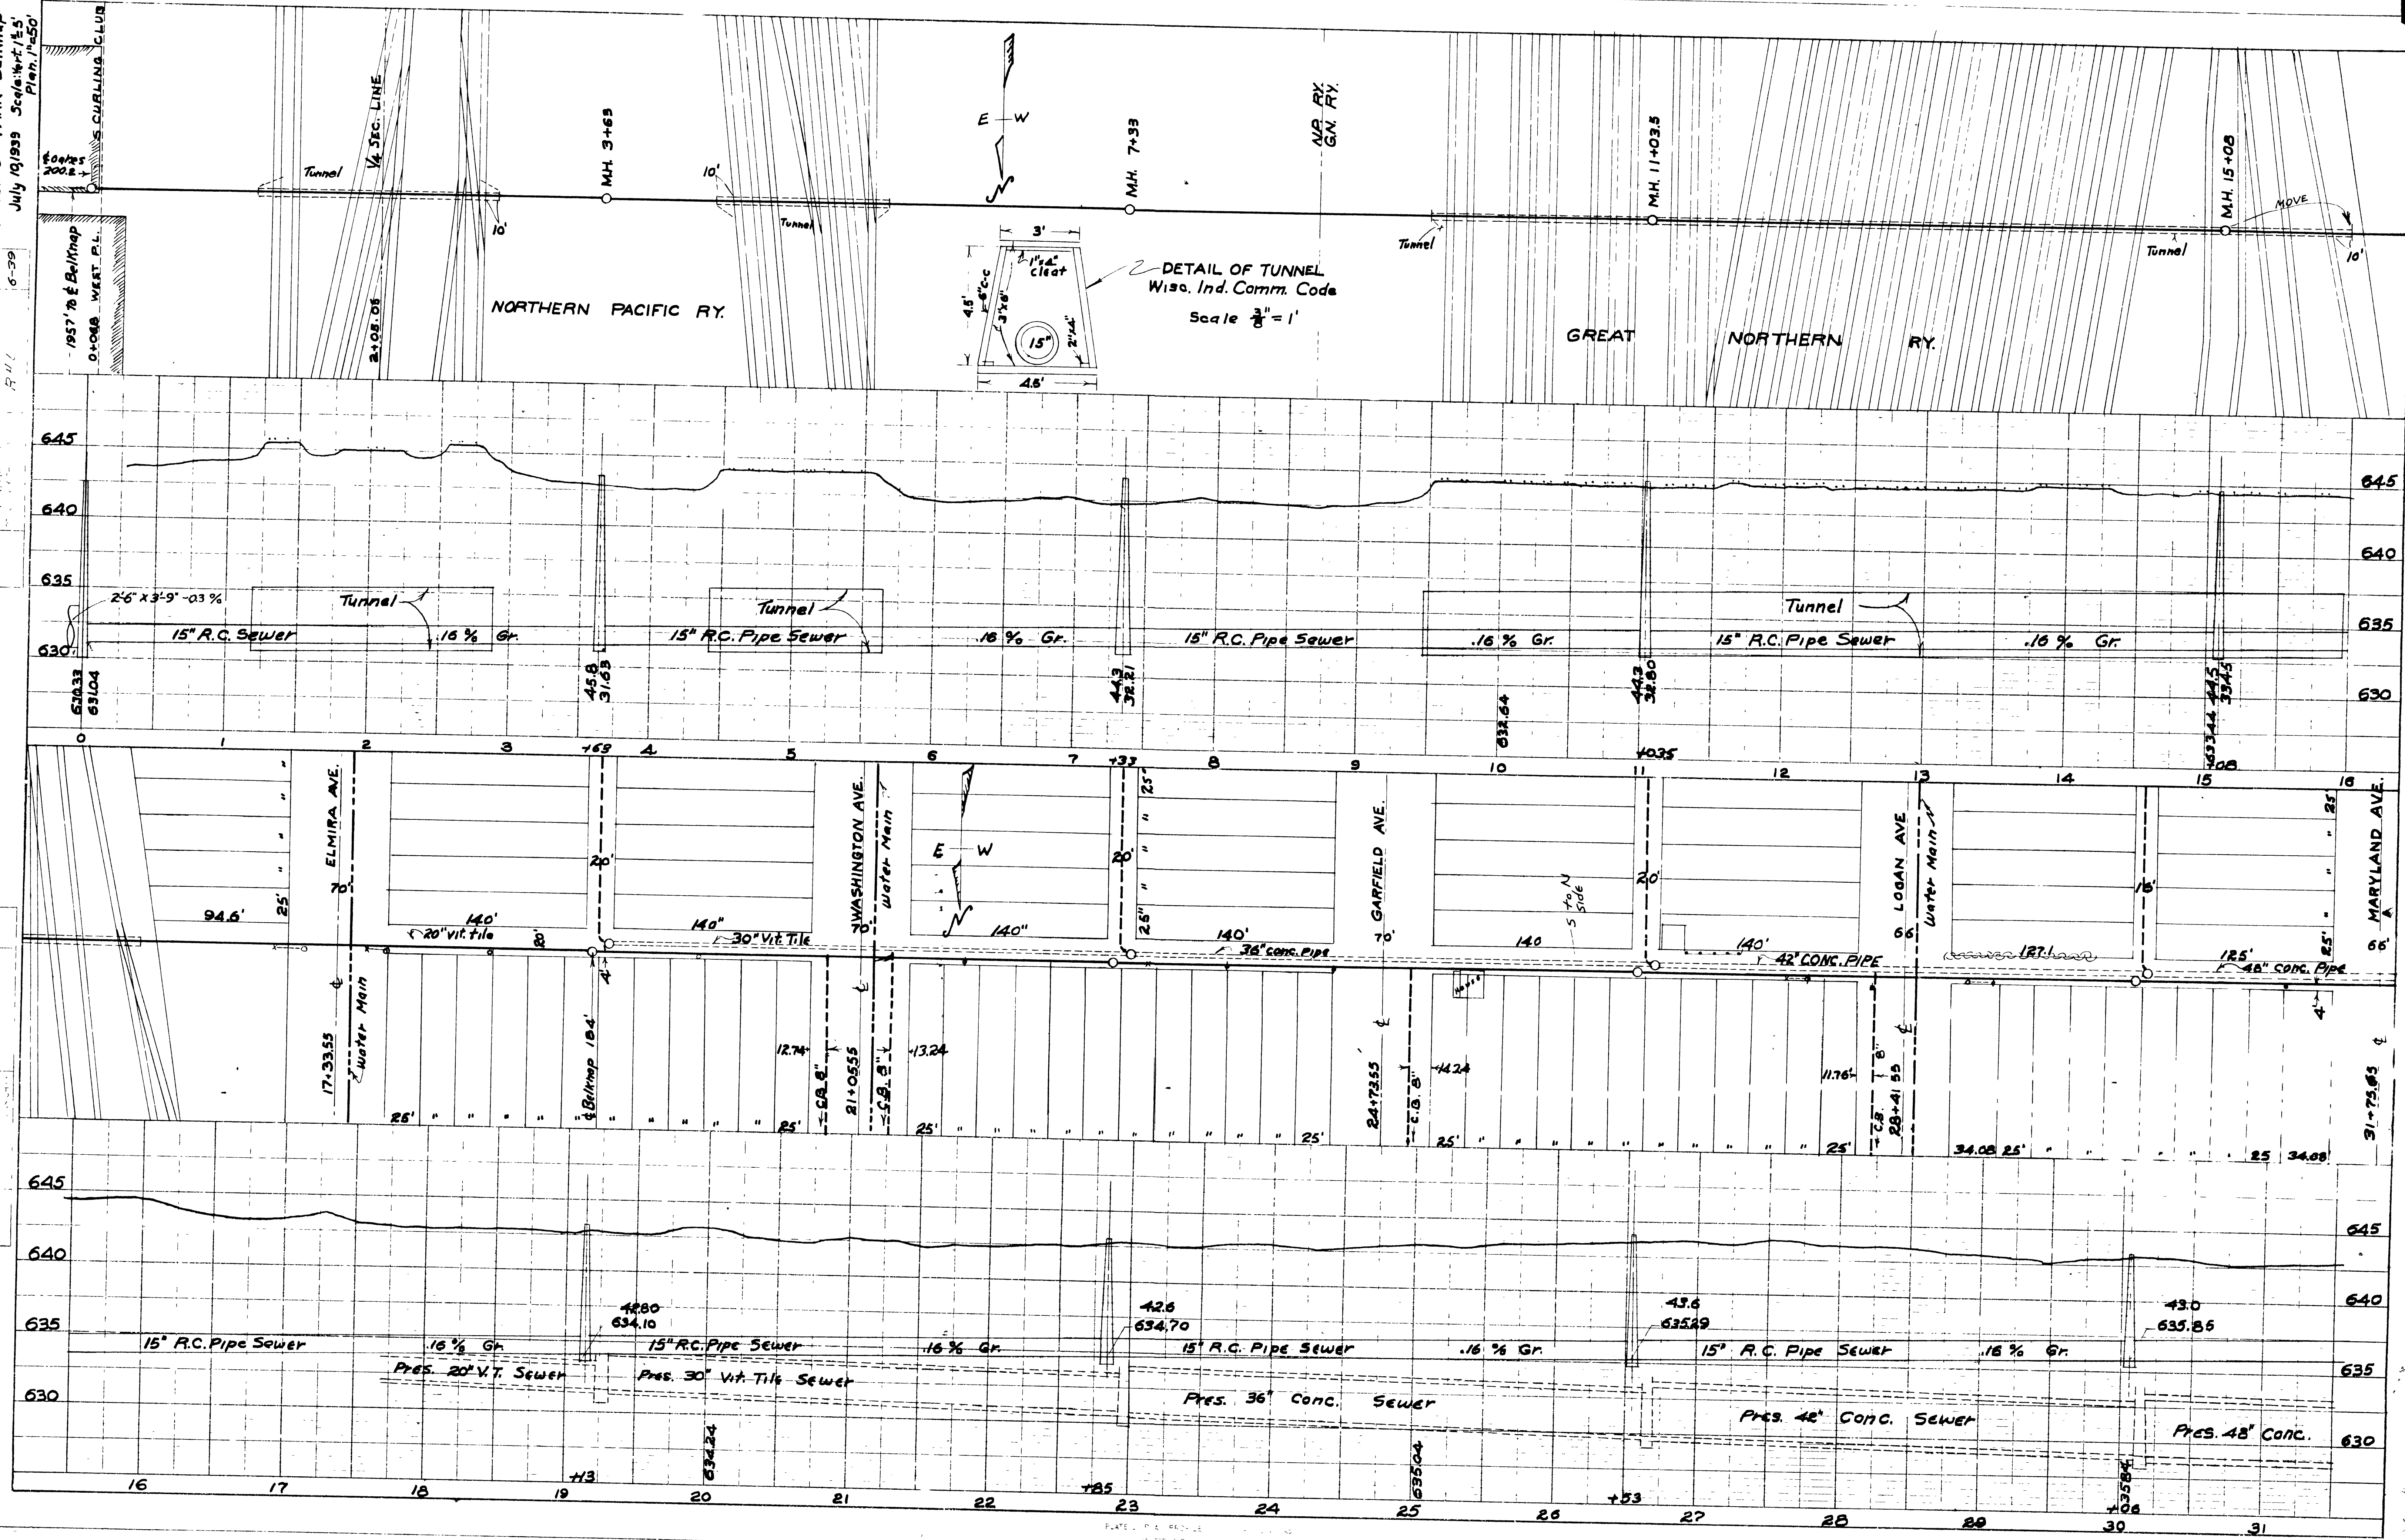


PLATE FOR RECORD