



STATE PROJECT NUMBER	SHEET NO.

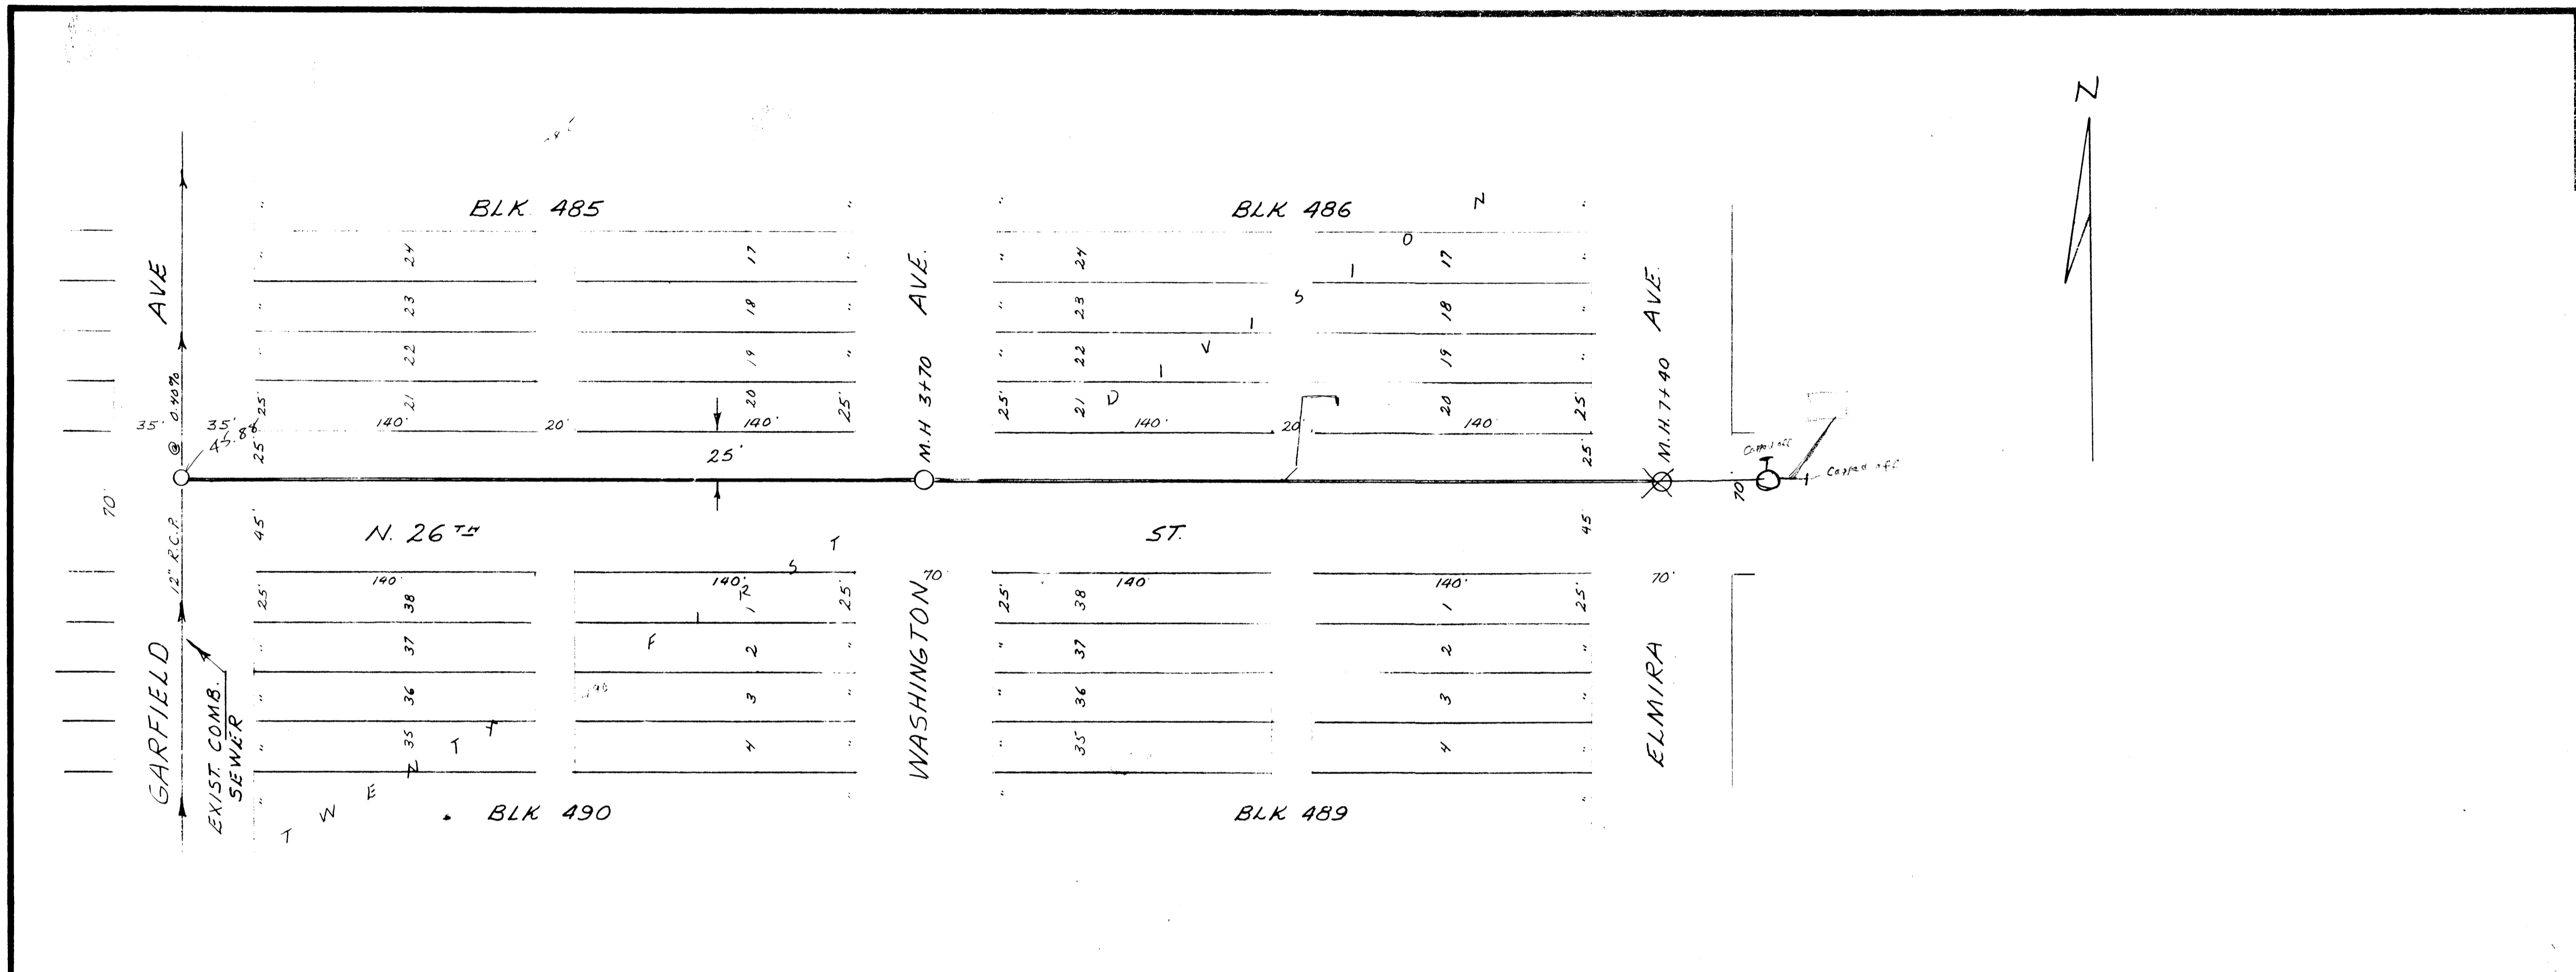

APPROVED
CITY ENGINEER
 CITY OF SUPERIOR, WI
C.P. Inglin Date 7/22/85

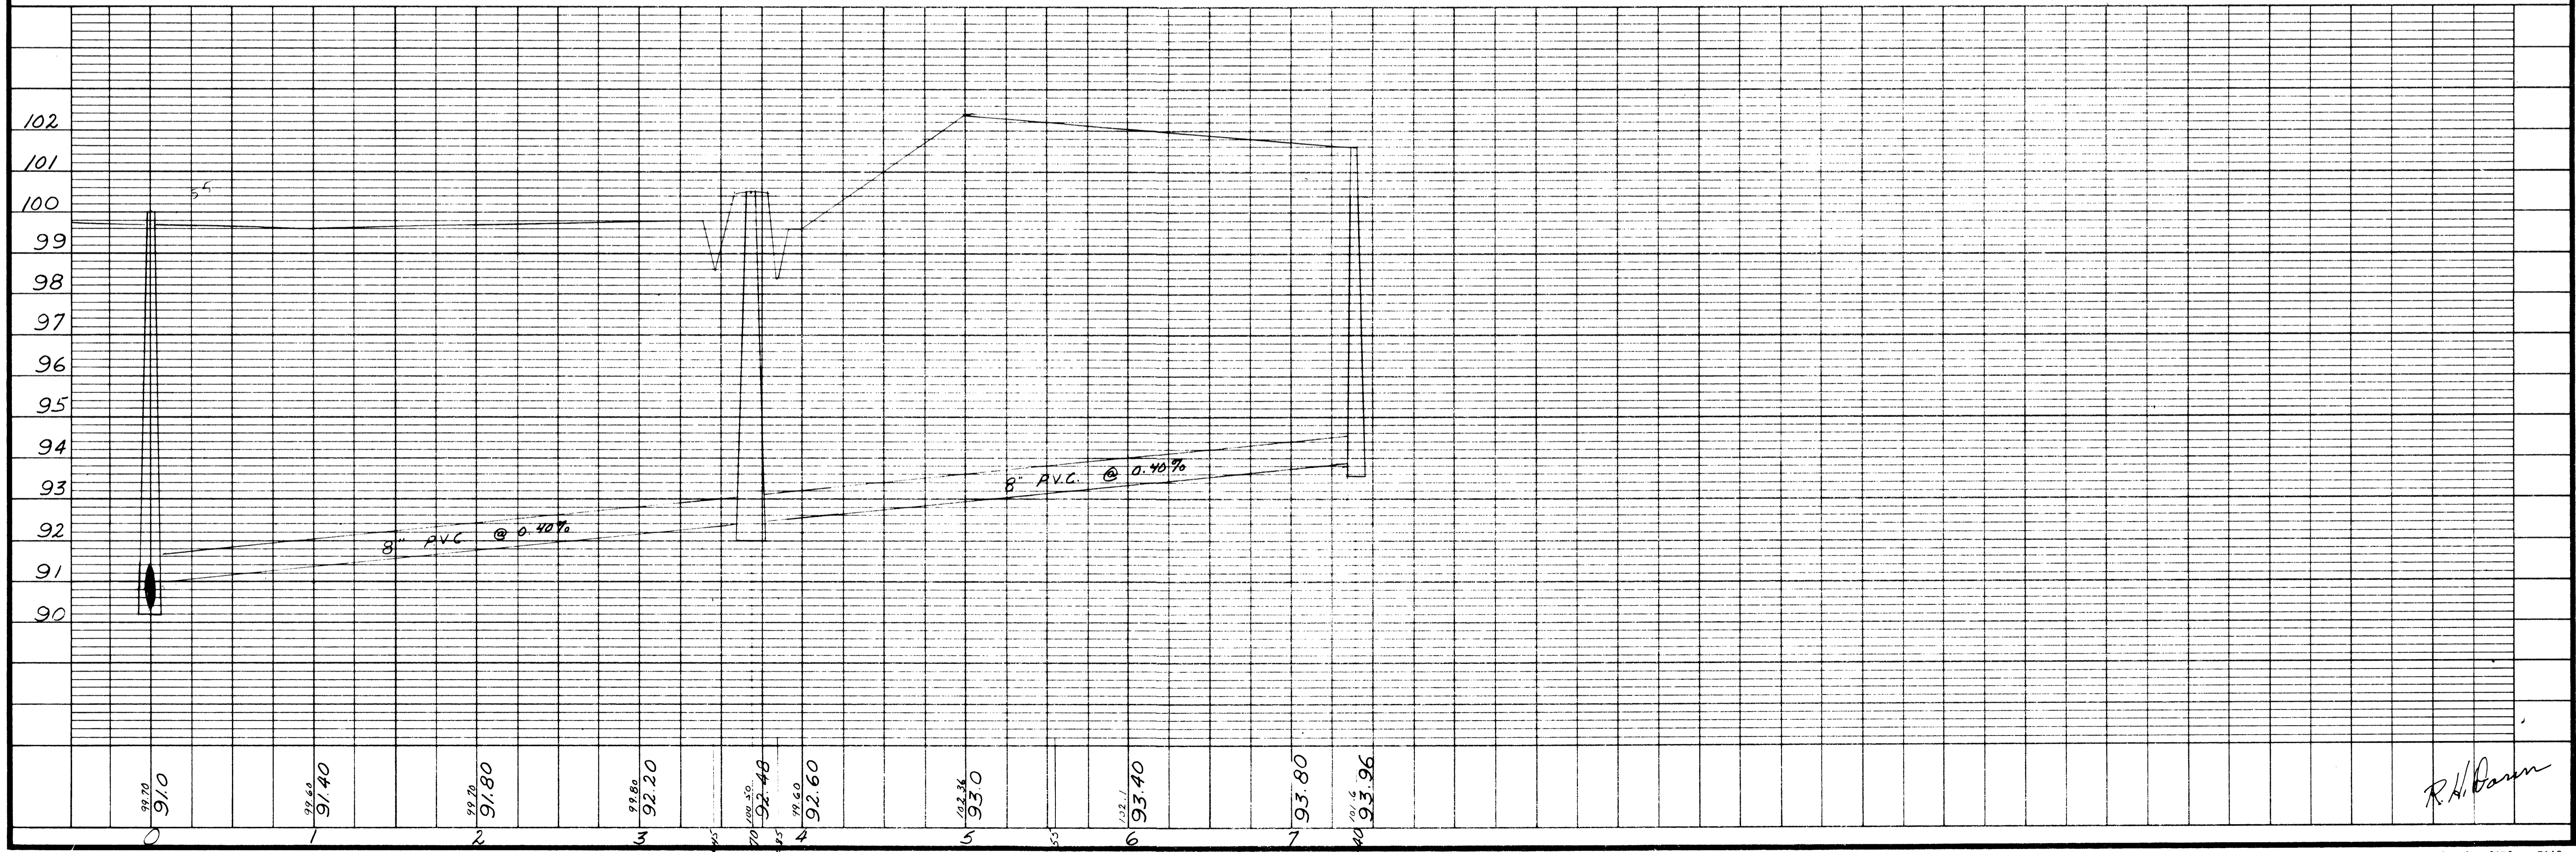

R.H. Darrin