

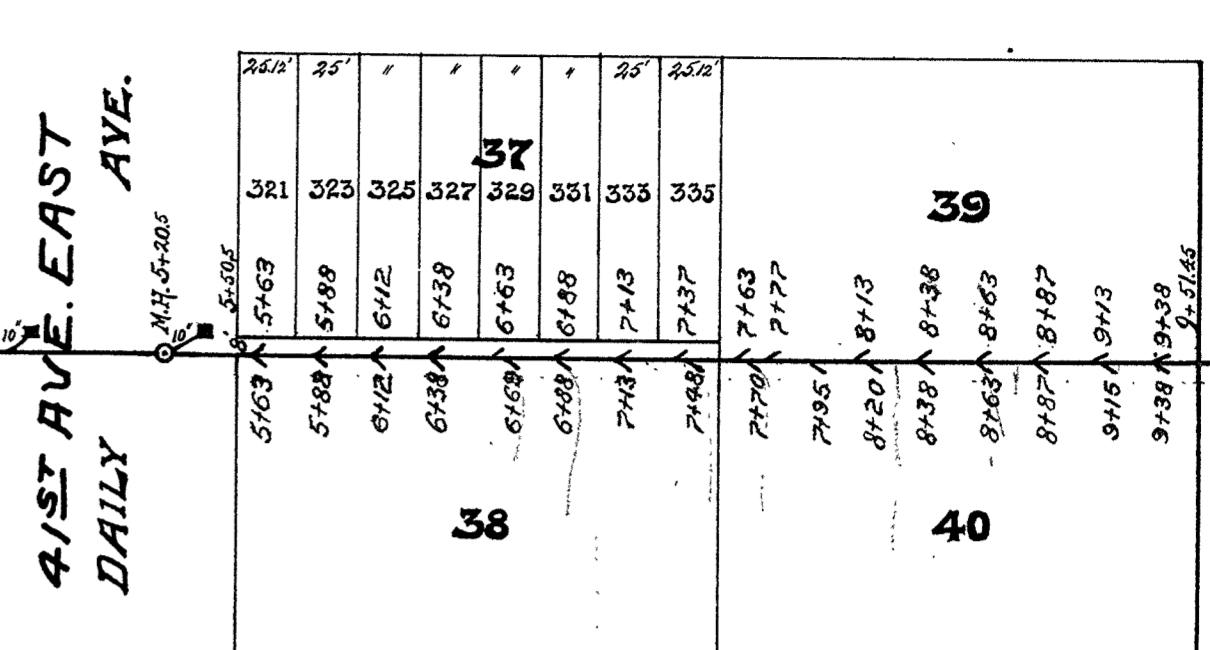
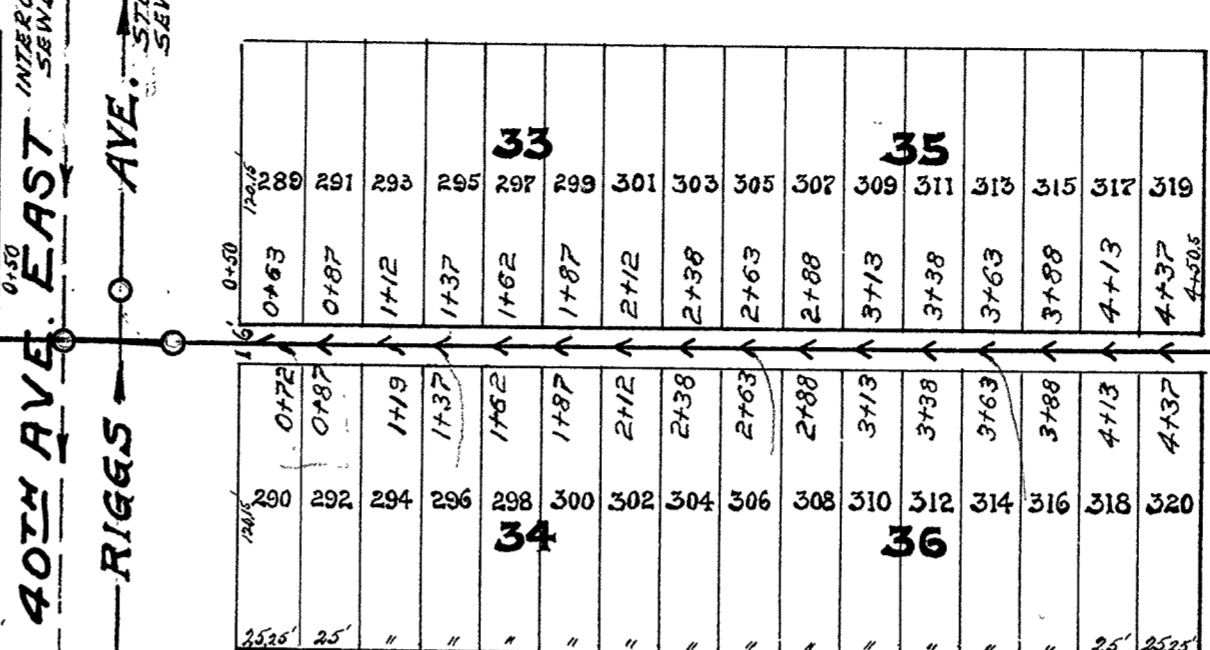


38TH AVE. E.
M'BAIN AVE.

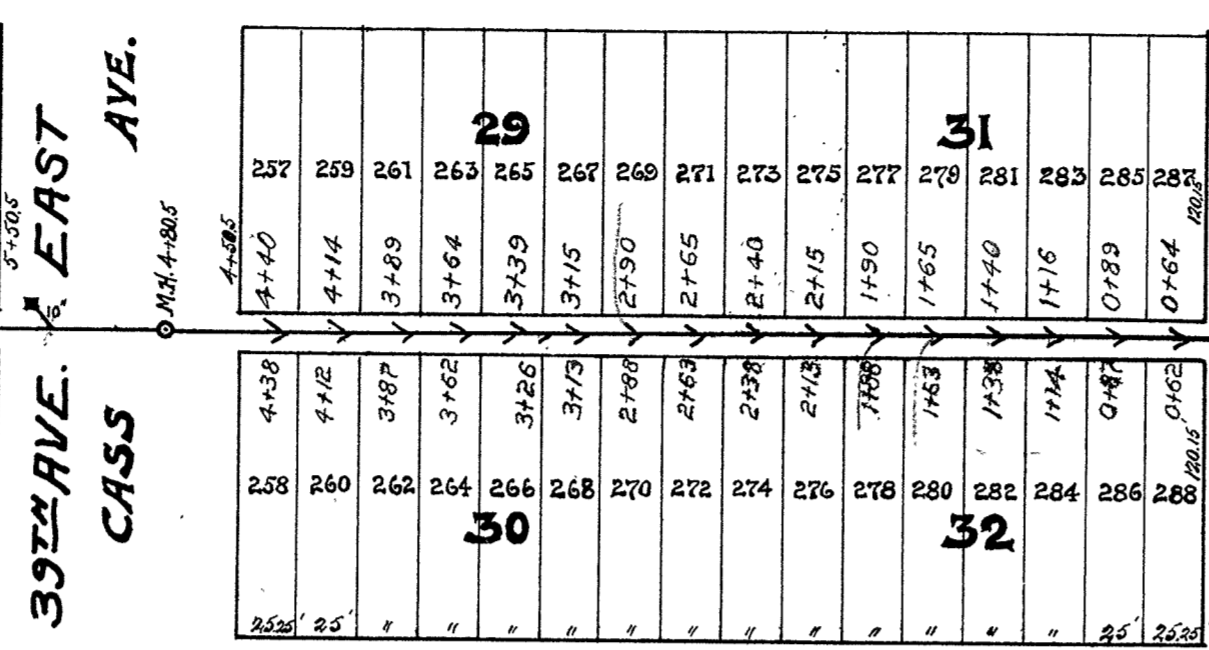

Horizontal Scale: 1 in. = 80 ft.
 Vertical Scale: 1 in. = 4 ft.
 CONTRACT N^o 1418
 Contract let June 29th 1914
 Contract completed Dec. 8th 1914
 Riches & Anderson. Contractor
 W.D. Belknap Inspector
 E.B. Banks City Engineer.

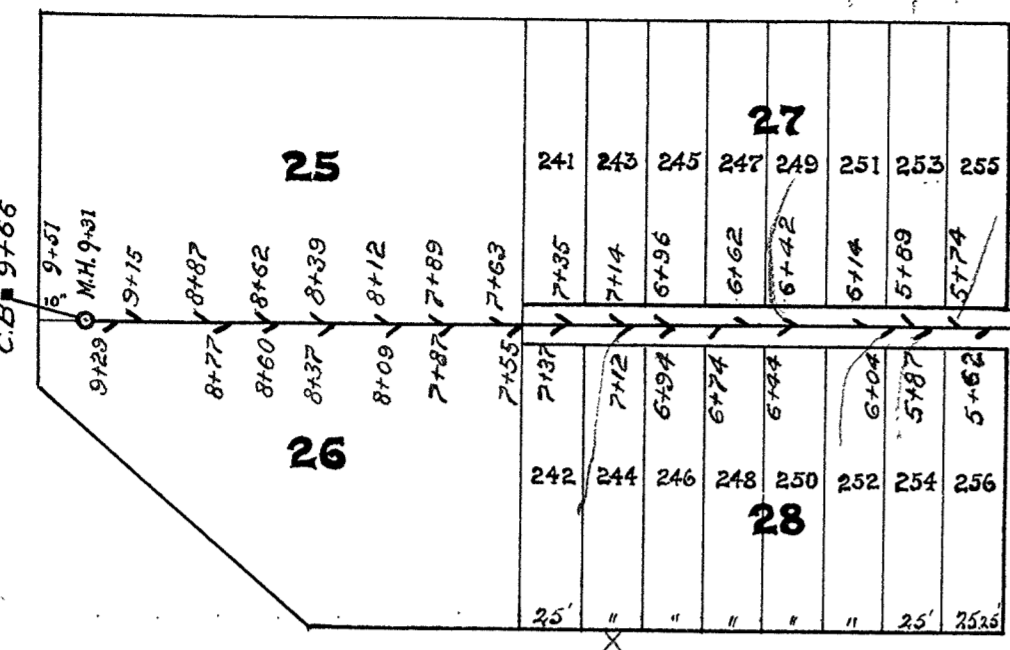