
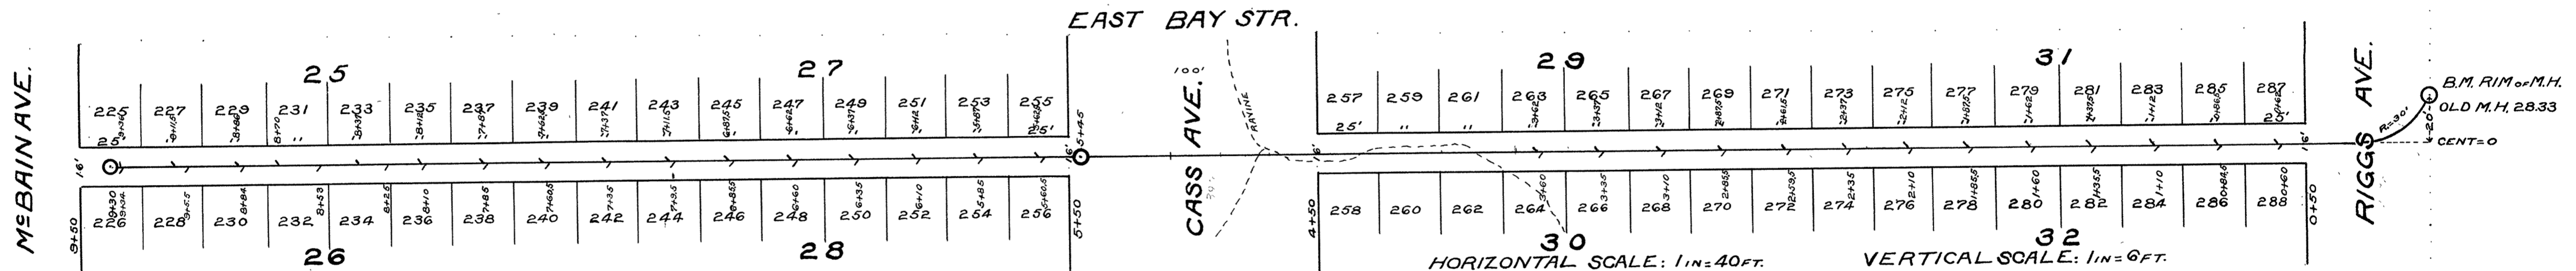



MAP AND PROFILE  
SHOWING SEWER IN WATER ST.  
AND IN THE ALLEY BET. 8<sup>TH</sup> & 9<sup>TH</sup> STREETS  
FROM WATER ST. TO RIGGS AVE.

HORIZONTAL SCALE: 1 IN = 100 FT.  
VERTICAL SCALE: 1 IN = 6 FT.  
CONTRACT N<sup>o</sup> 1646  
CONTRACT LET DEC. 23<sup>RD</sup> 1921  
CONTRACT COMPLETED JAN. 20<sup>TH</sup> 1922  
CITY OF SUPERIOR CONTRACTOR  
NICK ANDERSON INSPECTOR  
E. BANKS CITY ENGINEER

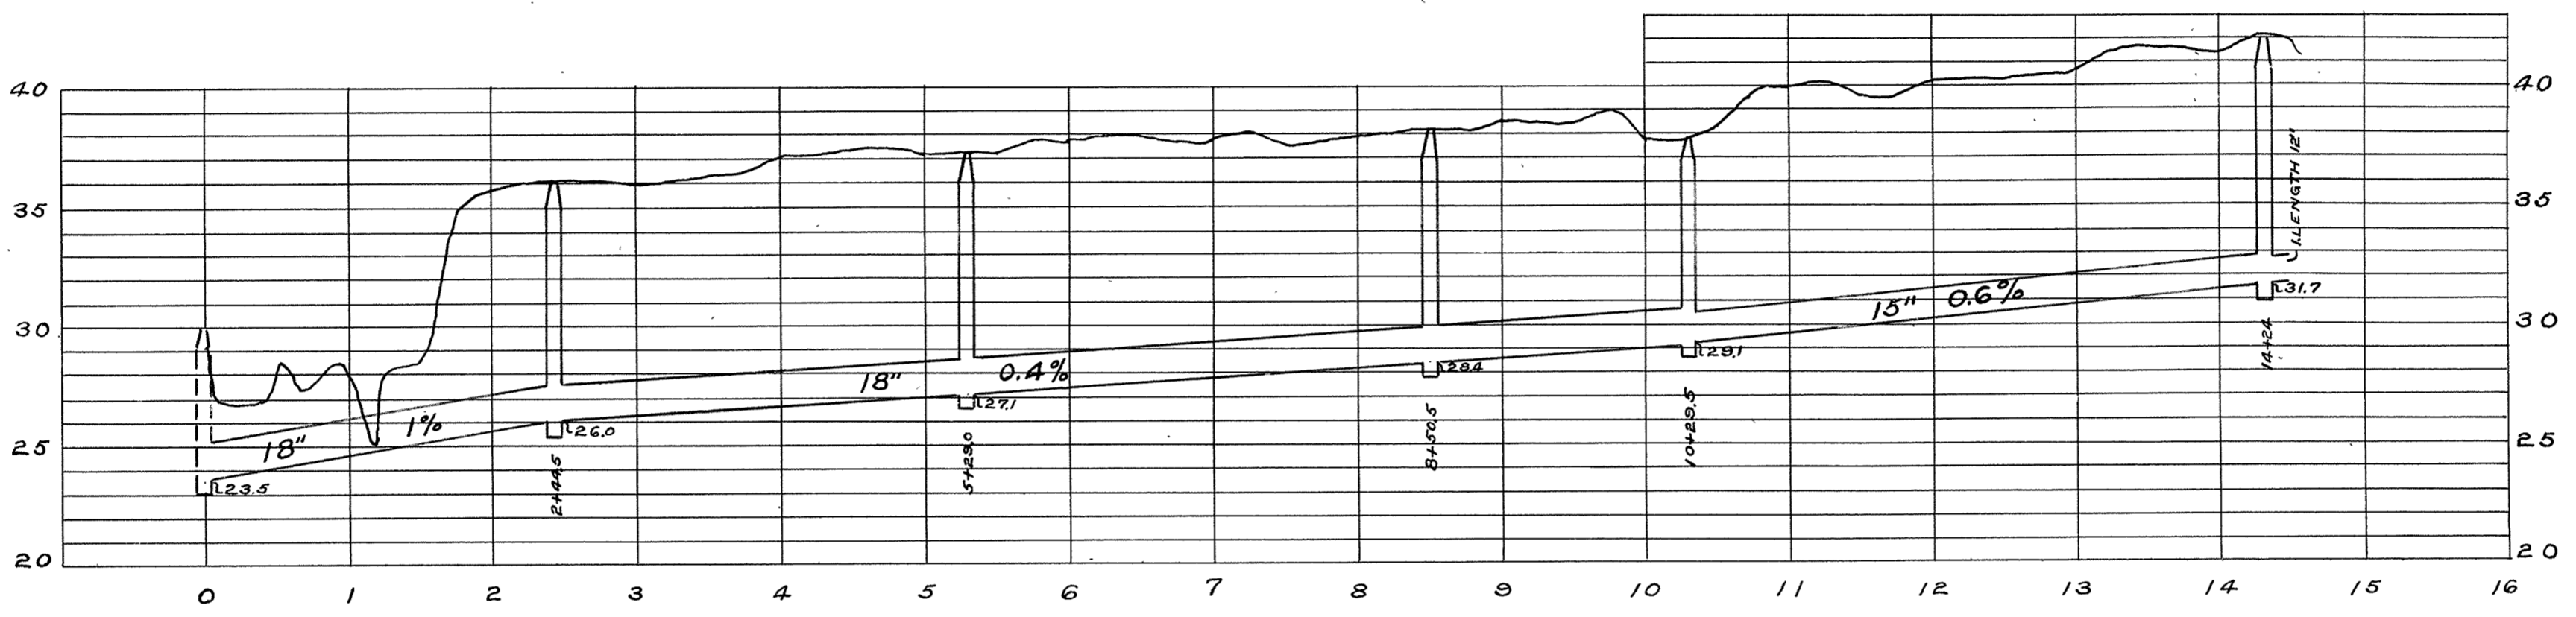

MAP AND PROFILE  
SHOWING SEWER IN ALLEY BET. EAST BAY ST. AND EAST ST. CROIX  
ST. FROM M<sup>o</sup>BAIN AVE. TO RIGGS AVE.

HORIZONTAL SCALE: 1 IN = 40 FT. VERTICAL SCALE: 1 IN = 6 FT.  
CONTRACT N<sup>o</sup> 1647  
CONTRACT LET DEC. 23<sup>RD</sup> 1921 CONTRACT COMPLETED FEB. 15<sup>TH</sup> 1922.  
CITY OF SUPERIOR CONTRACTOR NICK ANDERSON INSPECTOR  
E. BANKS CITY ENGINEER.

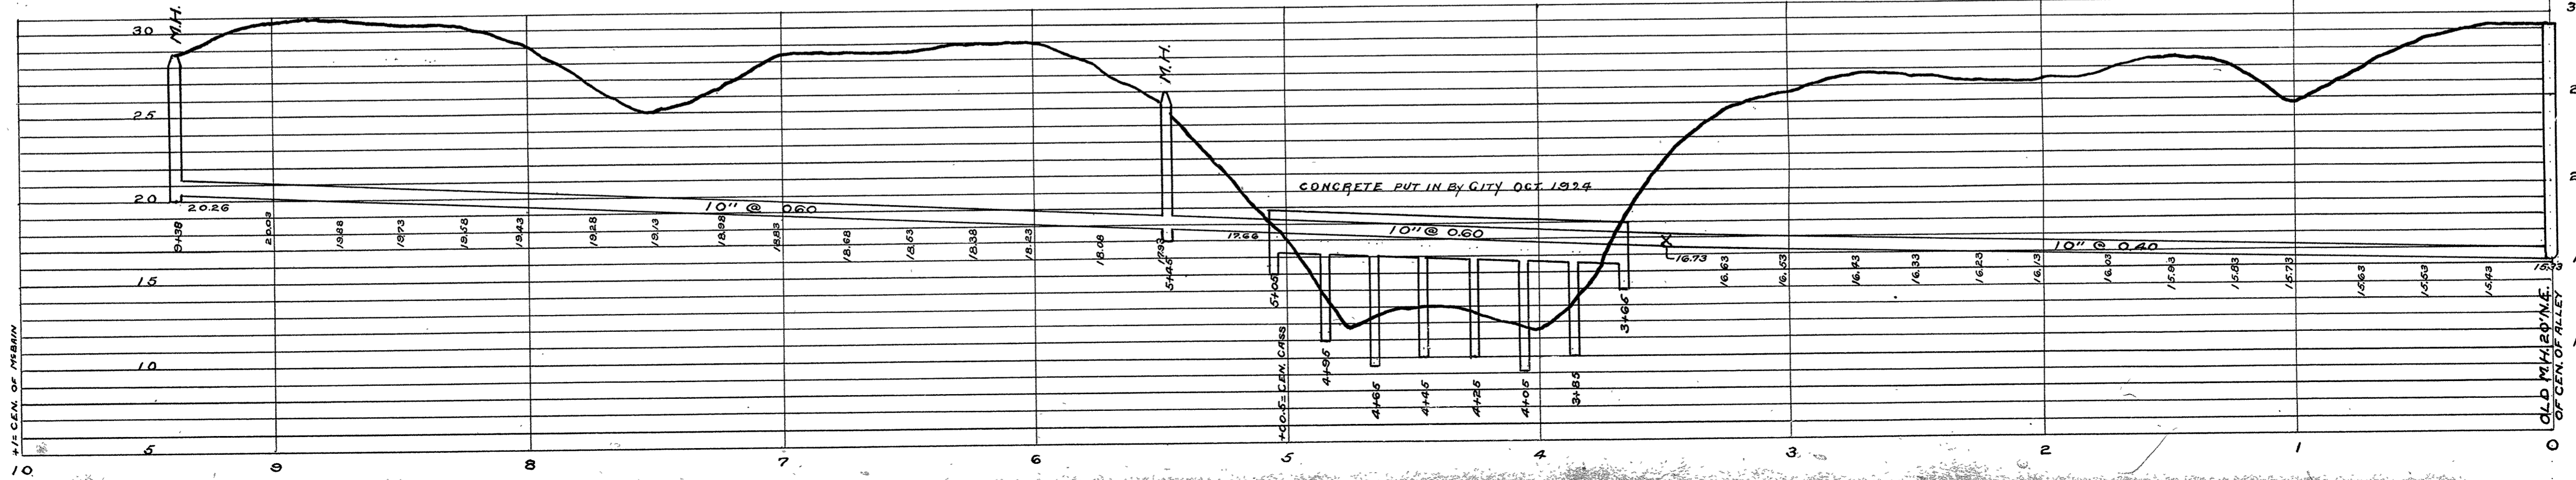

7-18  
7-18