



L.A. POINT AVE.
35th AVE. EAST

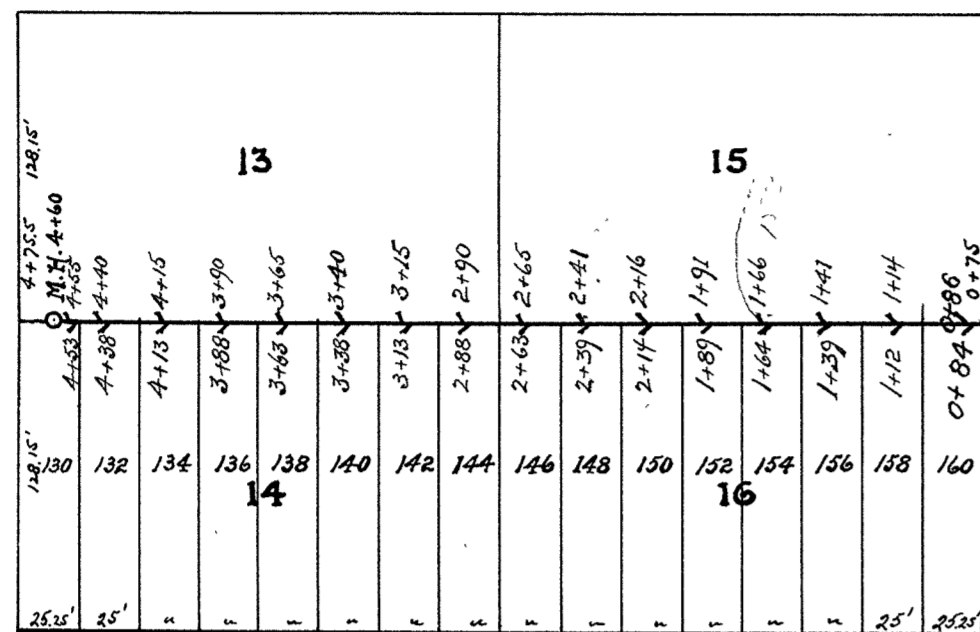


E. FIRST ST.

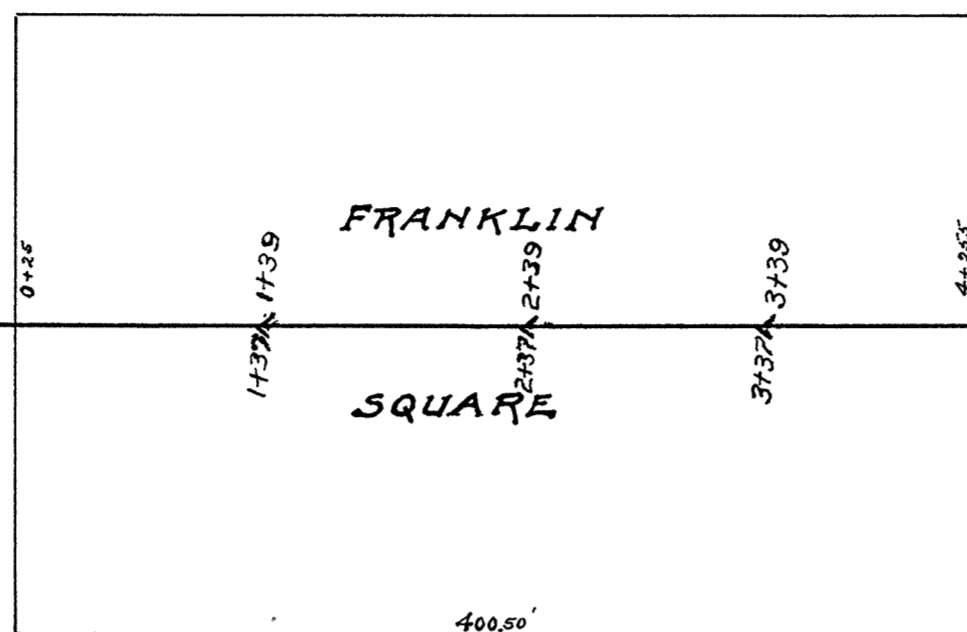


E. SECOND ST.

37th AVE. EAST
CLARK

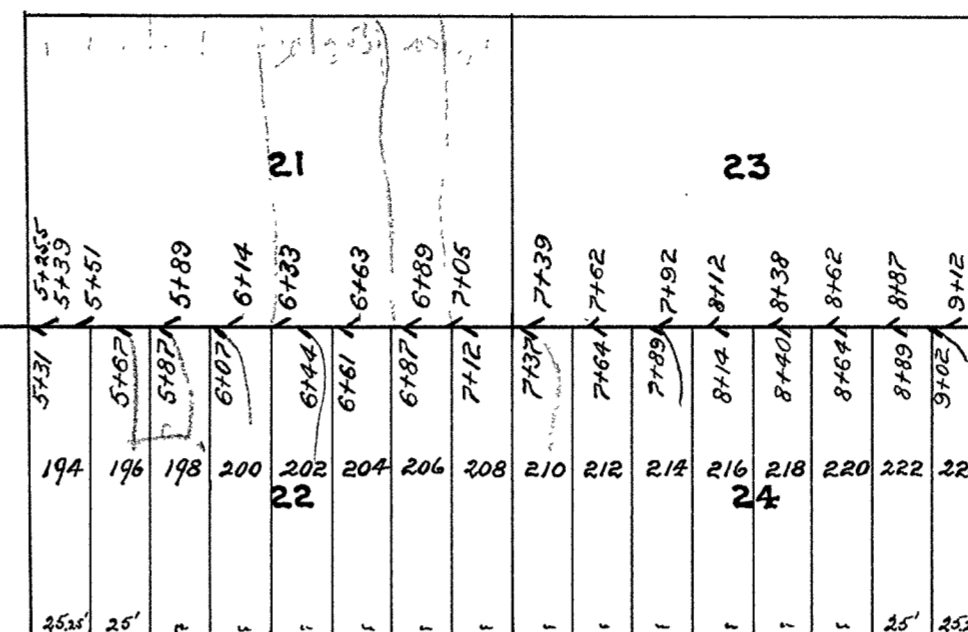

ST.

38th AVE. EAST
Mc BAIN

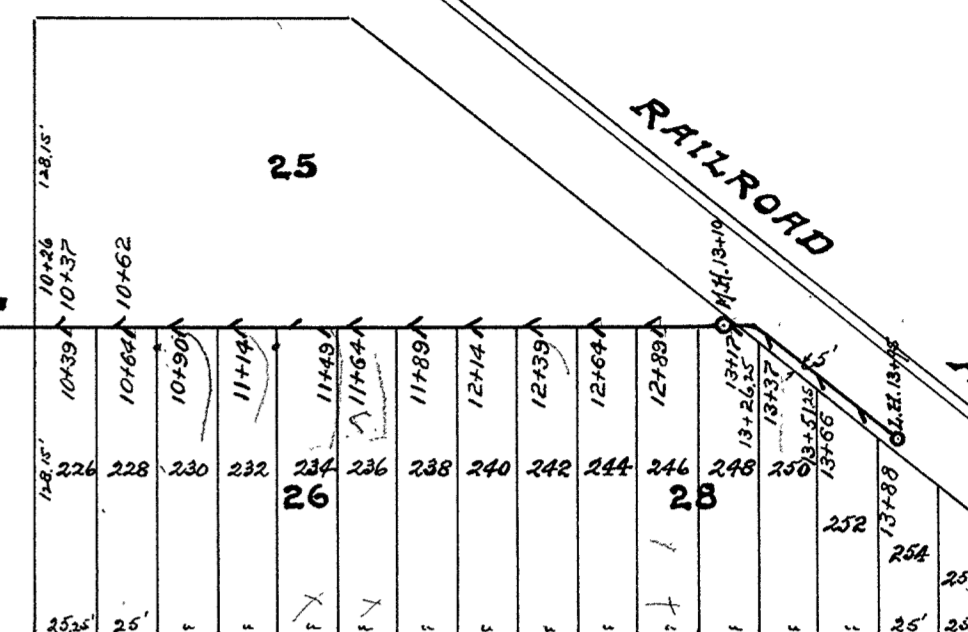

Horizontal Scale: 1 in. = 80 ft.
Vertical Scale: 1 in. = 4 ft.
CONTRACT N^o: 1423
Contract let July 1st 1914
Contract completed Dec. 1st 1914.
Contractor Magnus Peterson
Inspector W. D. Belknap
City Engineer E. B. Banks

