


Horizontal Scale: 1 in. = 80 ft.
 Vertical Scale: 1 in. = 4 ft.
 CONTRACT No 1424
 Contract let July 1st 1914
 Contract completed Dec. 1st 1914.
 Magnus Peterson. Contractor
 And. Solin. Inspector
 E. B. Banks City Engineer

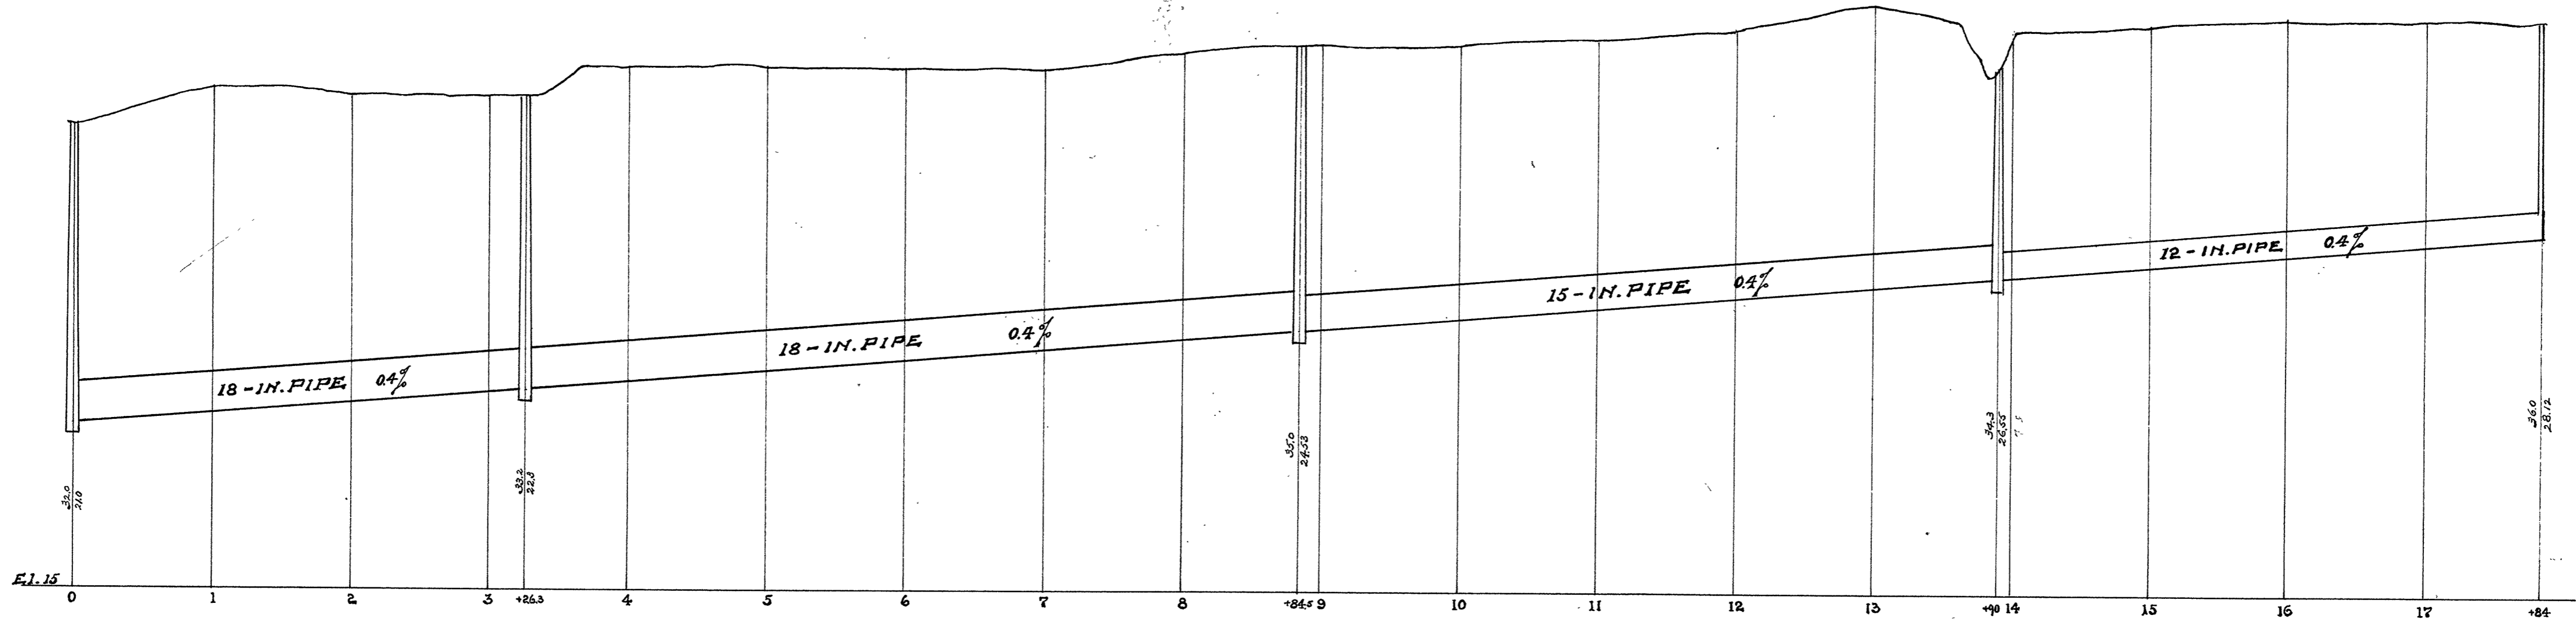

7-3