


CITY OF SUPERIOR
 PLAN AND PROFILE
STORM SEWER
 JOB COMPLETED *JUNE* 1954
 CITY ENGINEER E.W. BERG
 HORIZONTAL SCALE 1" = 60'
 VERTICAL SCALE 1" = 4'

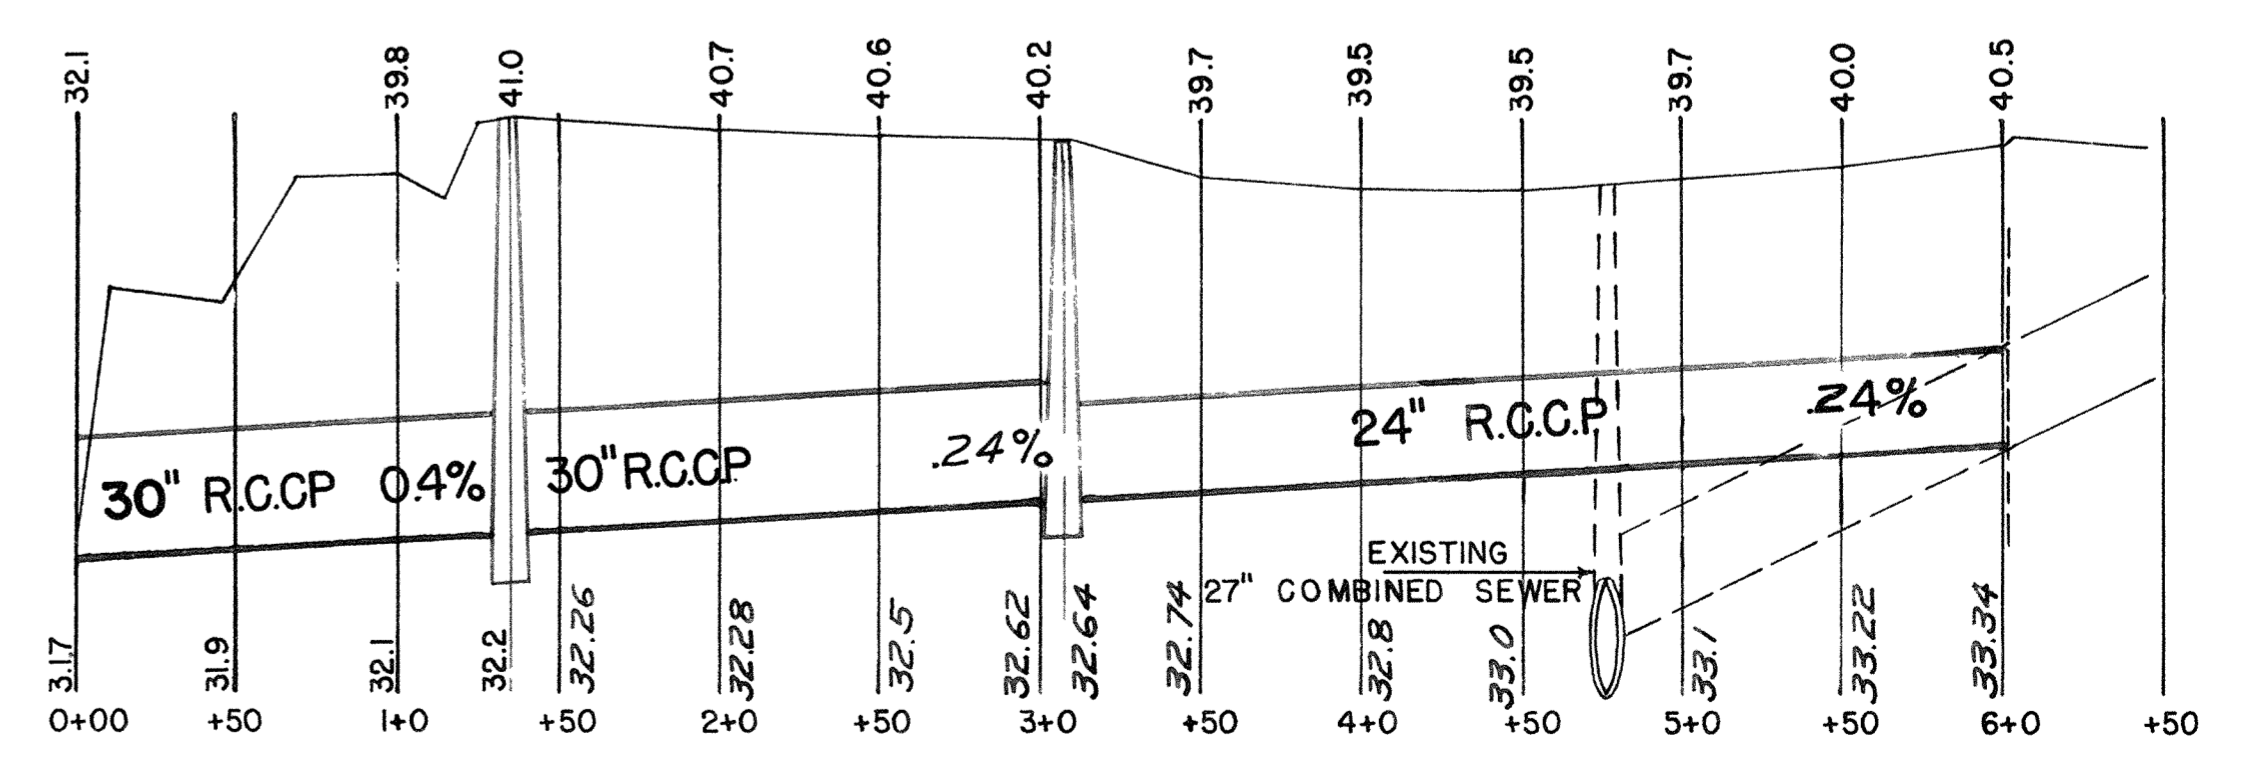

(CITY DATUM)