
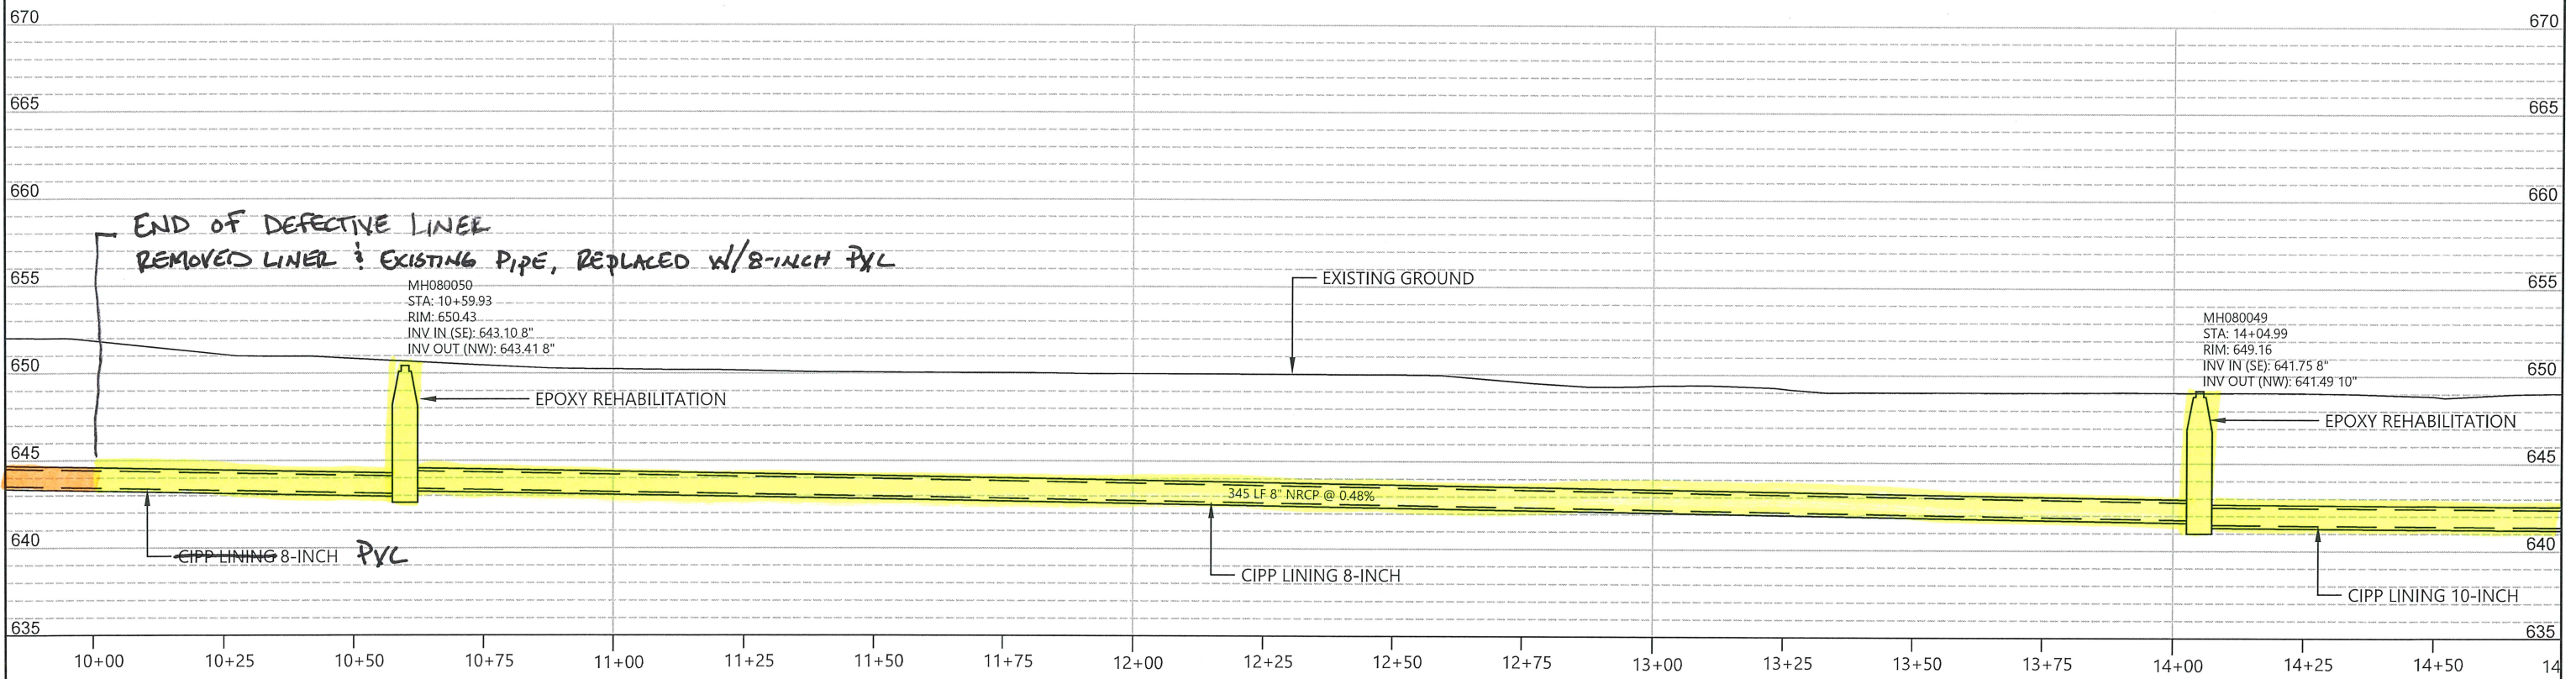


	CITY OF SUPERIOR, WI - ENVIRONMENTAL SERVICES DIVISION OF PUBLIC WORKS	HWY 2 PIPE PLAN & PROFILE 4+00 - 9+75	DRAWN: BG	PLOT: 9/16/2020	SHEET 5 OF 13
	ITASCA EAST 2ND INTERCEPTOR HYDROGEN SULFIDE SANITARY SEWER REHABILITATION		APPROVED: EA		ADDENDUM: (N/A)

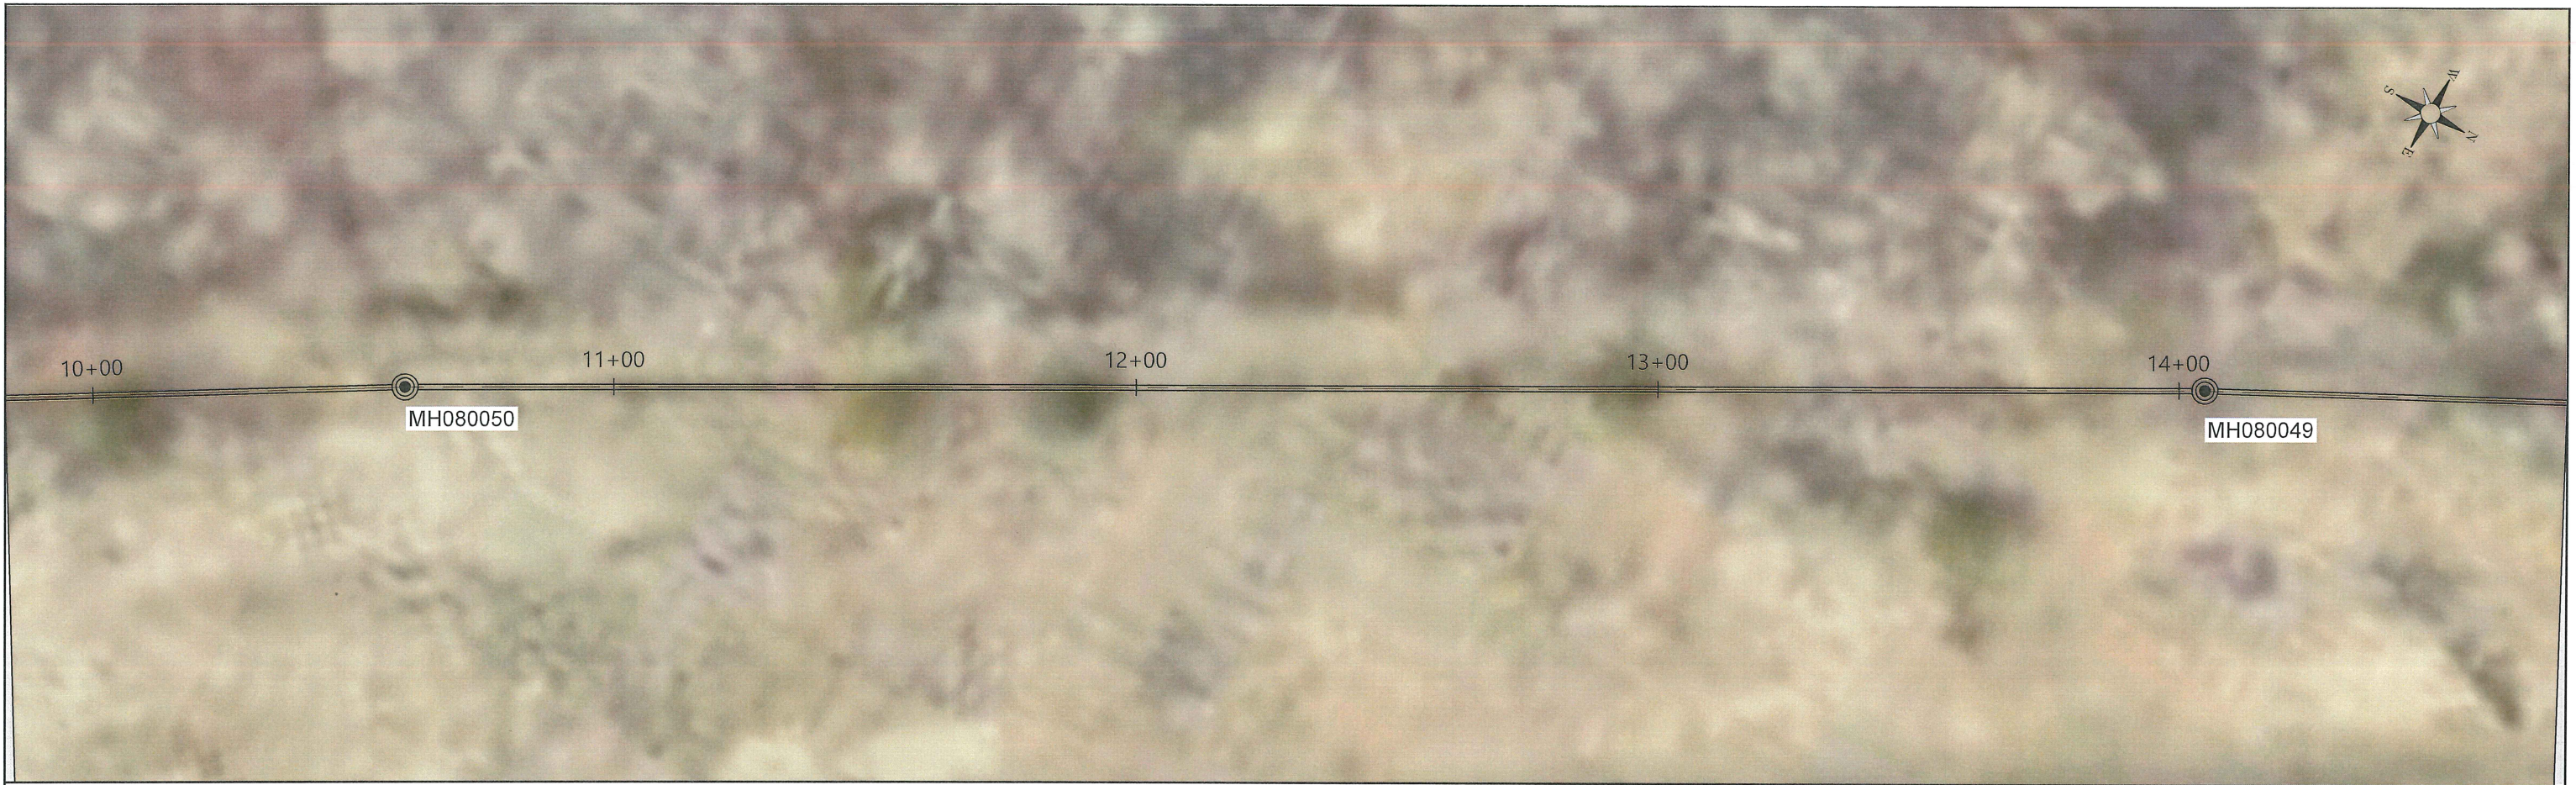

	CITY OF SUPERIOR, WI - ENVIRONMENTAL SERVICES DIVISION OF PUBLIC WORKS	HWY 2 PIPE PLAN & PROFILE 9+75 - 14+50	DRAWN: BG	PLOT: 9/16/2020	SHEET 6 OF 13
	ITASCA EAST 2ND INTERCEPTOR HYDROGEN SULFIDE SANITARY SEWER REHABILITATION		APPROVED: EA		ADDENDUM: (N/A)