


BENCH MARKS			
NO.	STATION	DESCRIPTION	ELEV.
5	91+60 T.L.	16" W. PINE 70' RT.	664.02

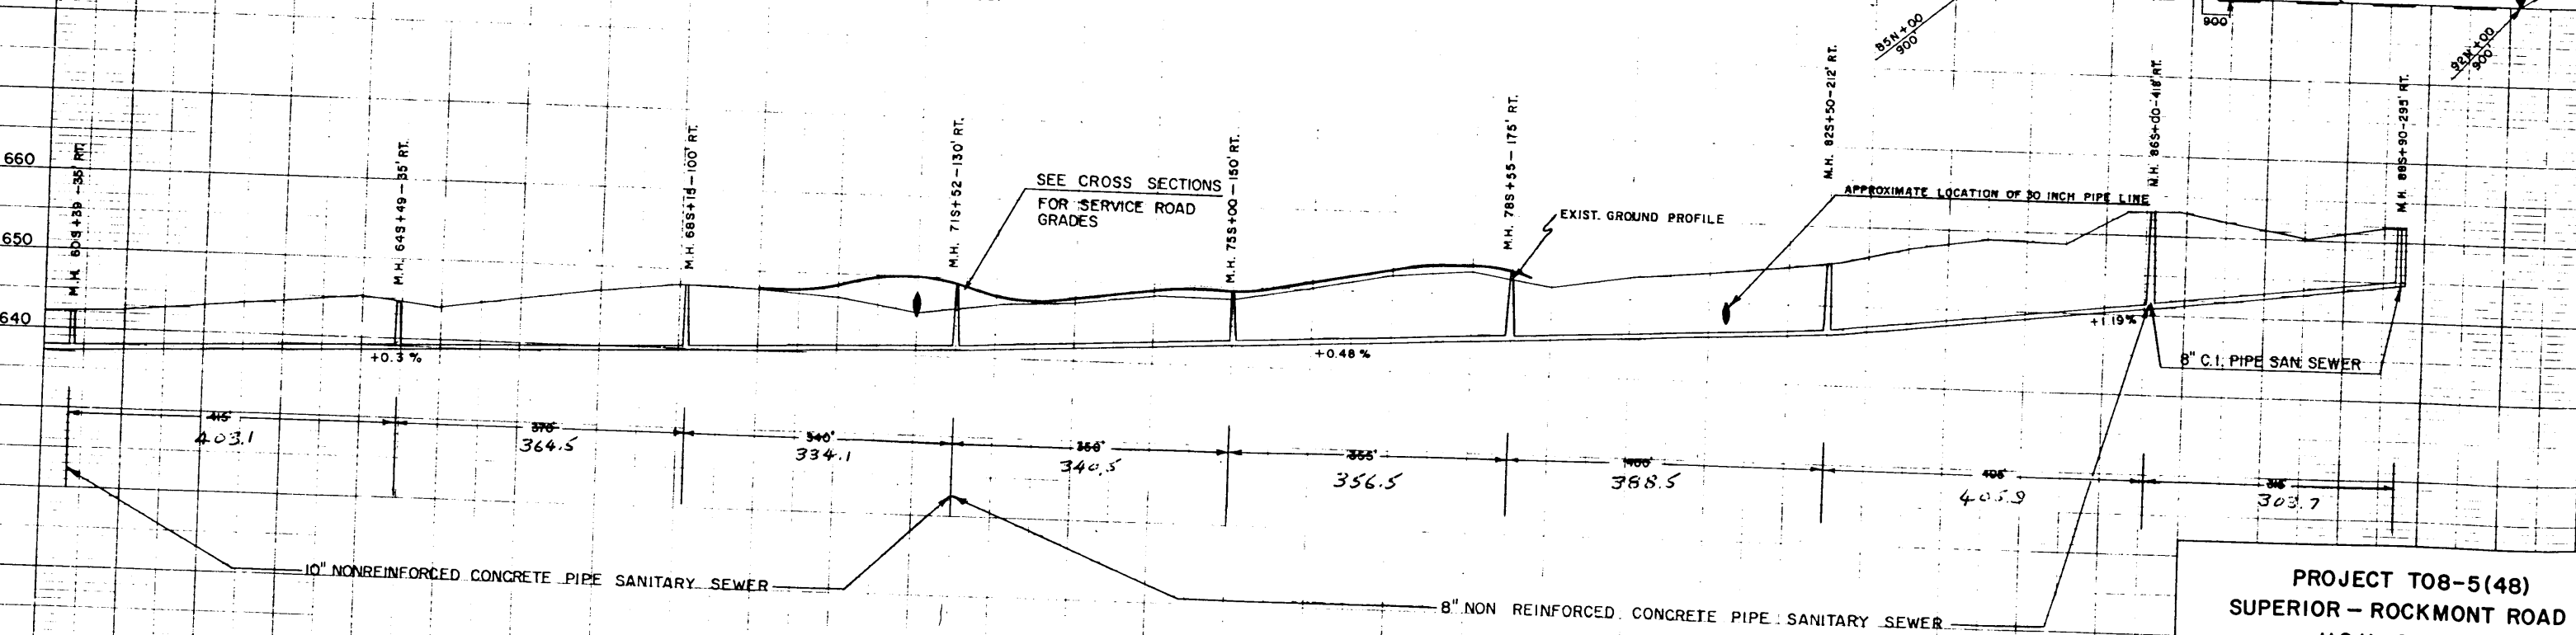

PROJECT TO8-5(48)
 SUPERIOR - ROCKMONT ROAD
 U.S.H. 2 & 53
 PLAN AND PROFILE
 SANITARY SEWER
 FOR