

AS-BUILT

SUPERIOR DEMOLITION LANDFILL


MOCCASIN MIKE ROAD

LEACHATE FORCE MAIN

REPLACEMENT PROJECT

INDEX OF SHEETS

SHEET NO. 1	TITLE SHEET
SHEET NO. 2	DETAILS
SHEET NO. 3	PLAN & PROFILE
SHEET NO. 4	PLAN & PROFILE
SHEET NO. 5	PLAN & PROFILE
SHEET NO. 6	PLAN & PROFILE
SHEET NO. 7	PLAN & PROFILE
SHEET NO. 8	PLAN & PROFILE
SHEET NO. 9	PLAN & PROFILE
SHEET NO. 10	PLAN & PROFILE
SHEET NO. 11	PLAN & PROFILE

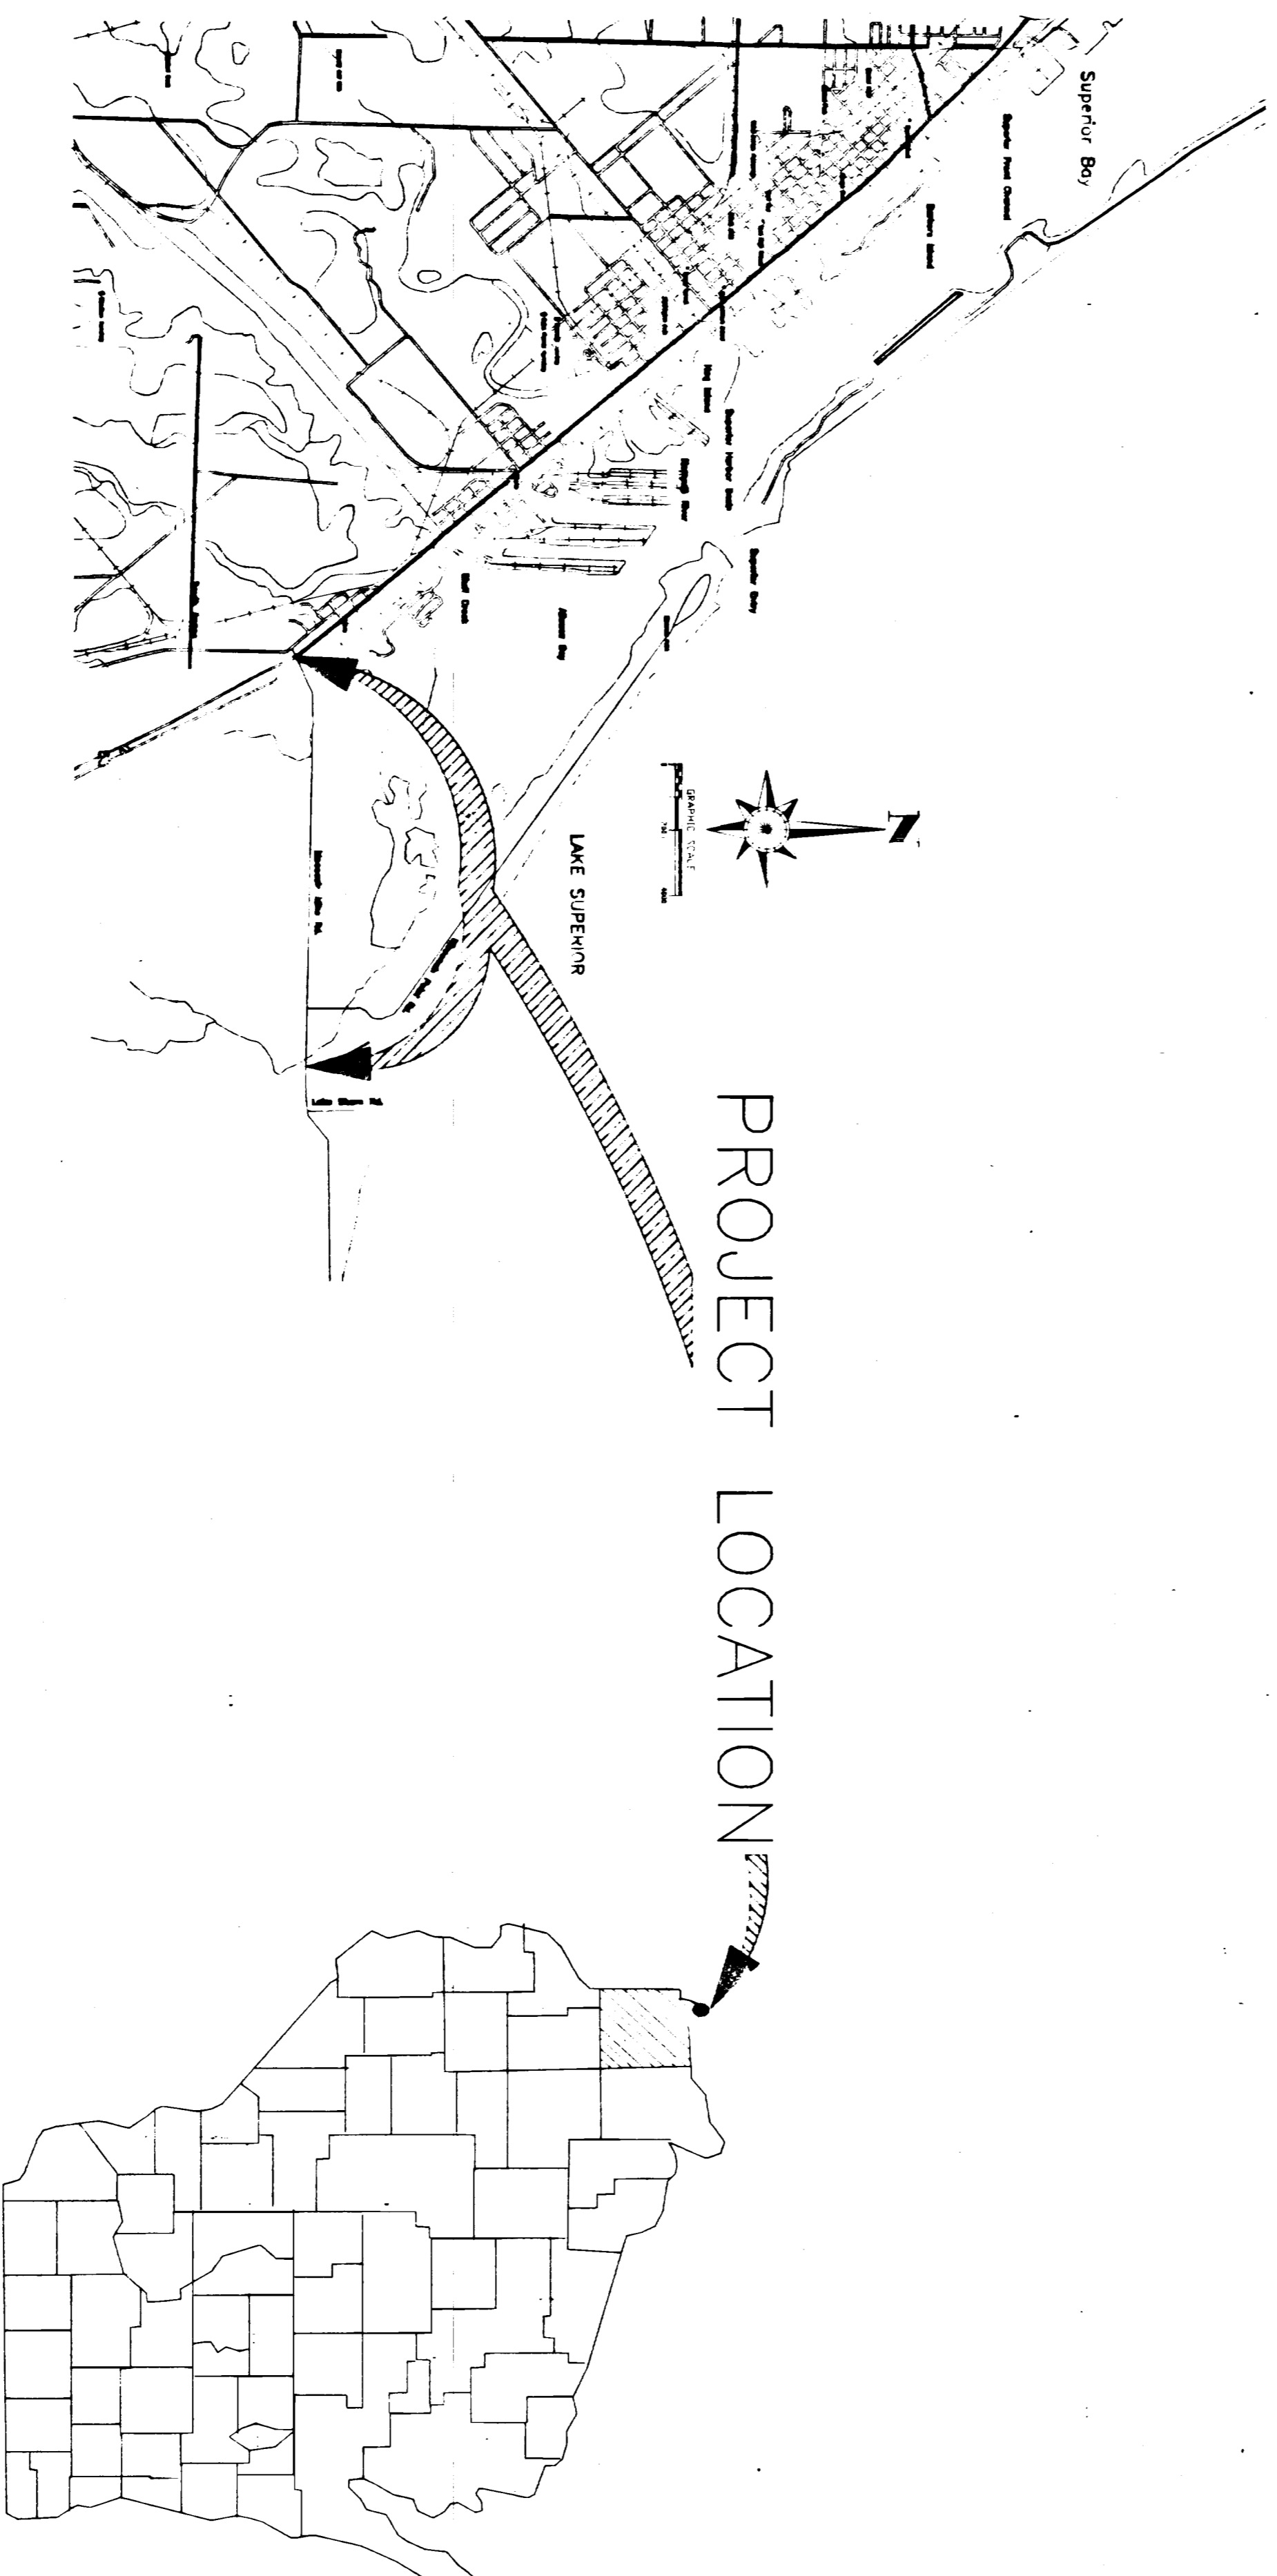

PROJECT LOCATION

RECORD DRAWING
THIS SET OF RECORD DRAWINGS
PRODUCED FROM INFORMATION
PROVIDED BY CITY OF SUPERIOR
PUBLIC WORKS DEPARTMENT

CITY OF SUPERIOR
PUBLIC WORKS DEPARTMENT

APPROVED
DATE :

CITY ENGINEER

PREM, INC. CONSULTING ENGINEERS
SUPERIOR, WISCONSIN
DULUTH, MINNESOTA
I hereby certify that this plan specification, or report was prepared by me or
under my direct supervision and that I am a duly registered professional
Engineer under the laws of the state of WISCONSIN.
Name: William A. Kelly
Date: 6/21/91 Reg. No. 36244

TITLE SHEET

SHEET NO. 1 OF 11 SHEETS