

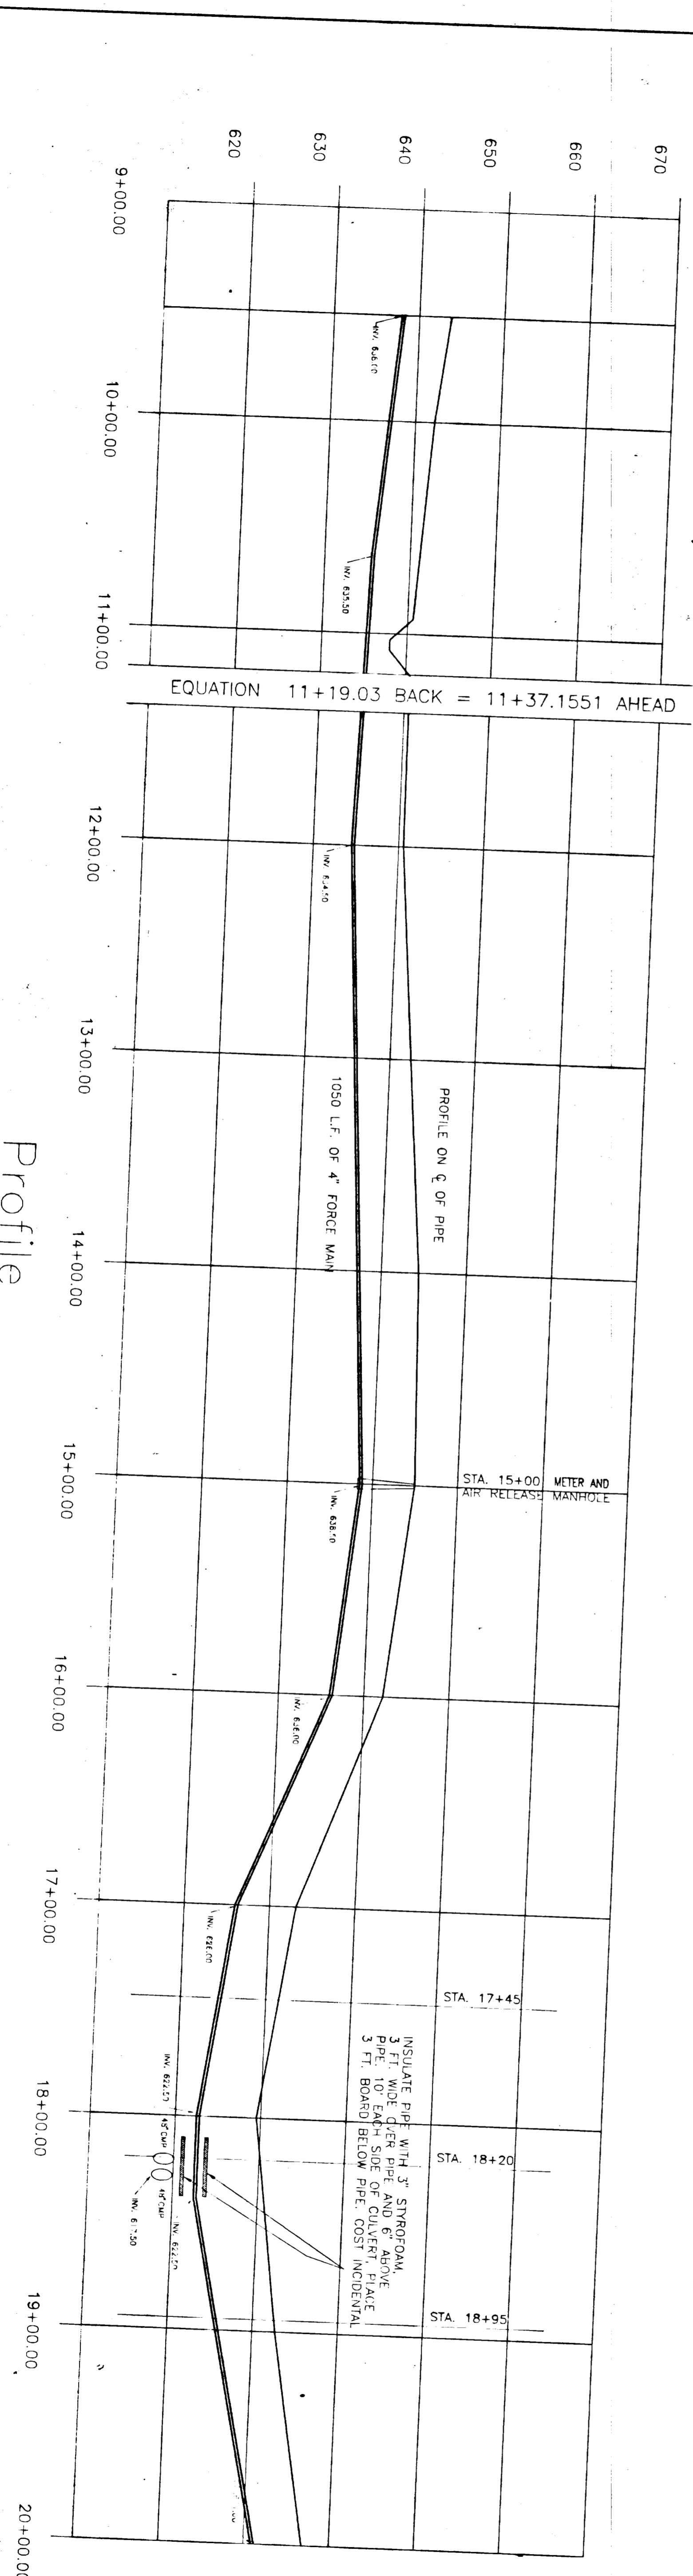


RRM CONSULTING ENGINEERS
 2000 UNIVERSITY DRIVE, SUITE 100
 WASHINGTON, DC 20004
 DESIGNED BY: JMS
 CHECKED BY: JMS
 DATE: 7/26/92
 REVISION: 1

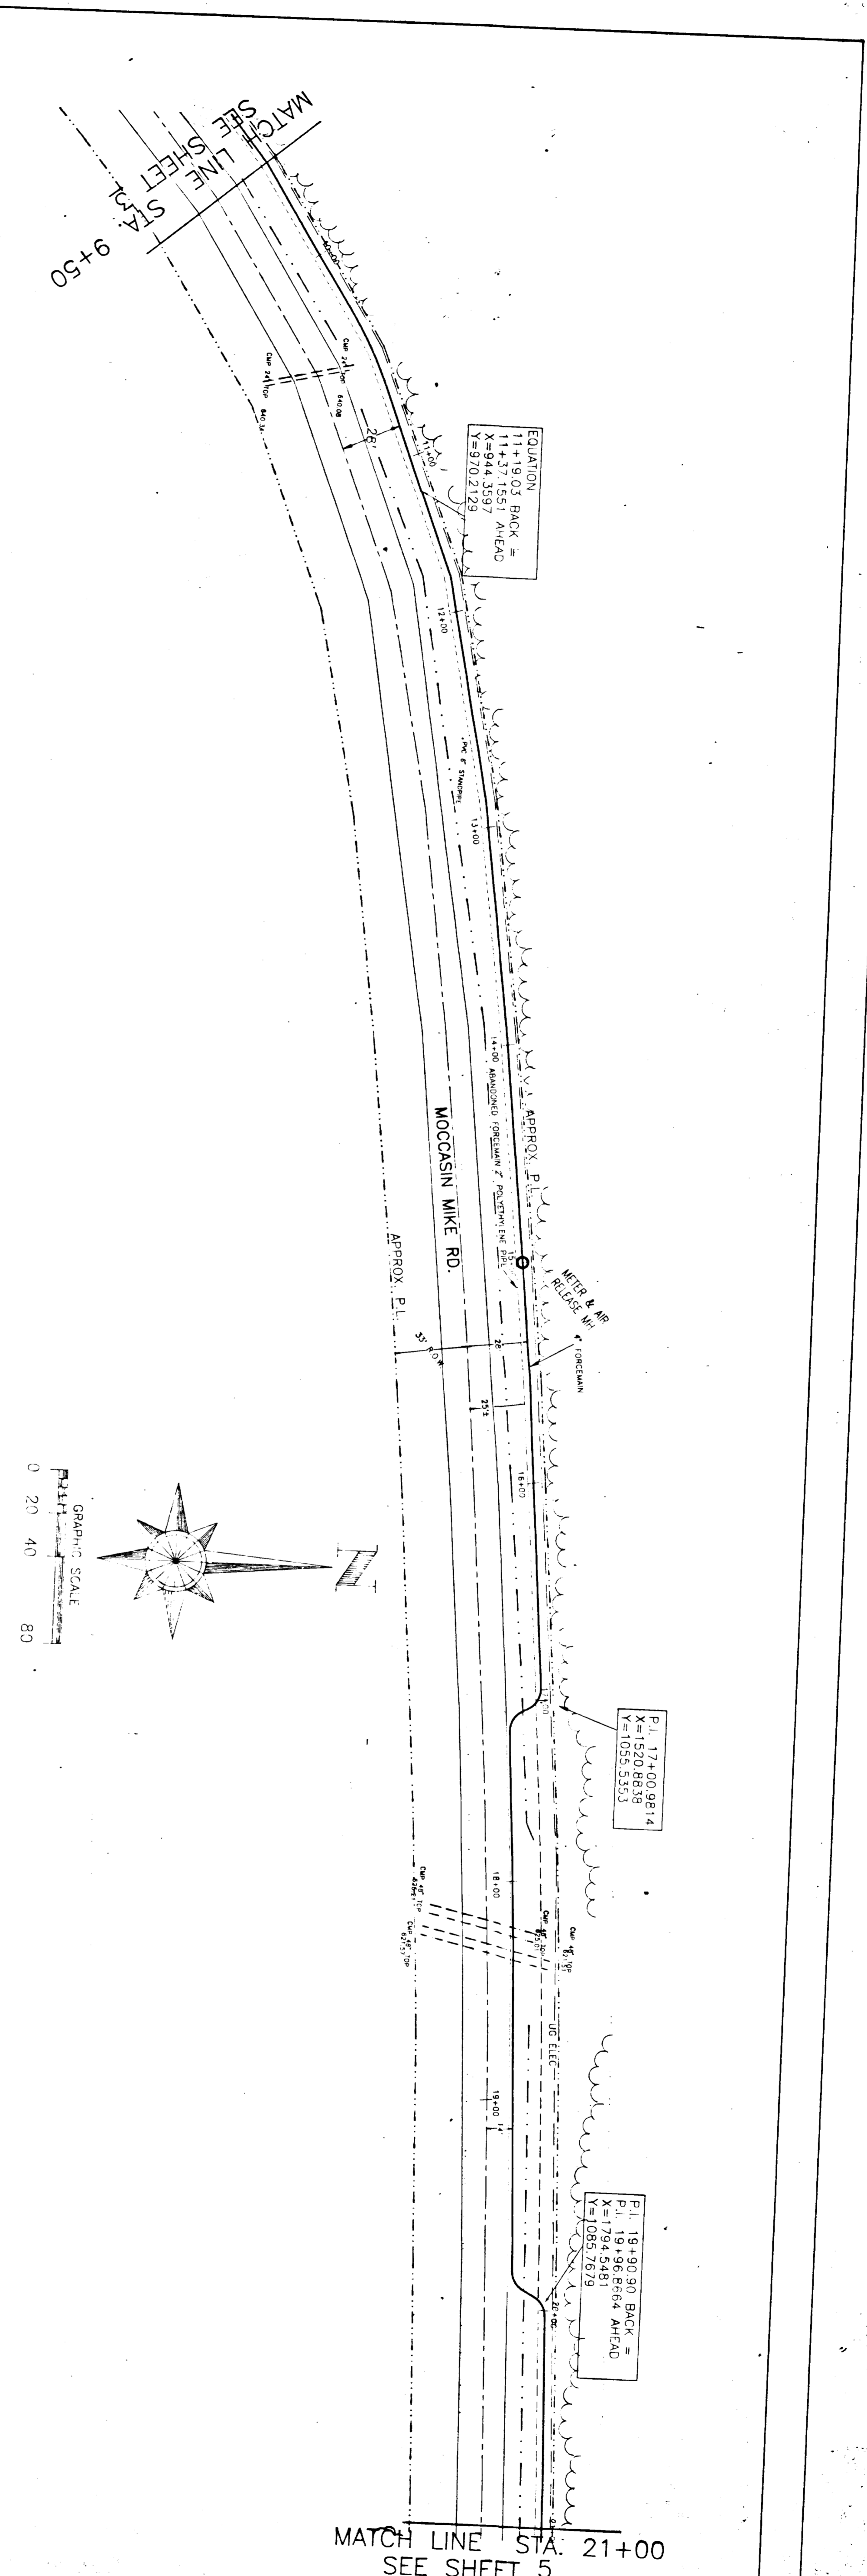

EQUATION 11+19.03 BACK = 11+37.1551 AHEAD

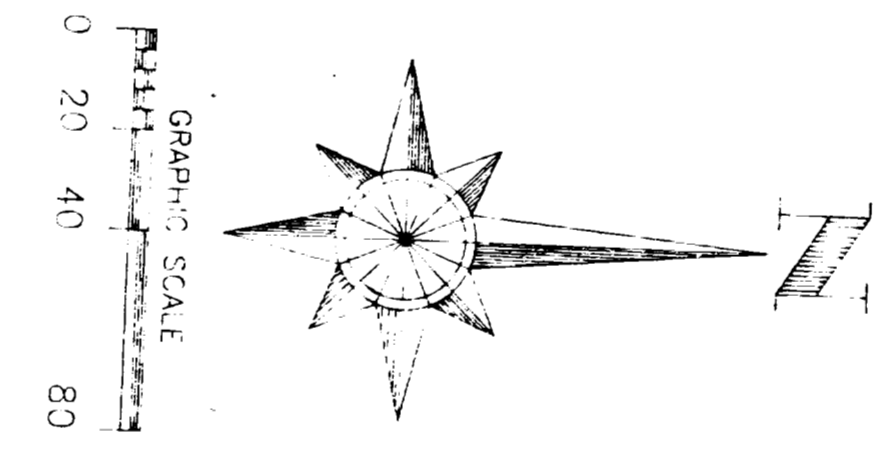

MATCH LINE STA. 21+00
 SEE SHEET 5

RECORD DRAWING