

MATCH LINE STA. 21+00  
 SEE SHEET 4


BM 10  
 646.22  
 19+96.8664  
 N. 50E  
 100.00

UNDERGROUND TELE. CABLE  
 4" FORCE MAIN  
 2" POLYETHYLENE PIPE  
 12" DUCT


MOCCASIN MIKE RD.

29+81.8521  
 X=2723.0060  
 Y=1156.5928

MATCH LINE STA. 31+00  
 SEE SHEET 6

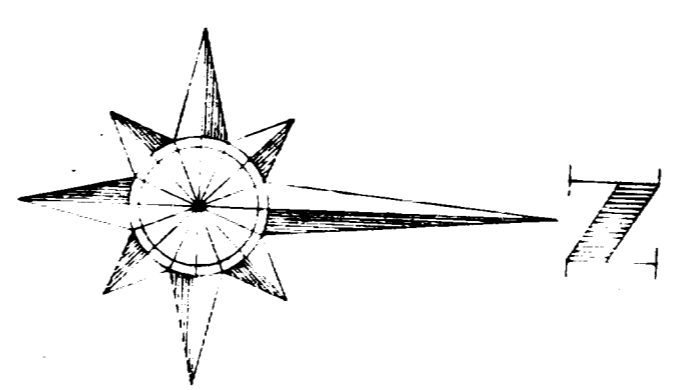

GRAPHIC SCALE  
 0 20 40 80

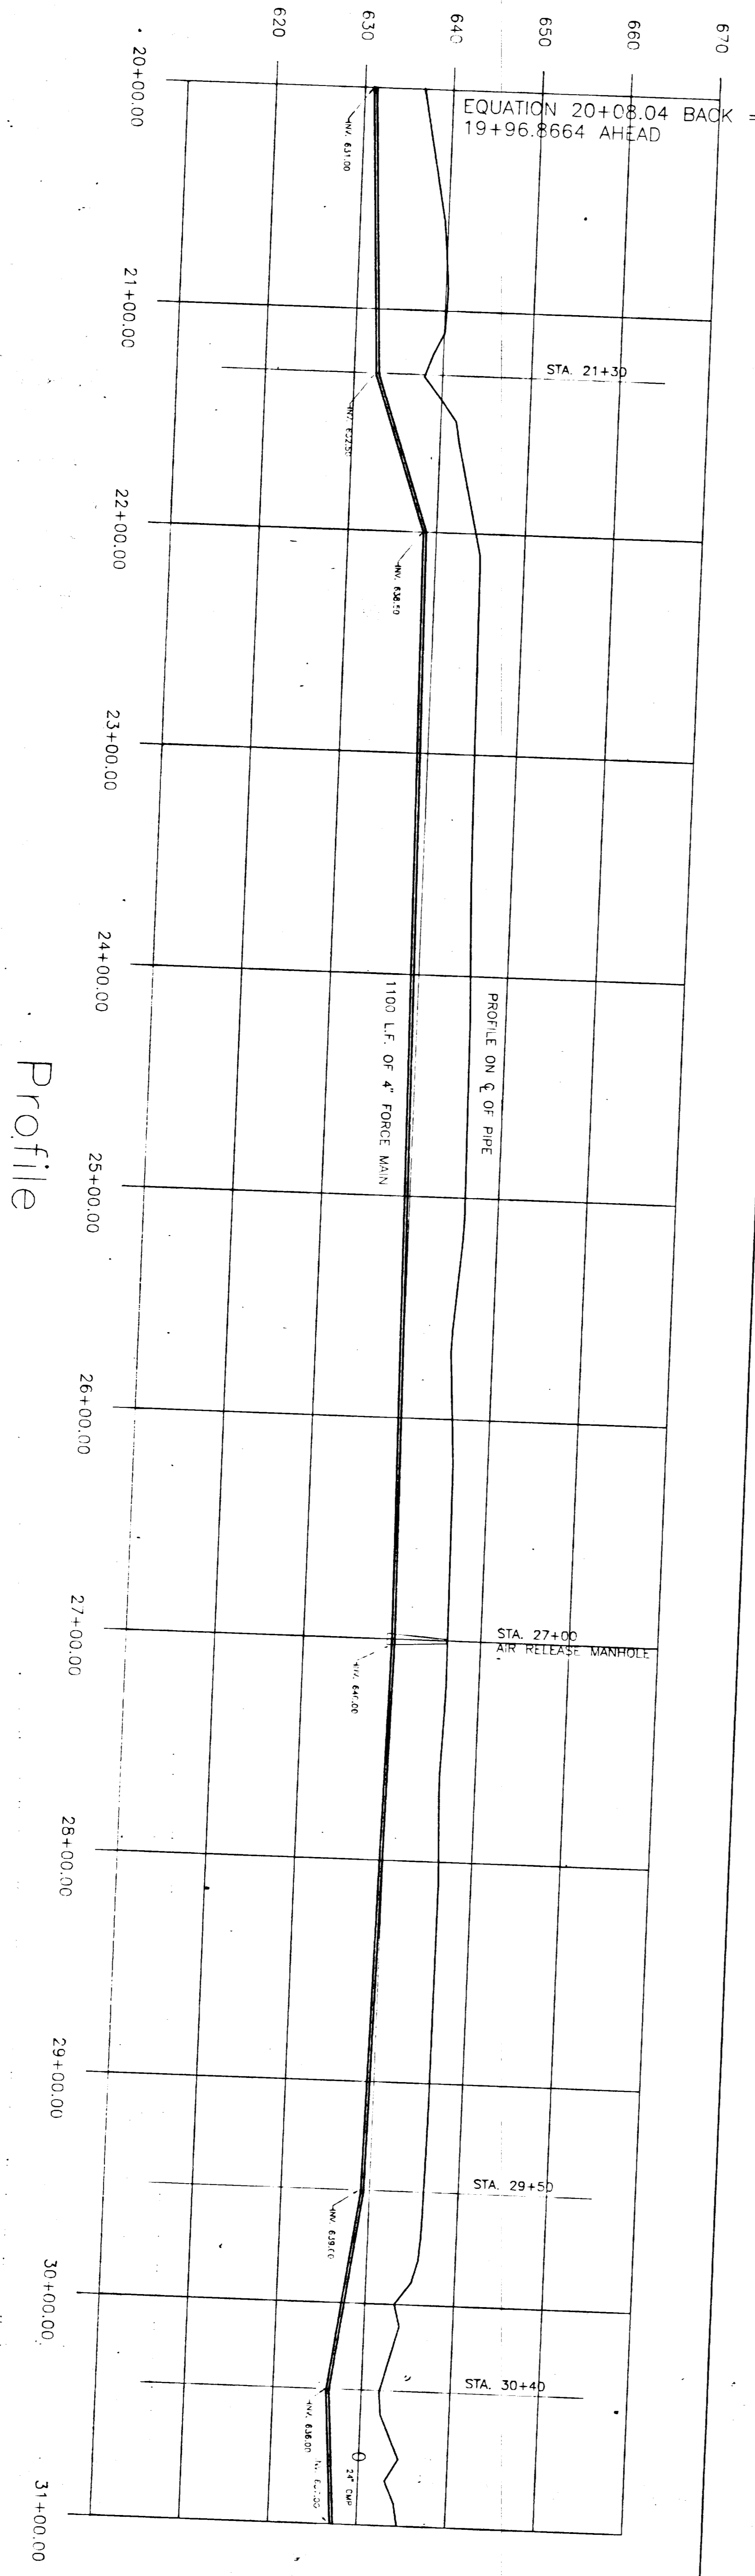

Profile

PREM ENGINEERING  
 CHECKED BY: [Signature]  
 DATE: 2/28/99

RECORD DRAWING