

PREM CONSULTING ENGINEERS
 1100 L.F. OF 4" FORCE MAIN


DESIGNED BY: J.C.
 DRAWN BY: J.P.
 NO. 1
 REVISION TO RECORD DRAWING
 DATE: 2/26/92

PROJECT NO. 9105
 SHEET NO. 6 OF 11


RECORD DRAWING

Sheet No. 6 of 11 Sheets



Profile

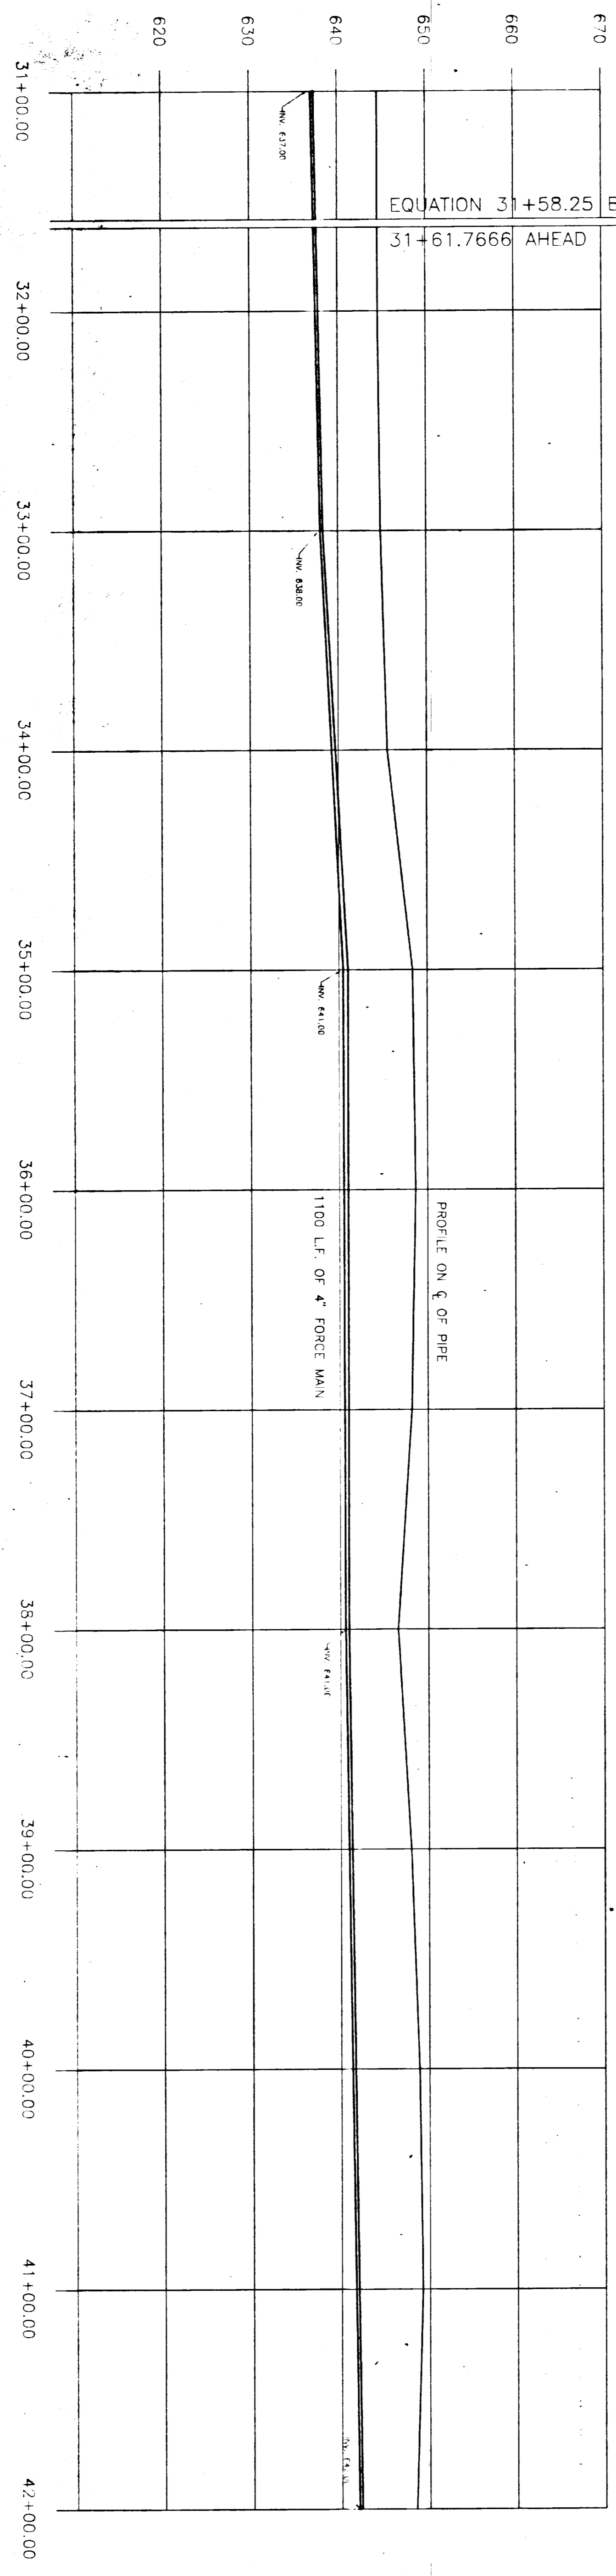

MATCH LINE STA. 31+00
 SEE SHEET 5

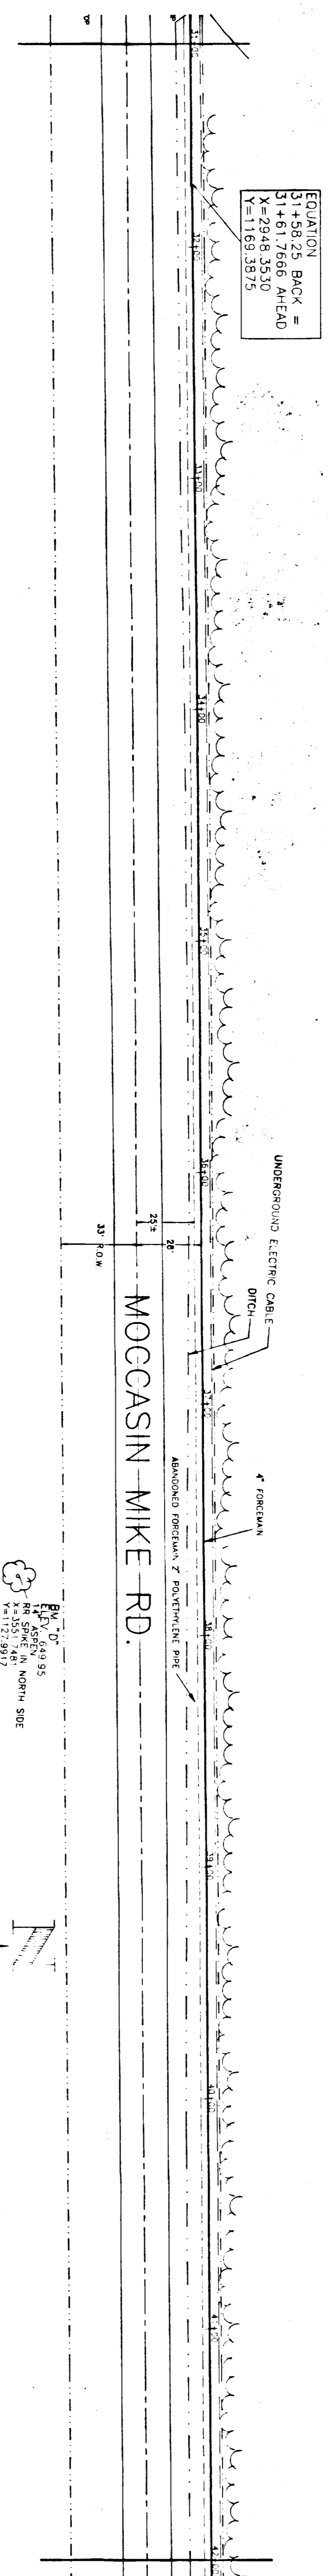

BY: J.C.
 DATE: 2/26/92
 PROJECT NO. 9105
 SHEET NO. 6 OF 11

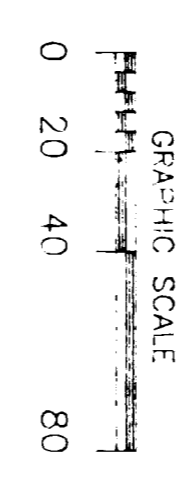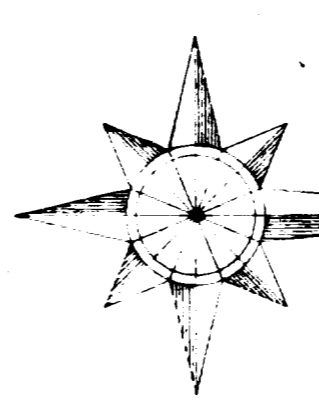

MATCH LINE STA. 42+00
 SEE SHEET 7