



MATCH LINE STA. 64+00
 SEE SHEET 8

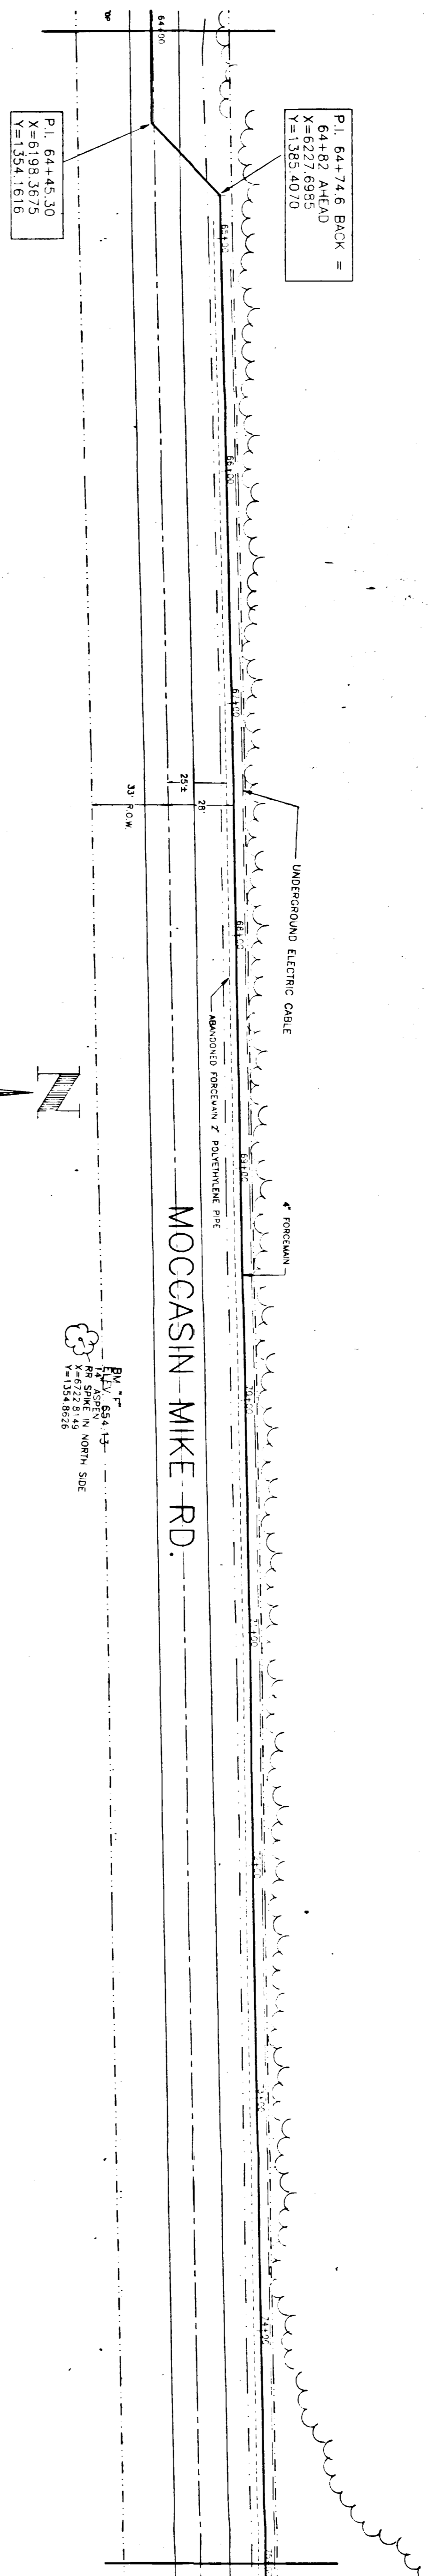

MATCH LINE STA. 75+00
 SEE SHEET 10

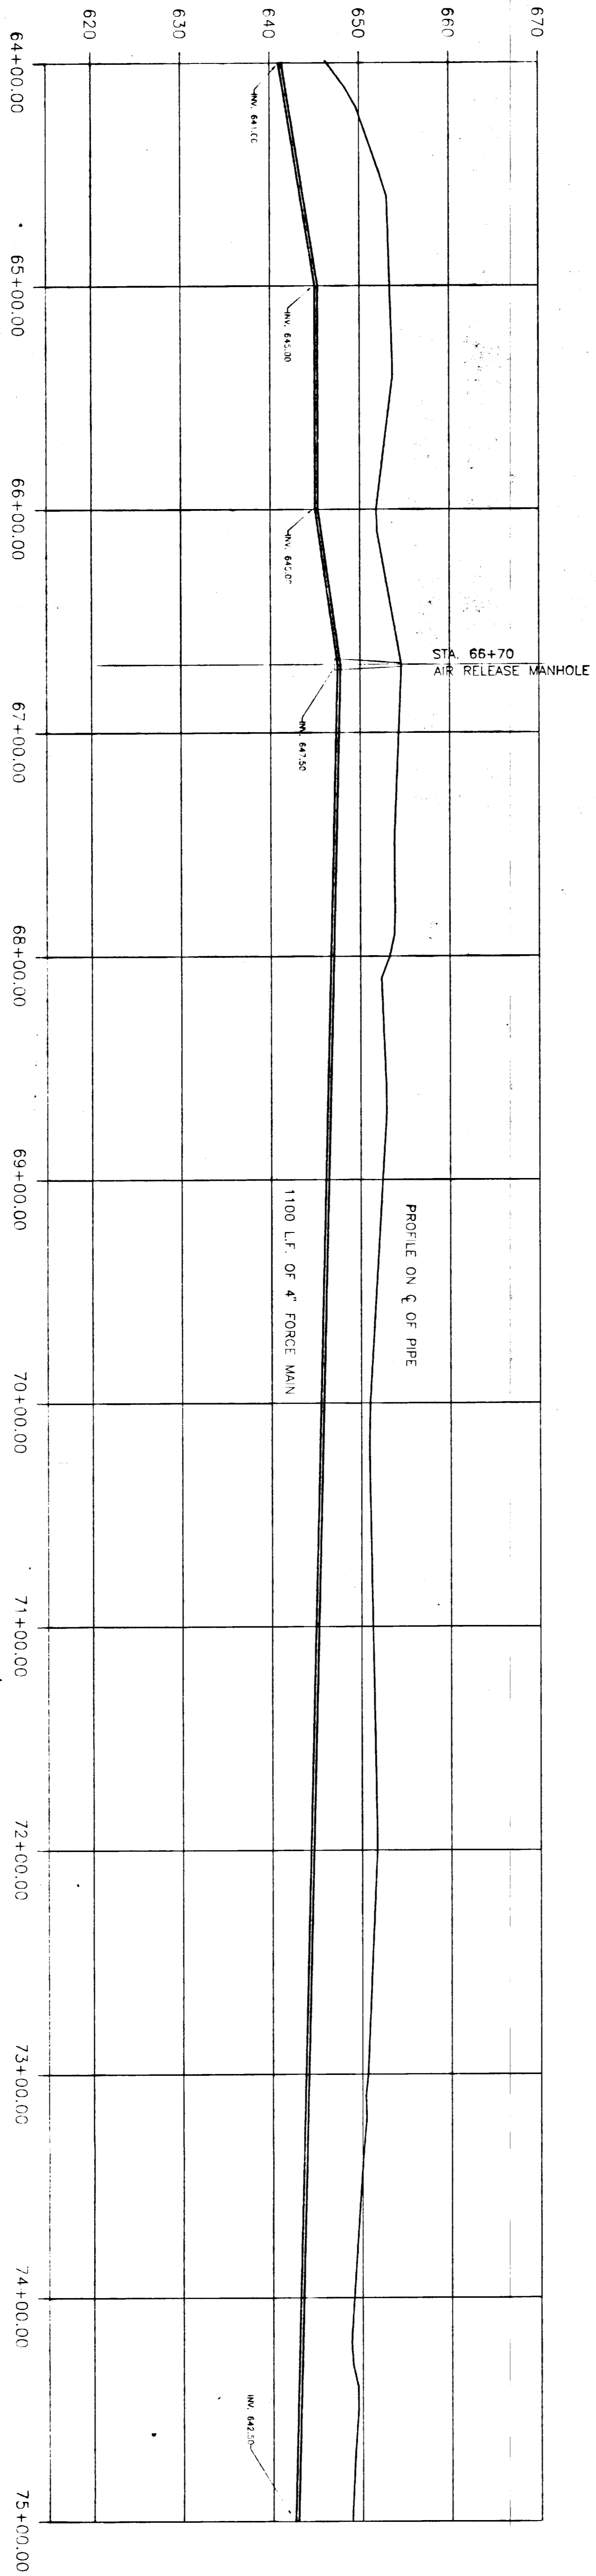

Profile

RECORD DRAWING

	DESIGNED BY	1	REVISION TO RECORD DRAWING	2/26/91
	CHECKED BY	NO	REVISION	DATE