

**PREM** CONSULTING ENGINEERS  
 1000 W. 10th St., Suite 100  
 Oklahoma City, Oklahoma 73101  
 Phone: (405) 233-8800  
 Fax: (405) 233-8801  
 Website: www.prem-engineers.com


Designed By: J.E.P.  
 Checked By: M.W.S.  
 Date: 6/26/94

1  
 1.0  
 REVISION TO RETURN DRAWING  
 REVISION DATE


Sheet No. 10 of 11 Sheets

**RECORD DRAWING**


Profile

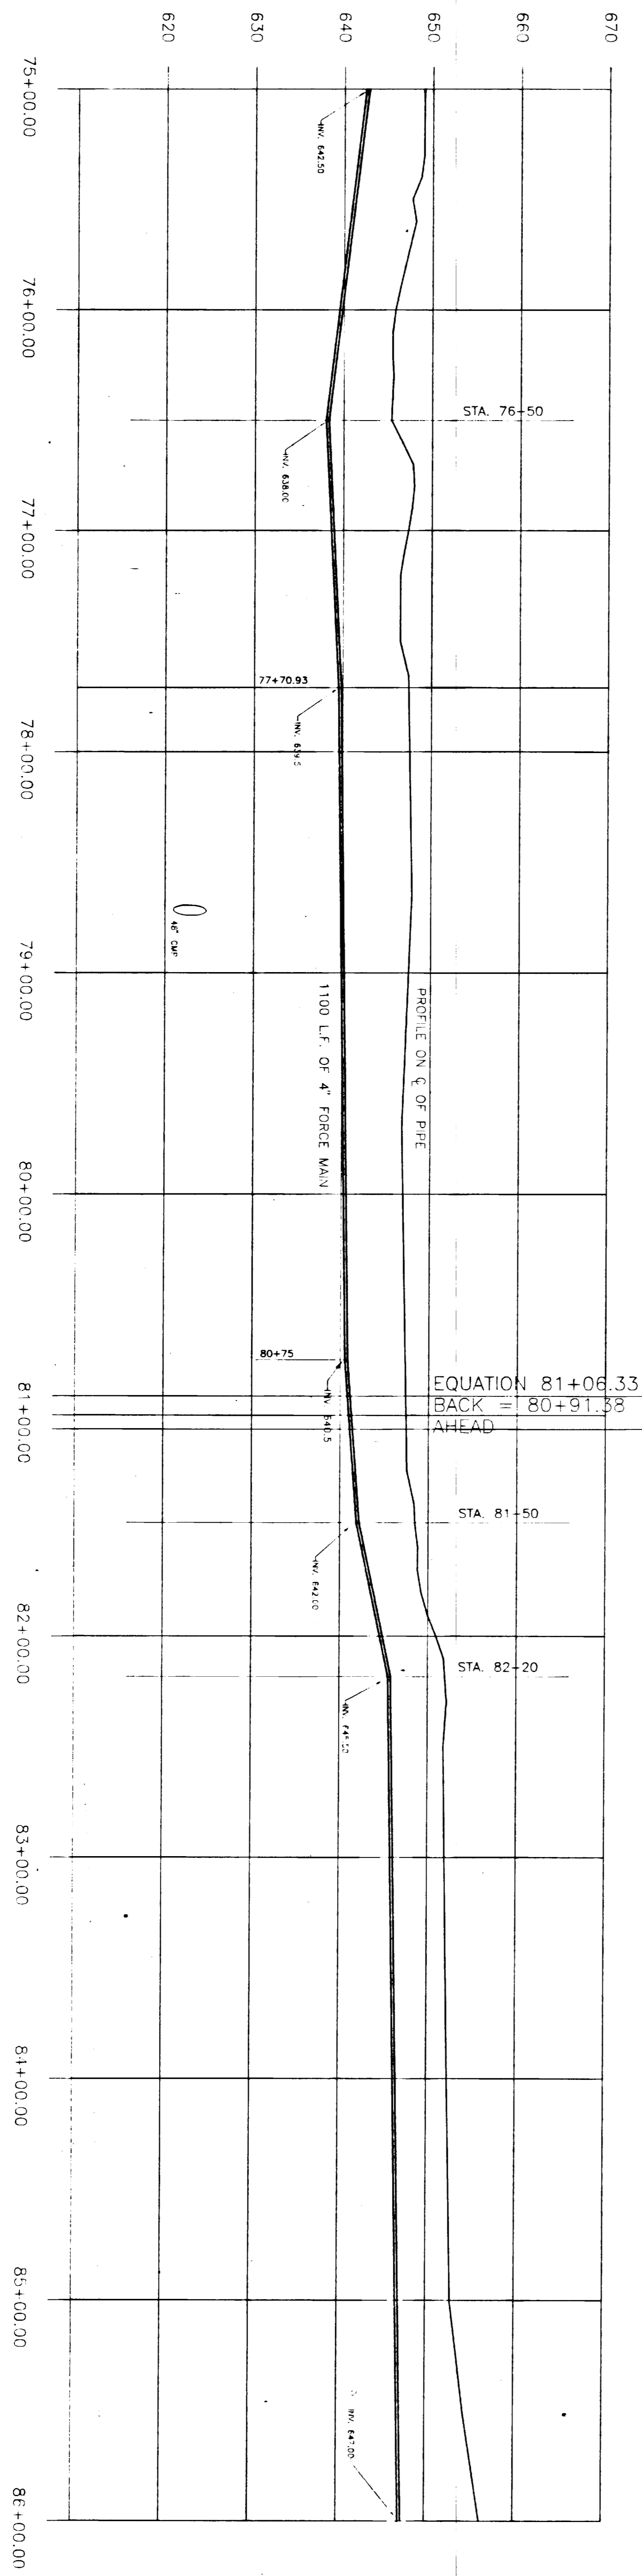

MATCH LINE STA. 75+00  
 SEE SHEET 9

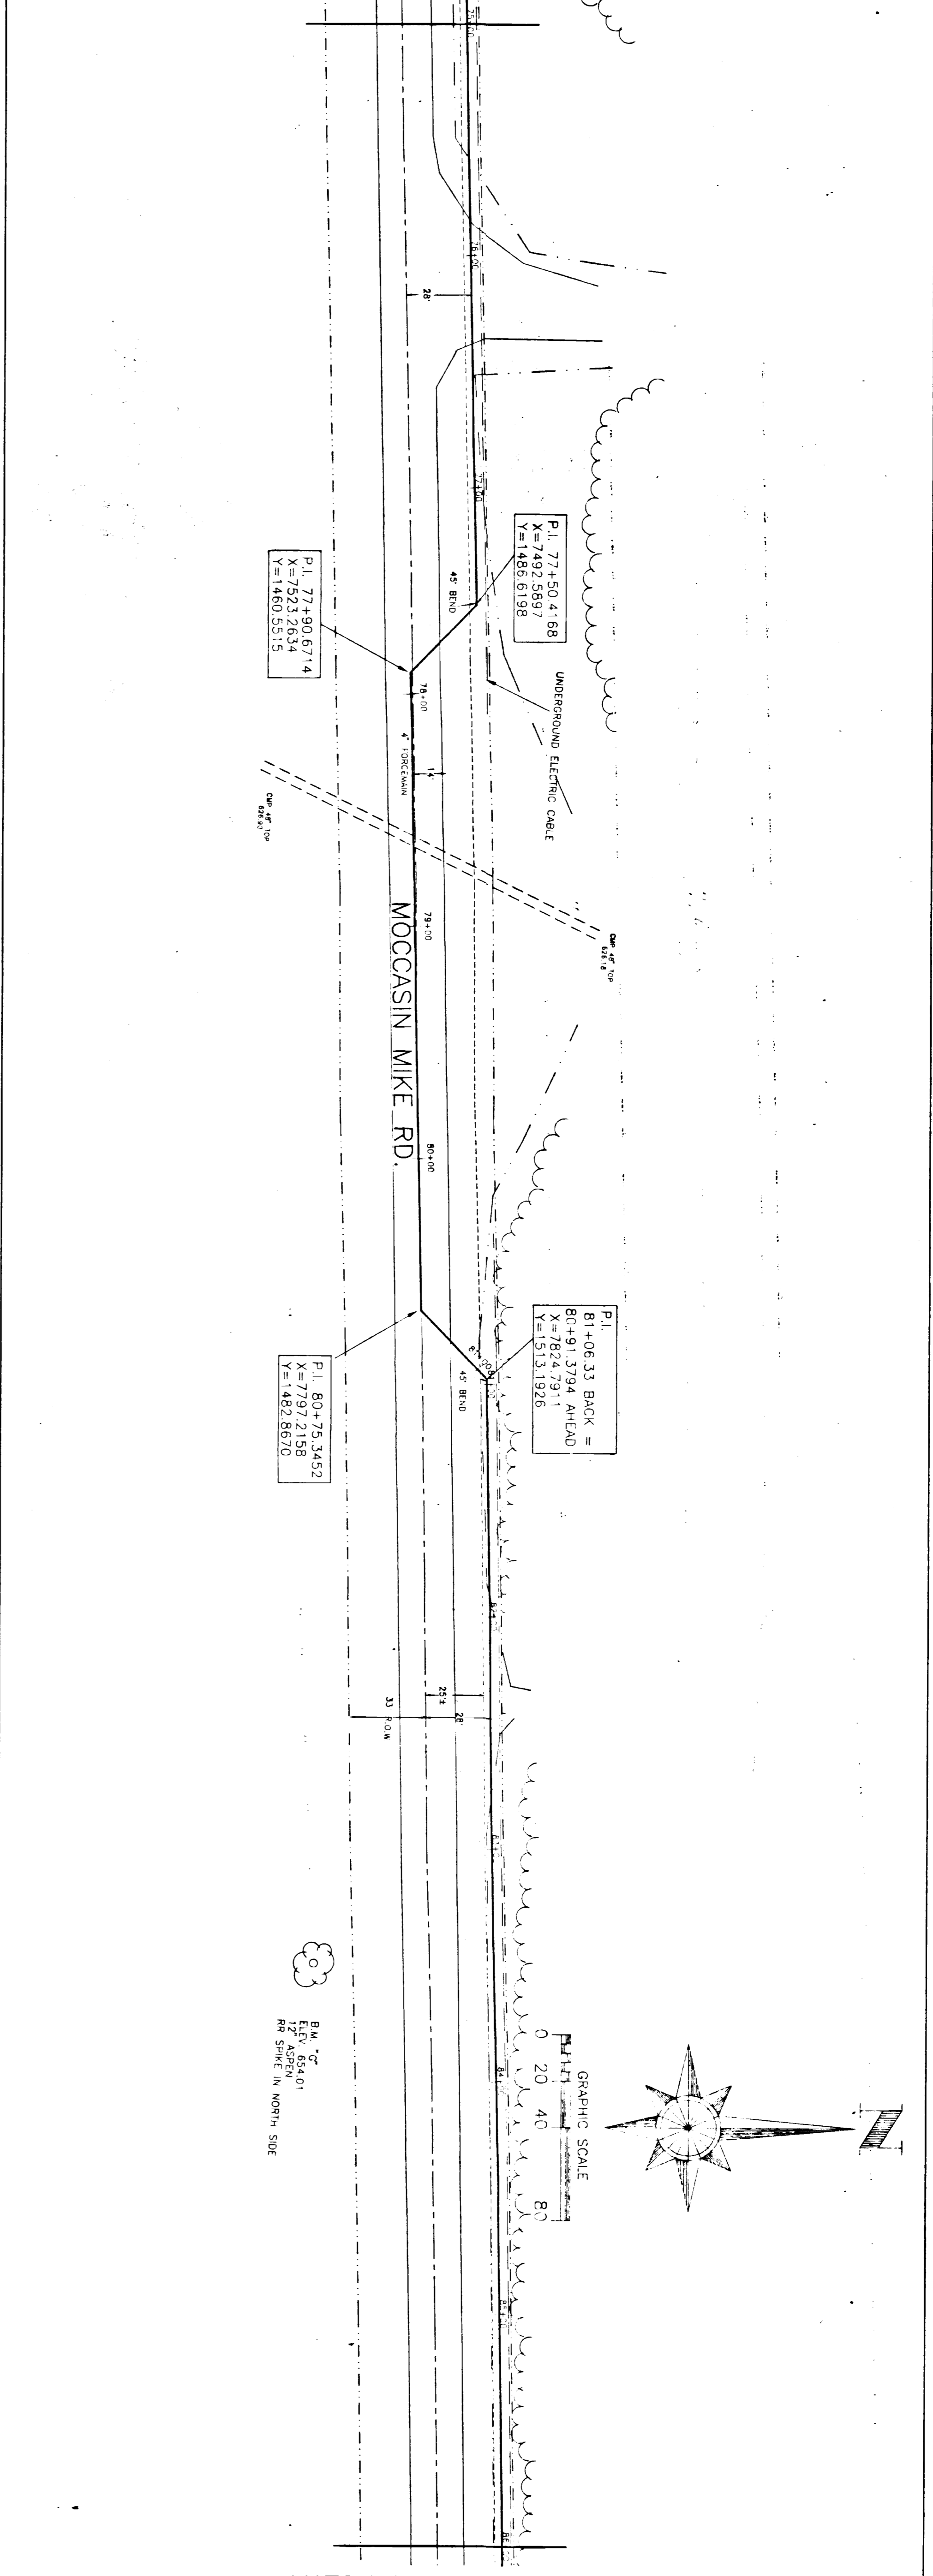

MATCH LINE STA. 86+00  
 SEE SHEET 11

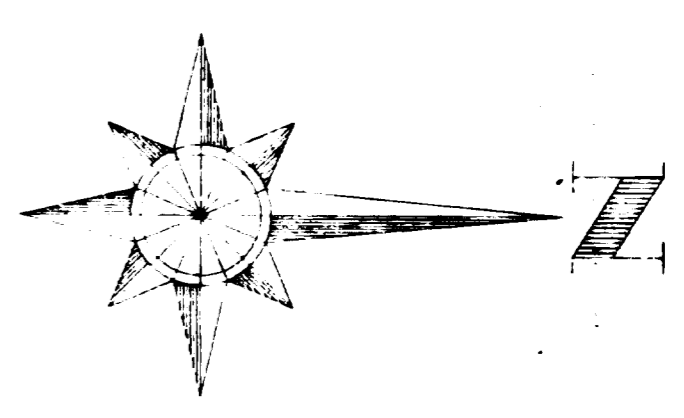

GRAPHIC SCALE  
 0 20 40 80  
 FEET

B.M. 7C  
 ELEV. 654.01  
 RE. SPOT IN NORTH SIDE