


OGDEN AVE.

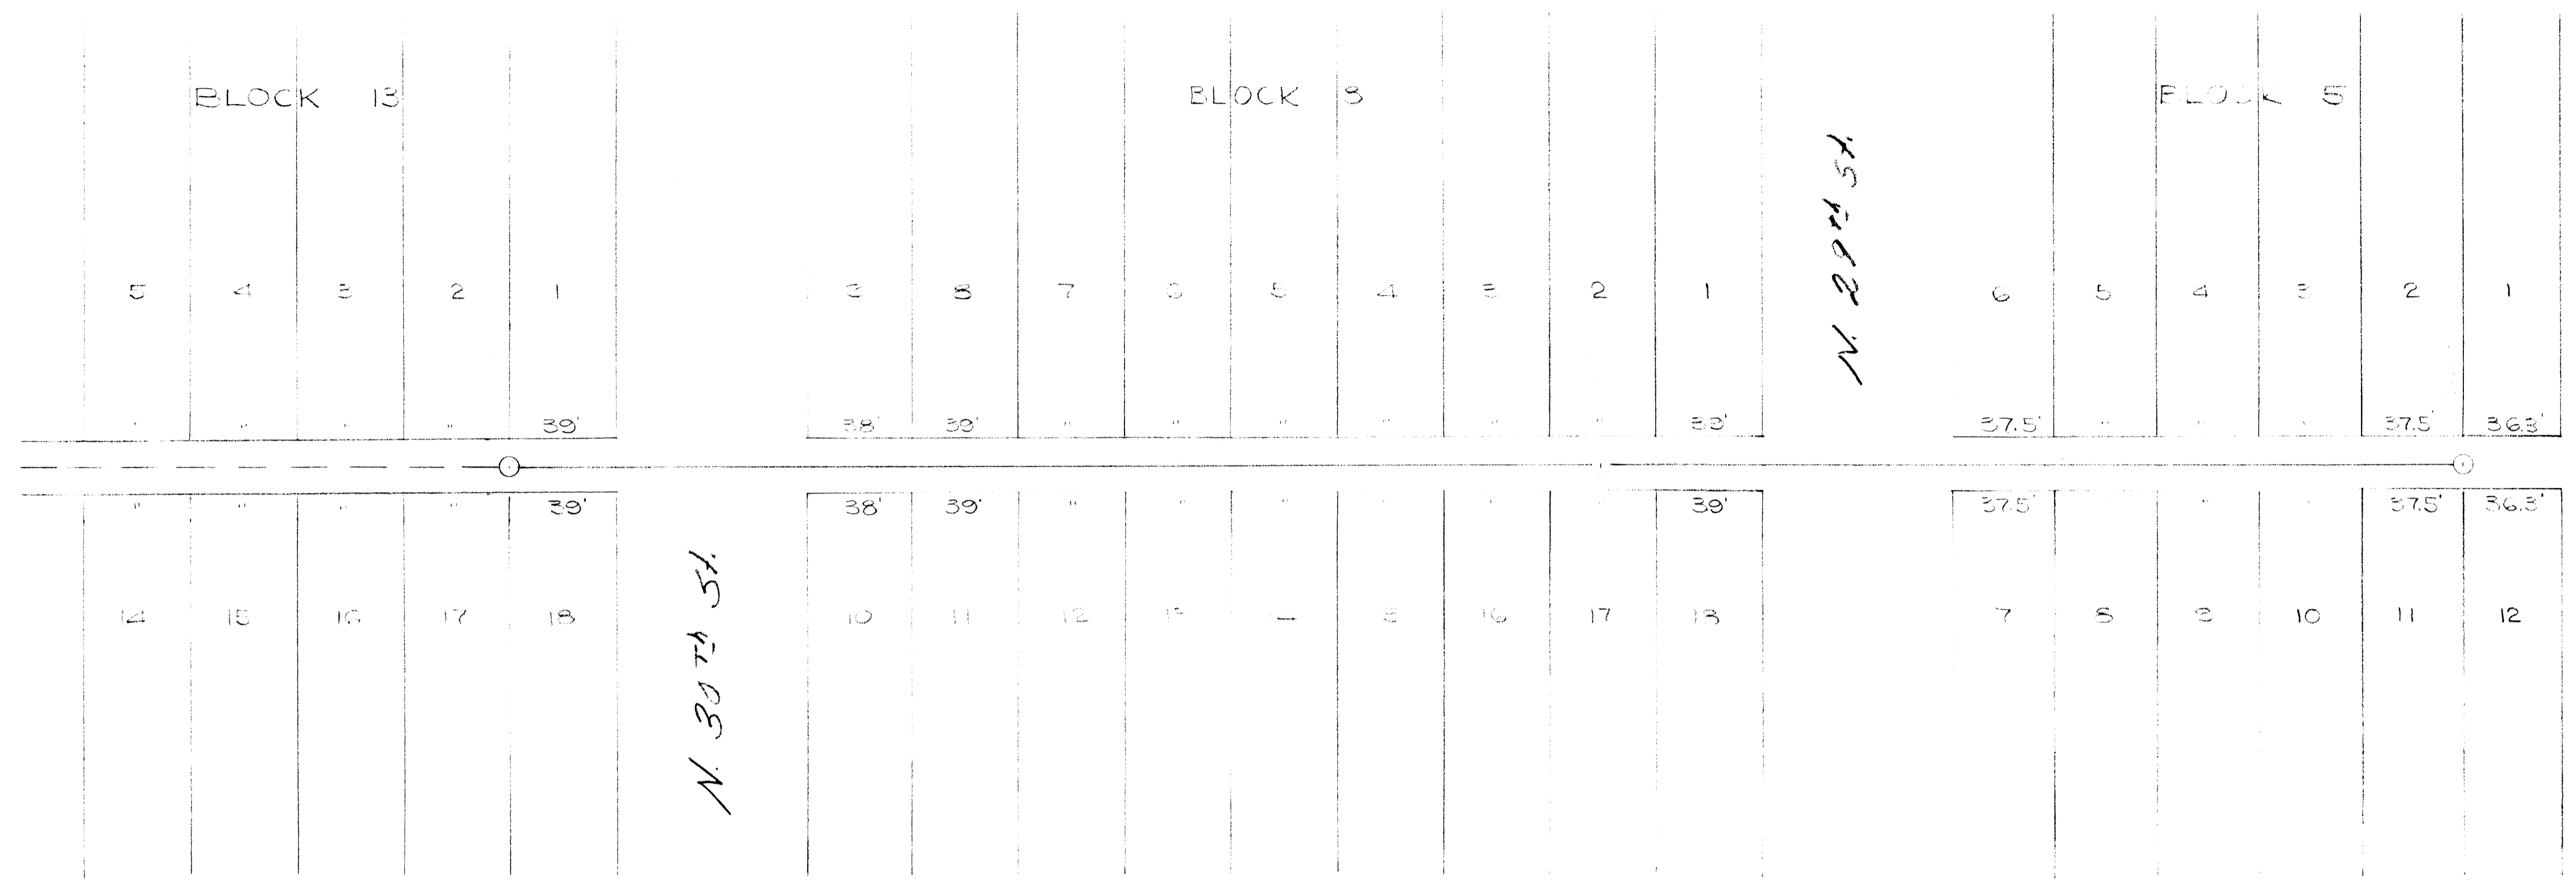


Uls. from M.H. on 21st St. between Ogden + John as bench Mark - 656.43

JOHN AVE.

Note: See Revised Print

1" = 40' Hor  
1" = 5' Vert

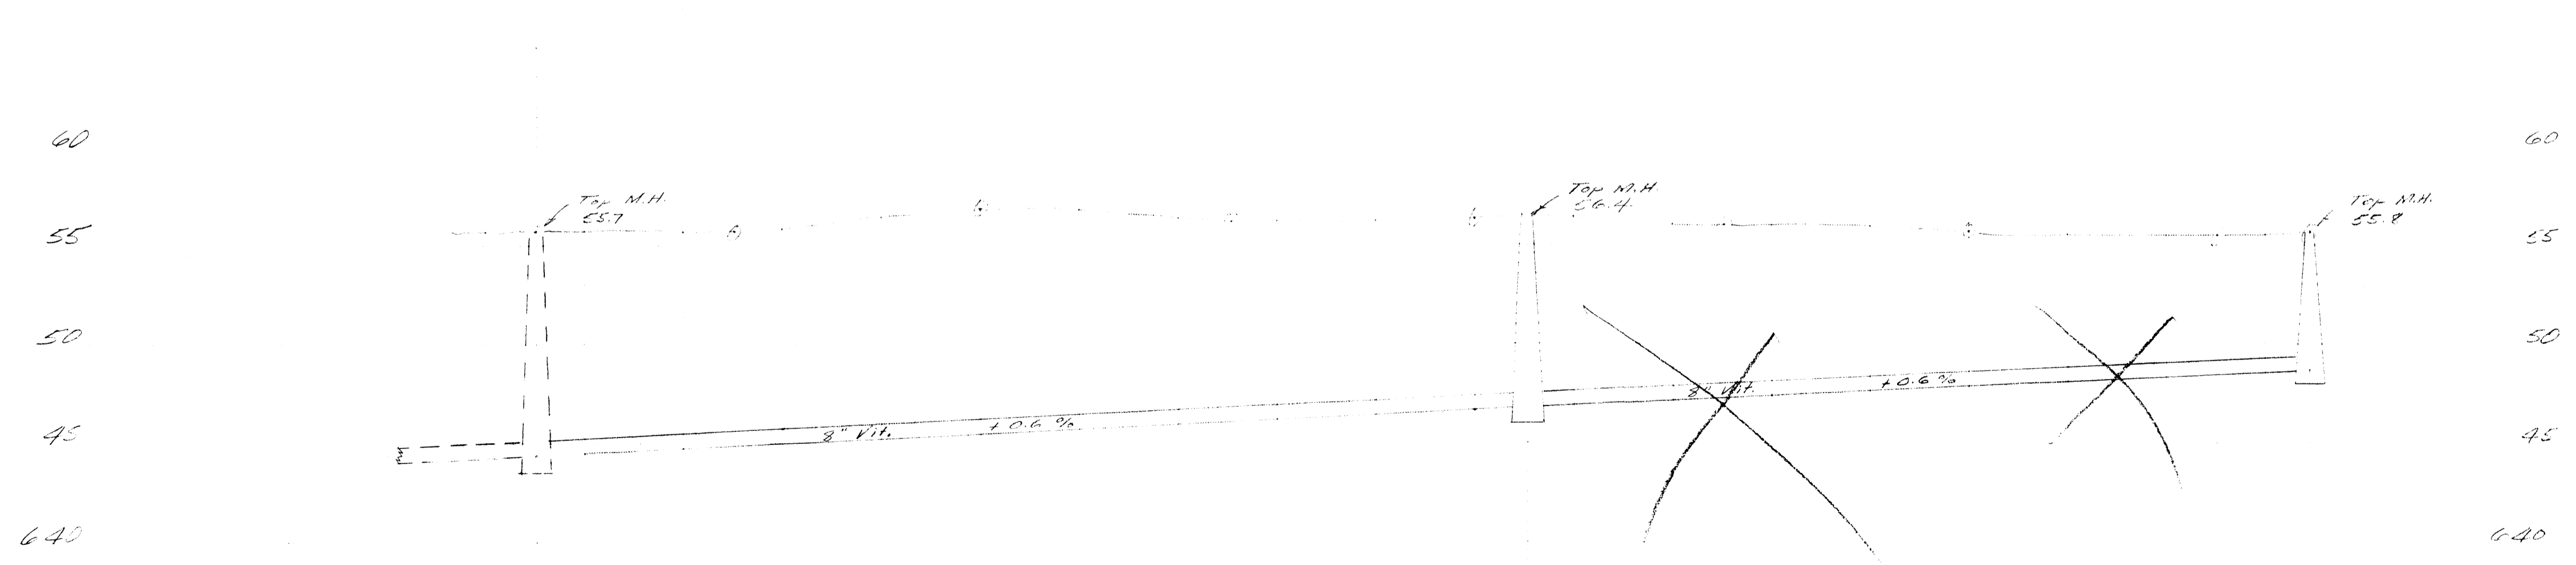

- 6) 55.7 44.30
- 7) 57.25 44.82
- 8) 56.8 45.43
- 9) 56.2 46.02
- 10) 56.3 46.63
- 11) 56.0 47.22
- 12) 55.7 47.82
- 13) 55.5 48.42
- 14) 55.7 49.04