


PLAN SURVEYED BY DATE
 PLOTTED BY
 CHECKED BY
 NOTE BOOK NO. OF WAY CHECKED
 NO.


BENCH MARKS			
NO.	STA.	DESCRIPTION	ELEV.
1		680 MON. #2834-72, E. SIDE LAMBORN AVE. ON POLE LINE S. OF 28th ST.	648.211
2		680 MON. #2794-13, S.W. COR. 31ST & HAMM.	650.985

REVISED 5-8-59

Revised 5-8-59

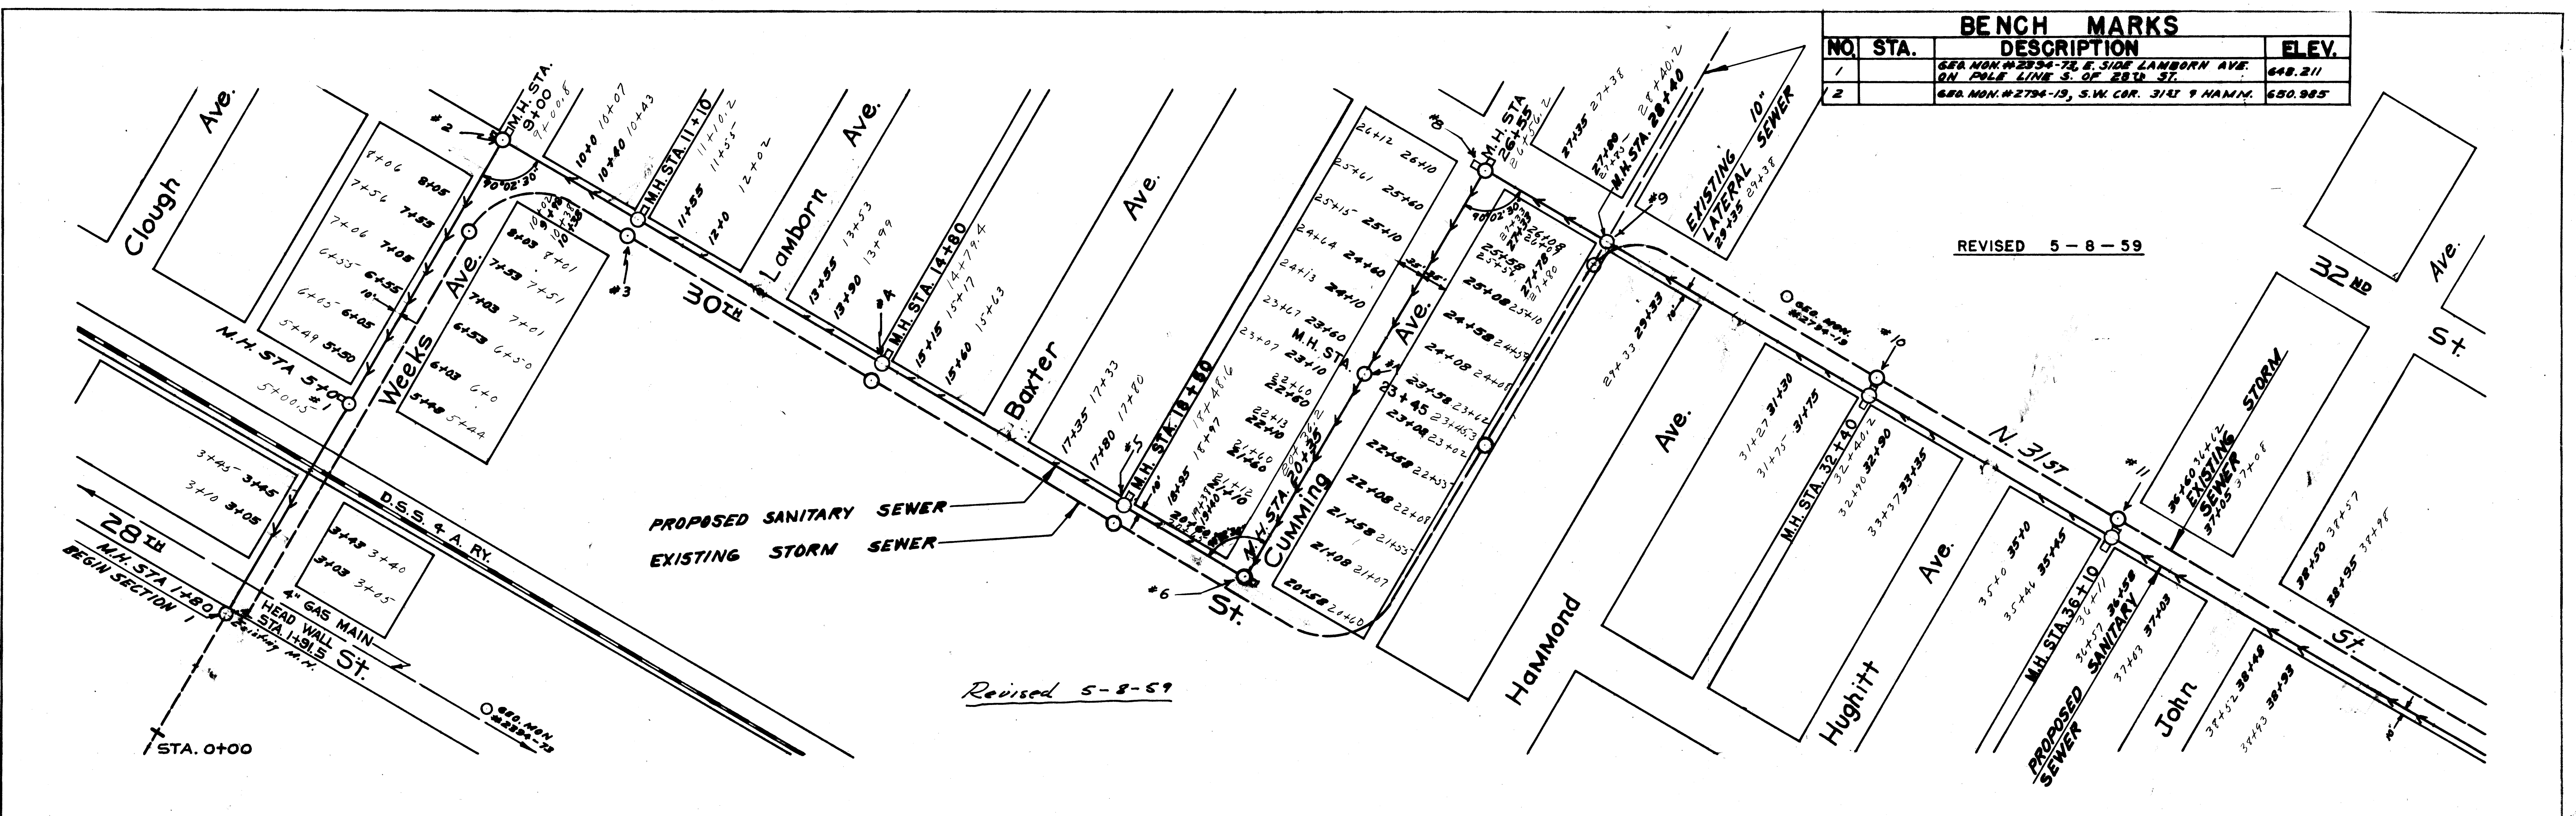

DATE
 SURVEYED BY
 PLOTTED BY
 CHECKED BY
 NOTE BOOK NO. OF WAY CHECKED
 NO.

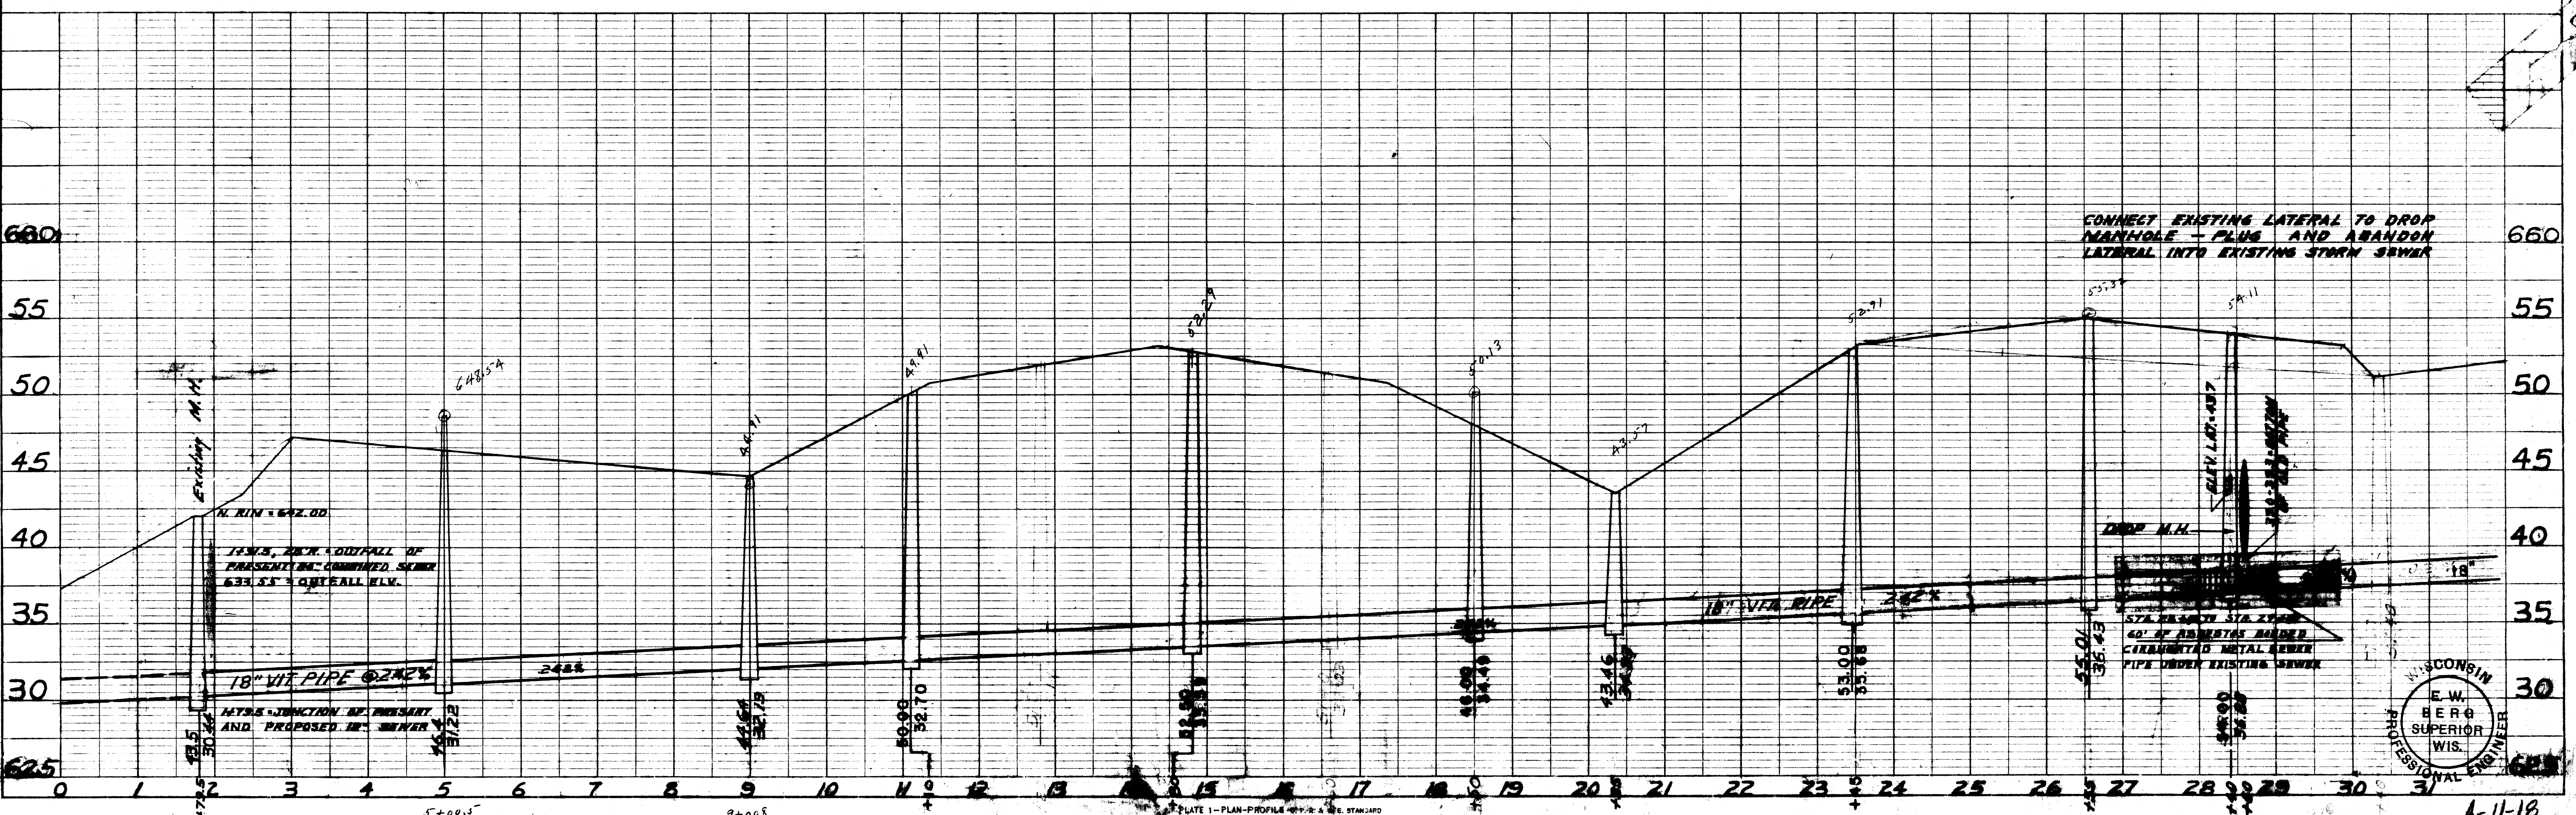

CONNECT EXISTING LATERAL TO DROP MANHOLE - PLUS AND ABANDON LATERAL INTO EXISTING STORM SEWER

WISCONSIN
 E. W. BERG
 SUPERIOR
 WIS.
 PROFESSIONAL ENGINEER

A-11-18