


BENCH MARKS		
NQ STA.	DESCRIPTION	ELEV.
+	660 MON. 2794-25, S.W. COR. 40TH & TOWER	668.835

PLAN
 SURVEYED BY: [Signature]
 DATE: [Date]
 PLOTTED BY: [Signature]
 DATE: [Date]
 NOTE BOOK GRADES CHECKED BY: [Signature]
 NO. [Number]
 STRUCTURE WHAT'S CHECKED BY: [Signature]
 NO. [Number]

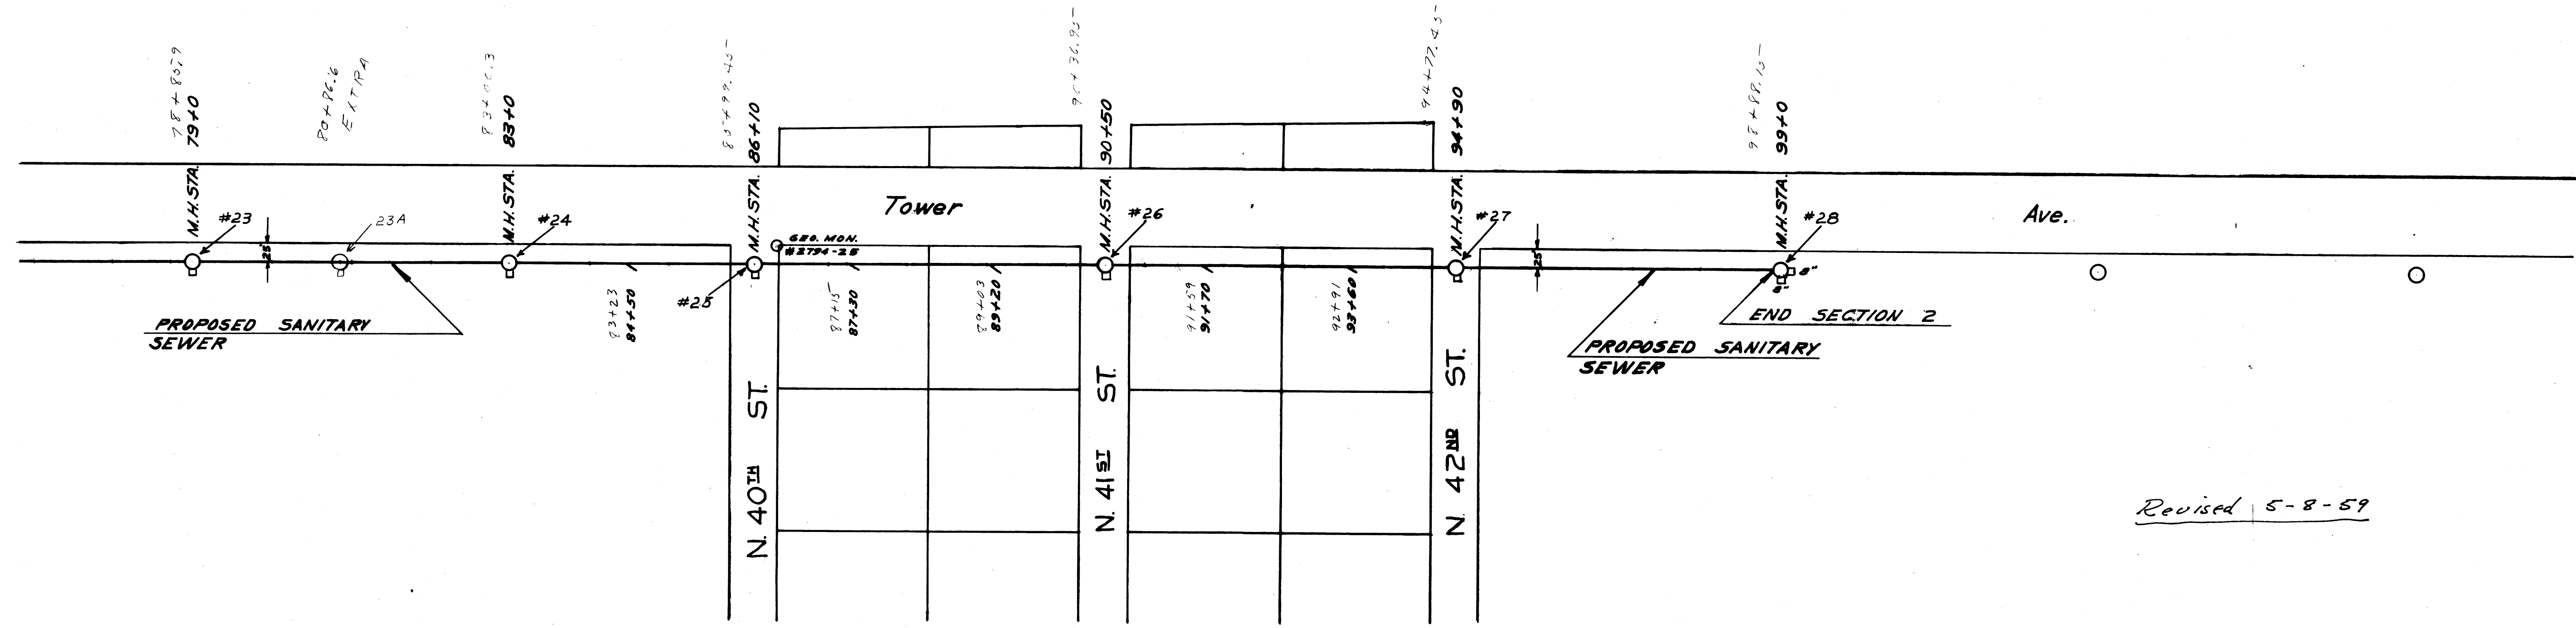

Revised 5-8-59

PROFILE
 SURVEYED BY: [Signature]
 DATE: [Date]
 PLOTTED BY: [Signature]
 DATE: [Date]
 NOTE BOOK GRADES CHECKED BY: [Signature]
 NO. [Number]
 STRUCTURE WHAT'S CHECKED BY: [Signature]
 NO. [Number]

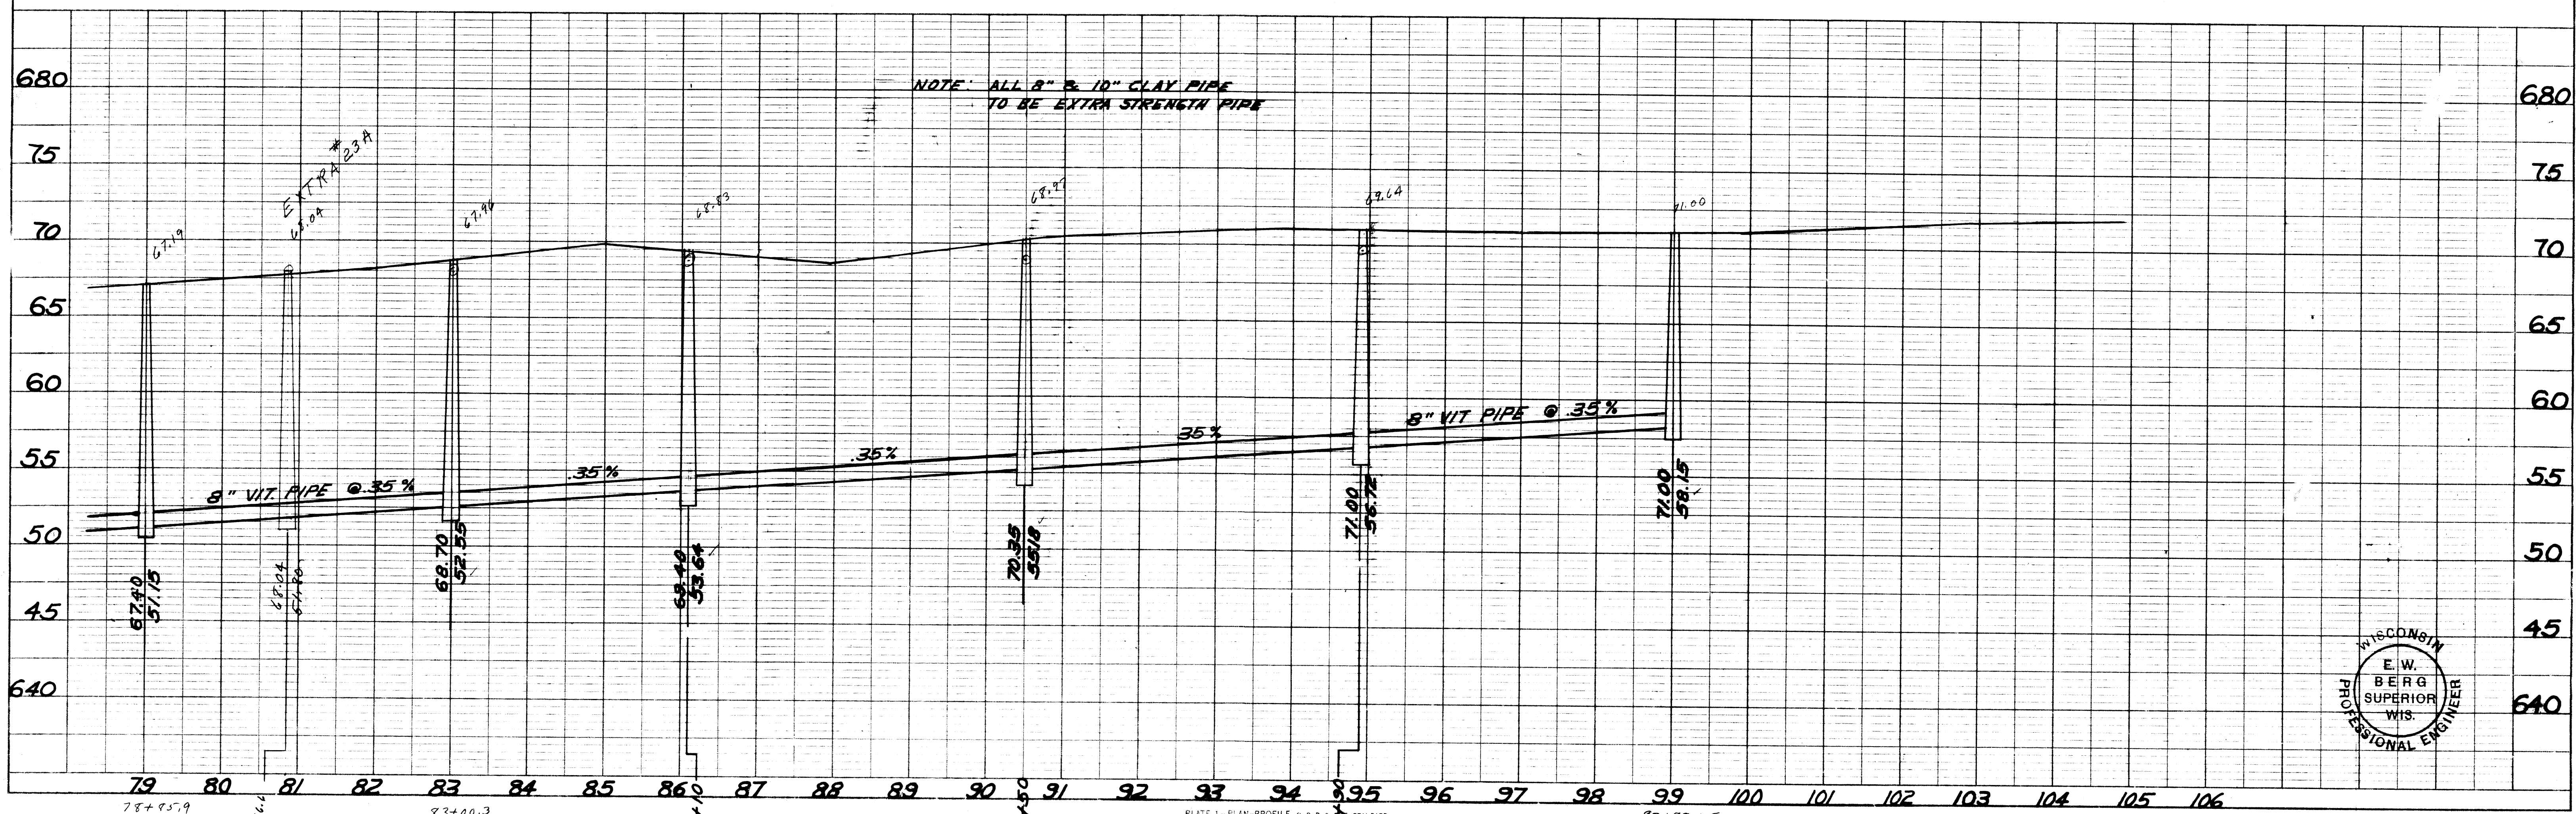


PLATE 1 - PLAN-PROFILE © P. R. & S. STANDARD
 RUFFEL & ESSER CO. INC. 94477.40
 K & E Co. No. 348-1C

