






BAYEAST 2ND ST. ST.

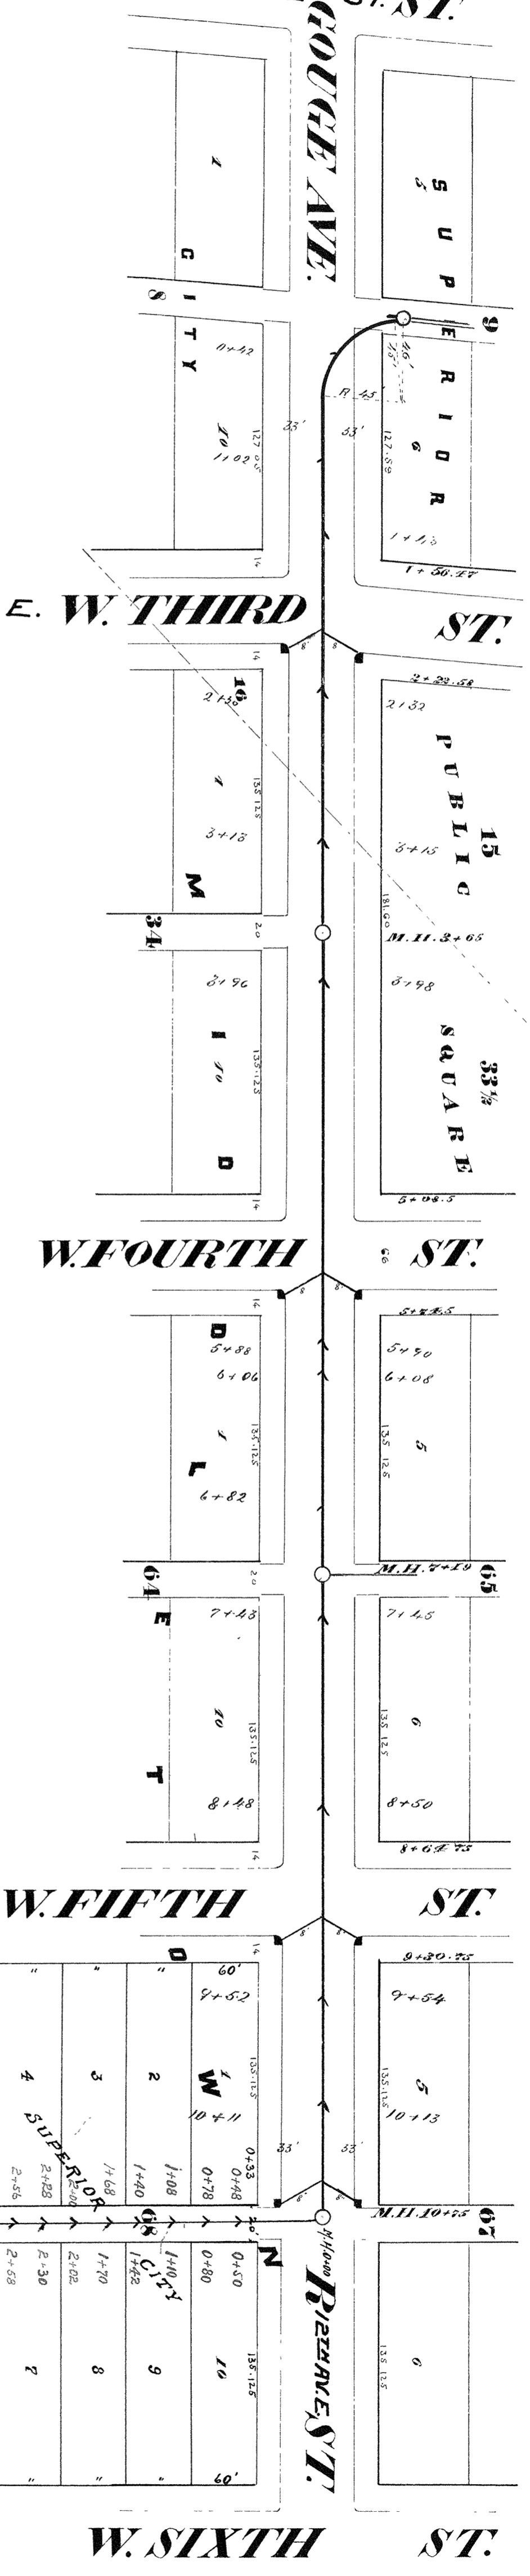


CITY OF SUPERIOR

SEWER PLAN

Contract let April 18, 1892
 completed Aug. 1, 1892
 Wm Moore & Son, Contractor
 W. G. Coleman, Inspector
 A. S. Cooper, City Engineer

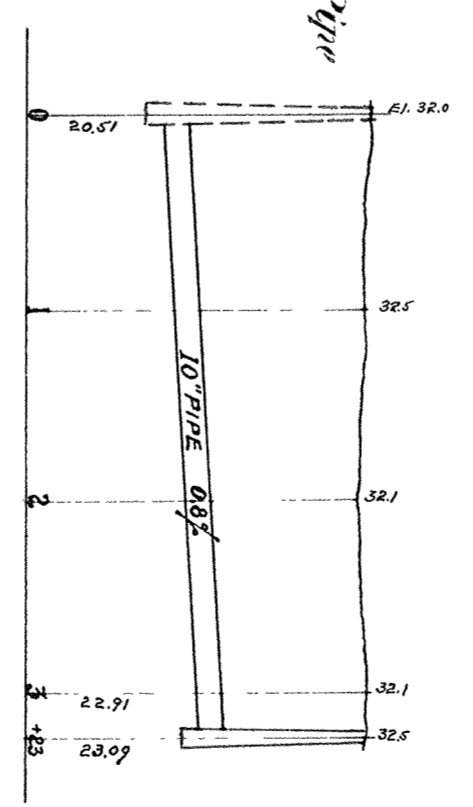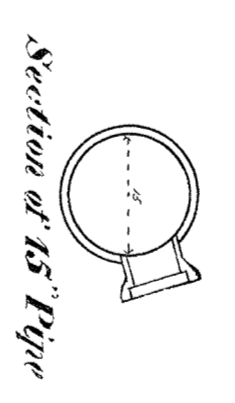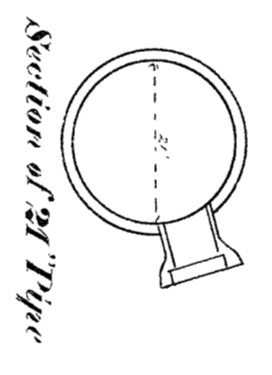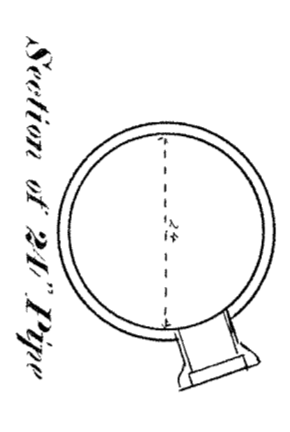

ST. No.	Horizontal Section	Vertical Section
1	1+08	1+08
2	1+40	1+40
3	1+68	1+70
4	2+02	2+02
5	2+30	2+30
6	2+58	2+58
7	3+15	3+15
8	3+53	3+53
9	4+00	4+00
10	4+33	4+33
11	4+48	4+48
12	4+78	4+78
13	5+11	5+11
14	5+52	5+52
15	6+00	6+00

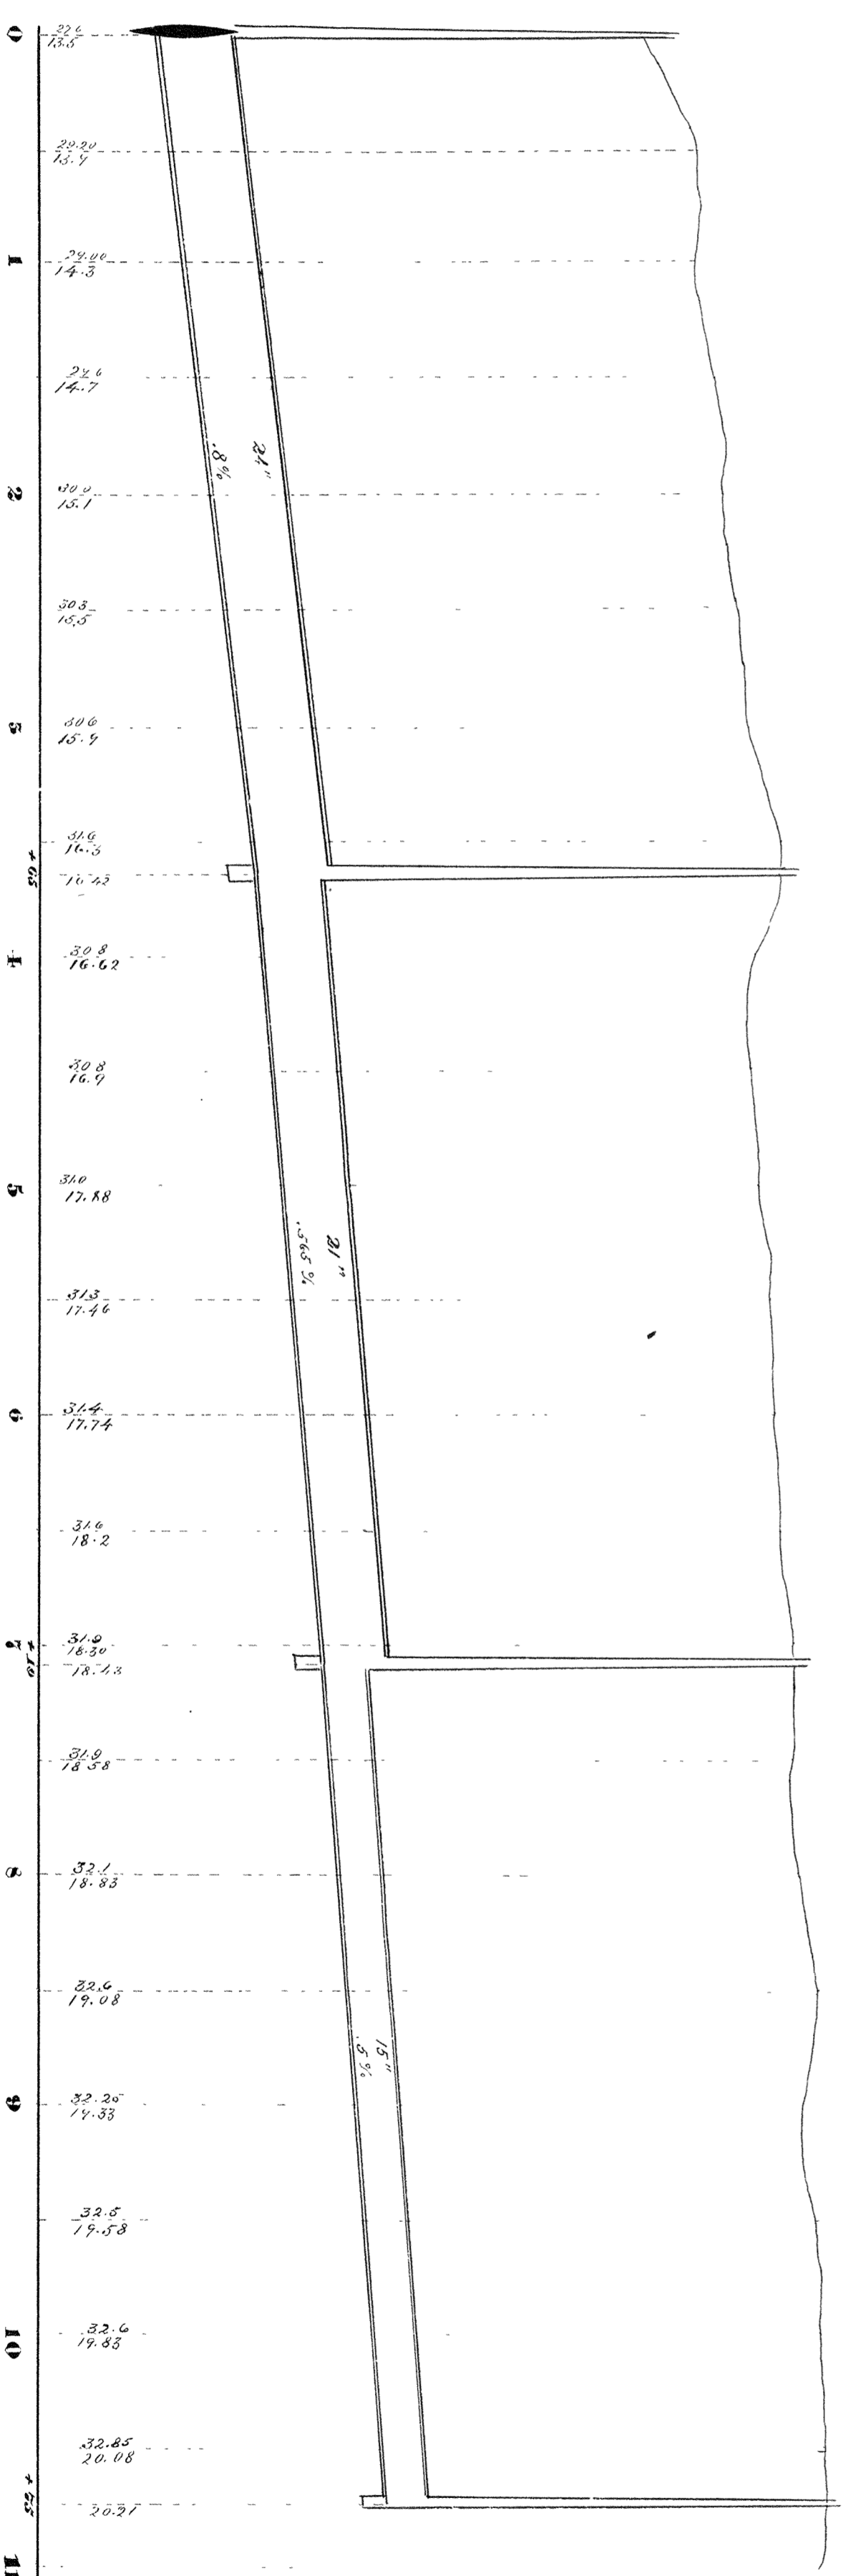

Plan & Profile of Sewer in Course from Alley south of Bay to Alley south of Fifth St.

Baseline 10above datum

3A-10