

WEST THIRD ST.


### CITY OF SUPERIOR SEWER PLAN

CONTRACT LET DEC. 20, 1919  
" " COMPLETED MAR. 30, 1920  
OSCAR ANDERSON & CO CONTRACTOR  
E.M. STEFFENSON INSPECTOR  
E.B. BANKS CITY ENGINEER  
CONTRACT 1617

SCALE { 1" HORIZONTAL = 60'  
1" VERTICAL = 4'


WEST FOURTH ST.

"P" / 10<sup>TH</sup> AVE. E.


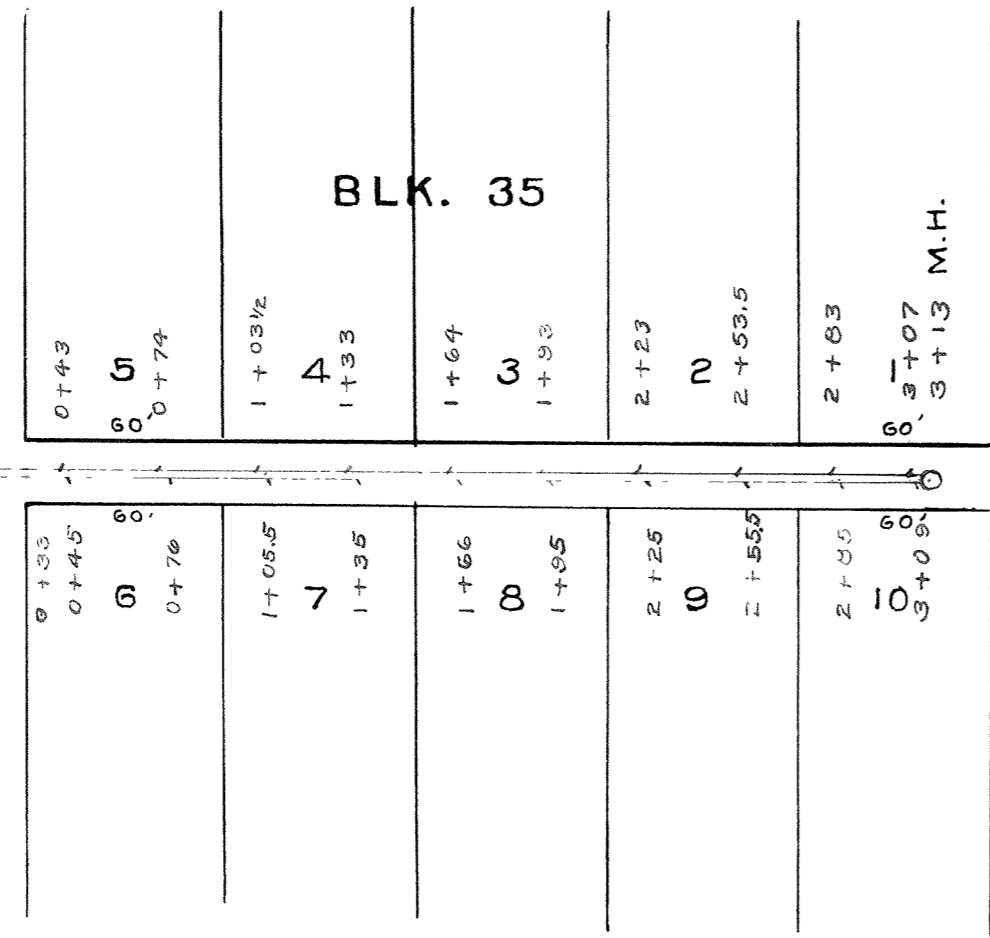


"Q" / 17<sup>TH</sup> AVE. E.

"Q" / 17<sup>TH</sup> AVE. E.

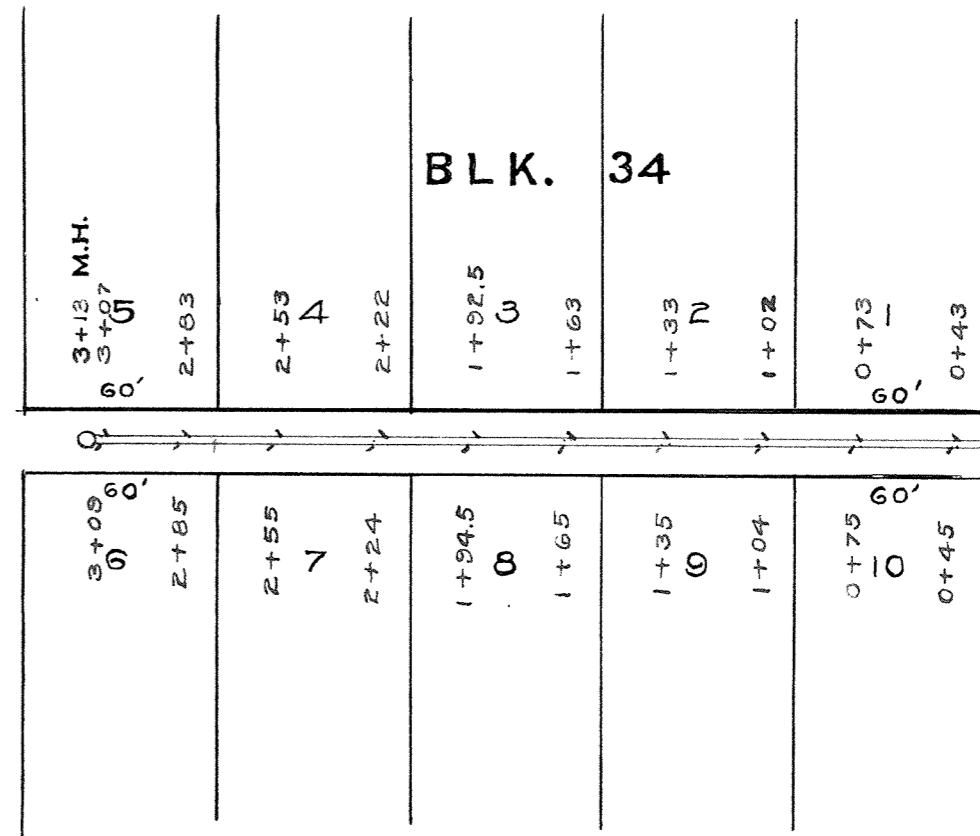

"R" / 27<sup>TH</sup> AVE. E.

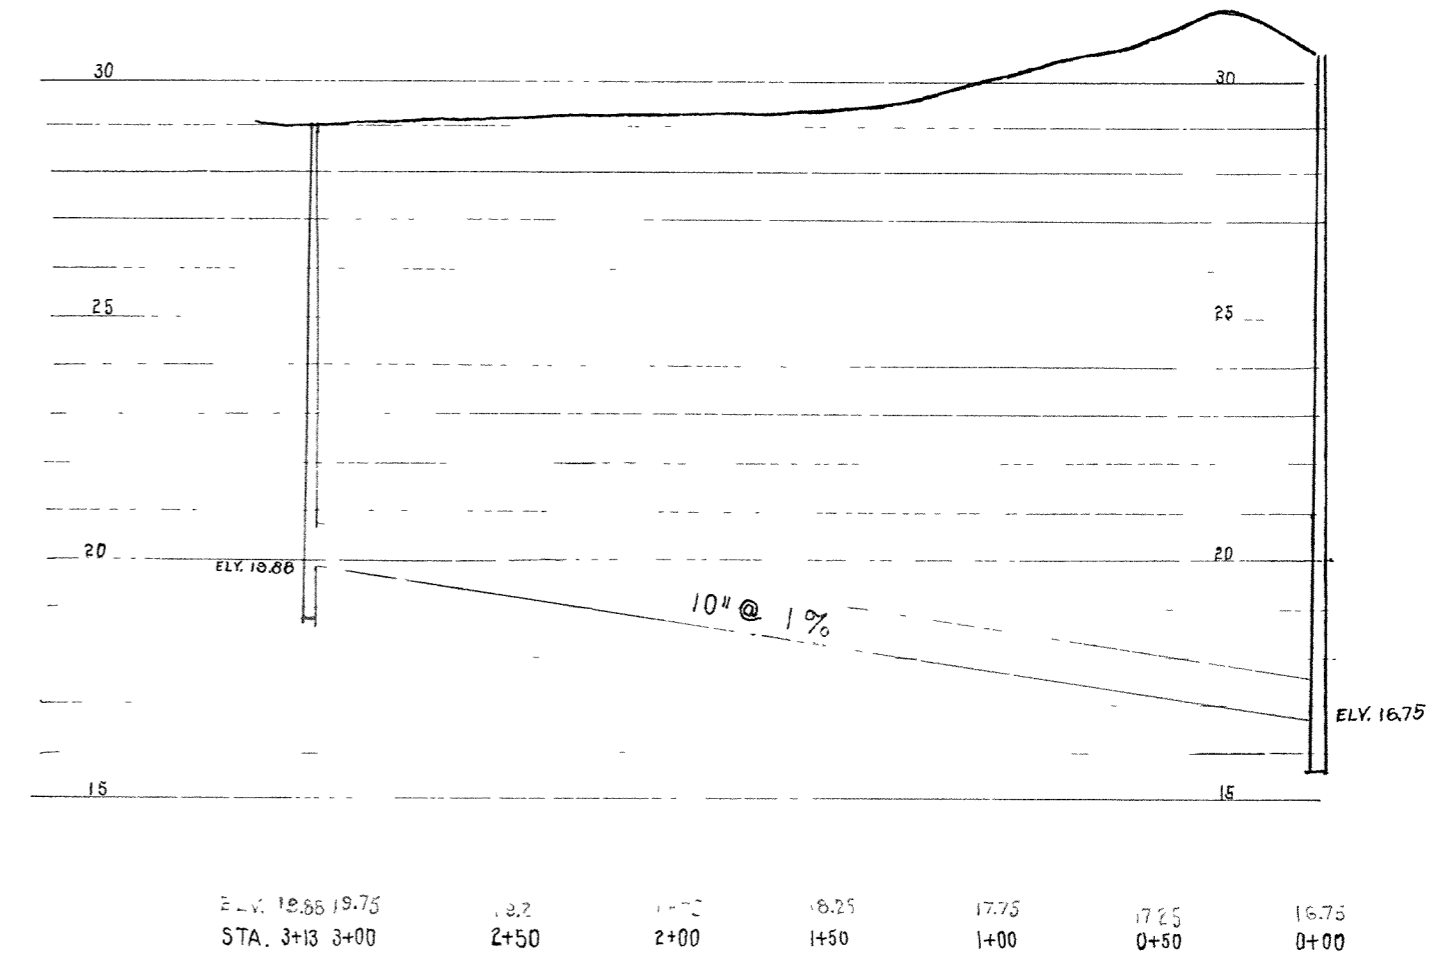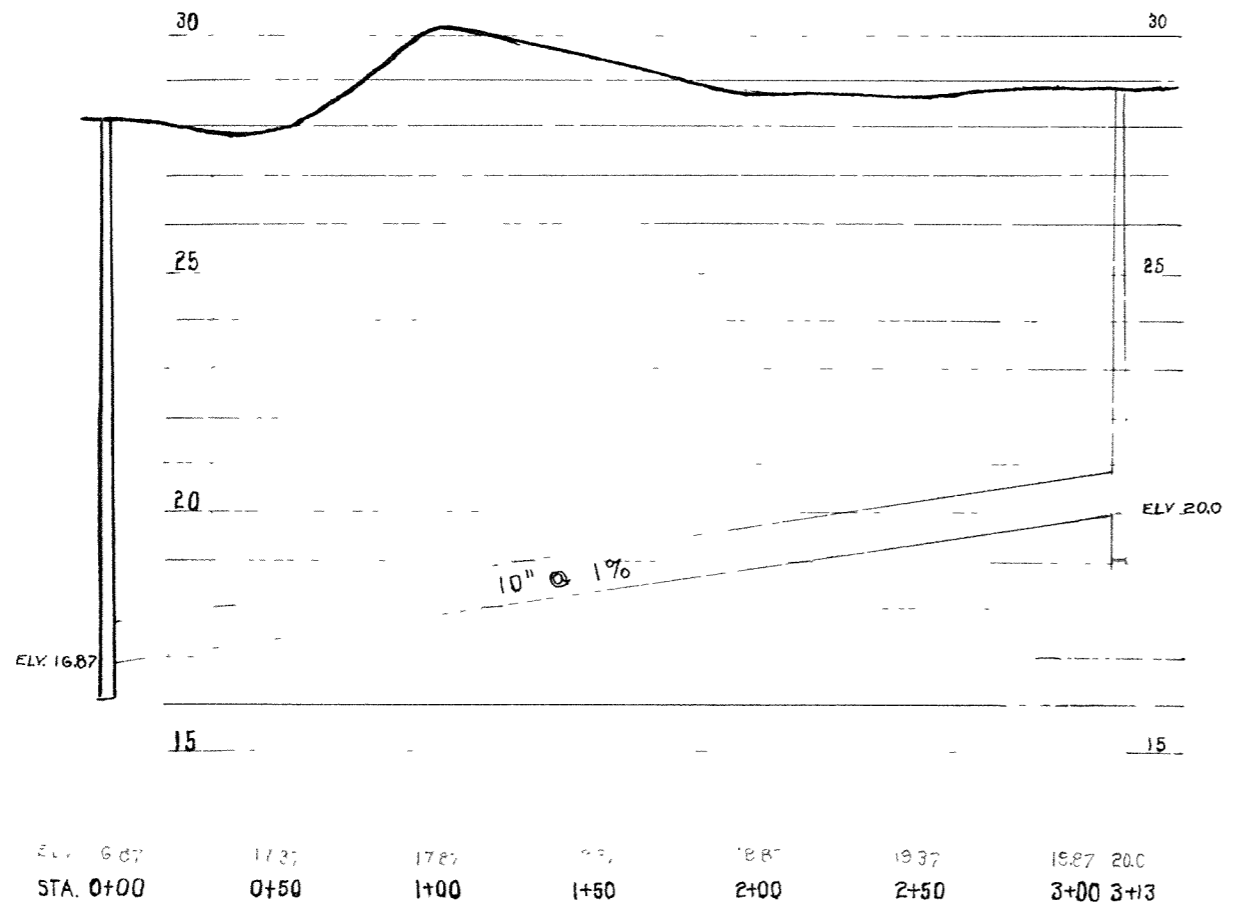

WA-10A