


CITY OF SUPERIOR

SEWER PLAN

Contract let April 18, 1892
 completed Aug. 1, 1892
 Wm Moore & Son, Contractor
 W. G. Coleman, Inspector
 A. S. Cooper, City Engineer

1893
 HORIZONTAL 1" = 60.0'
 VERTICAL 1" = 4.0'

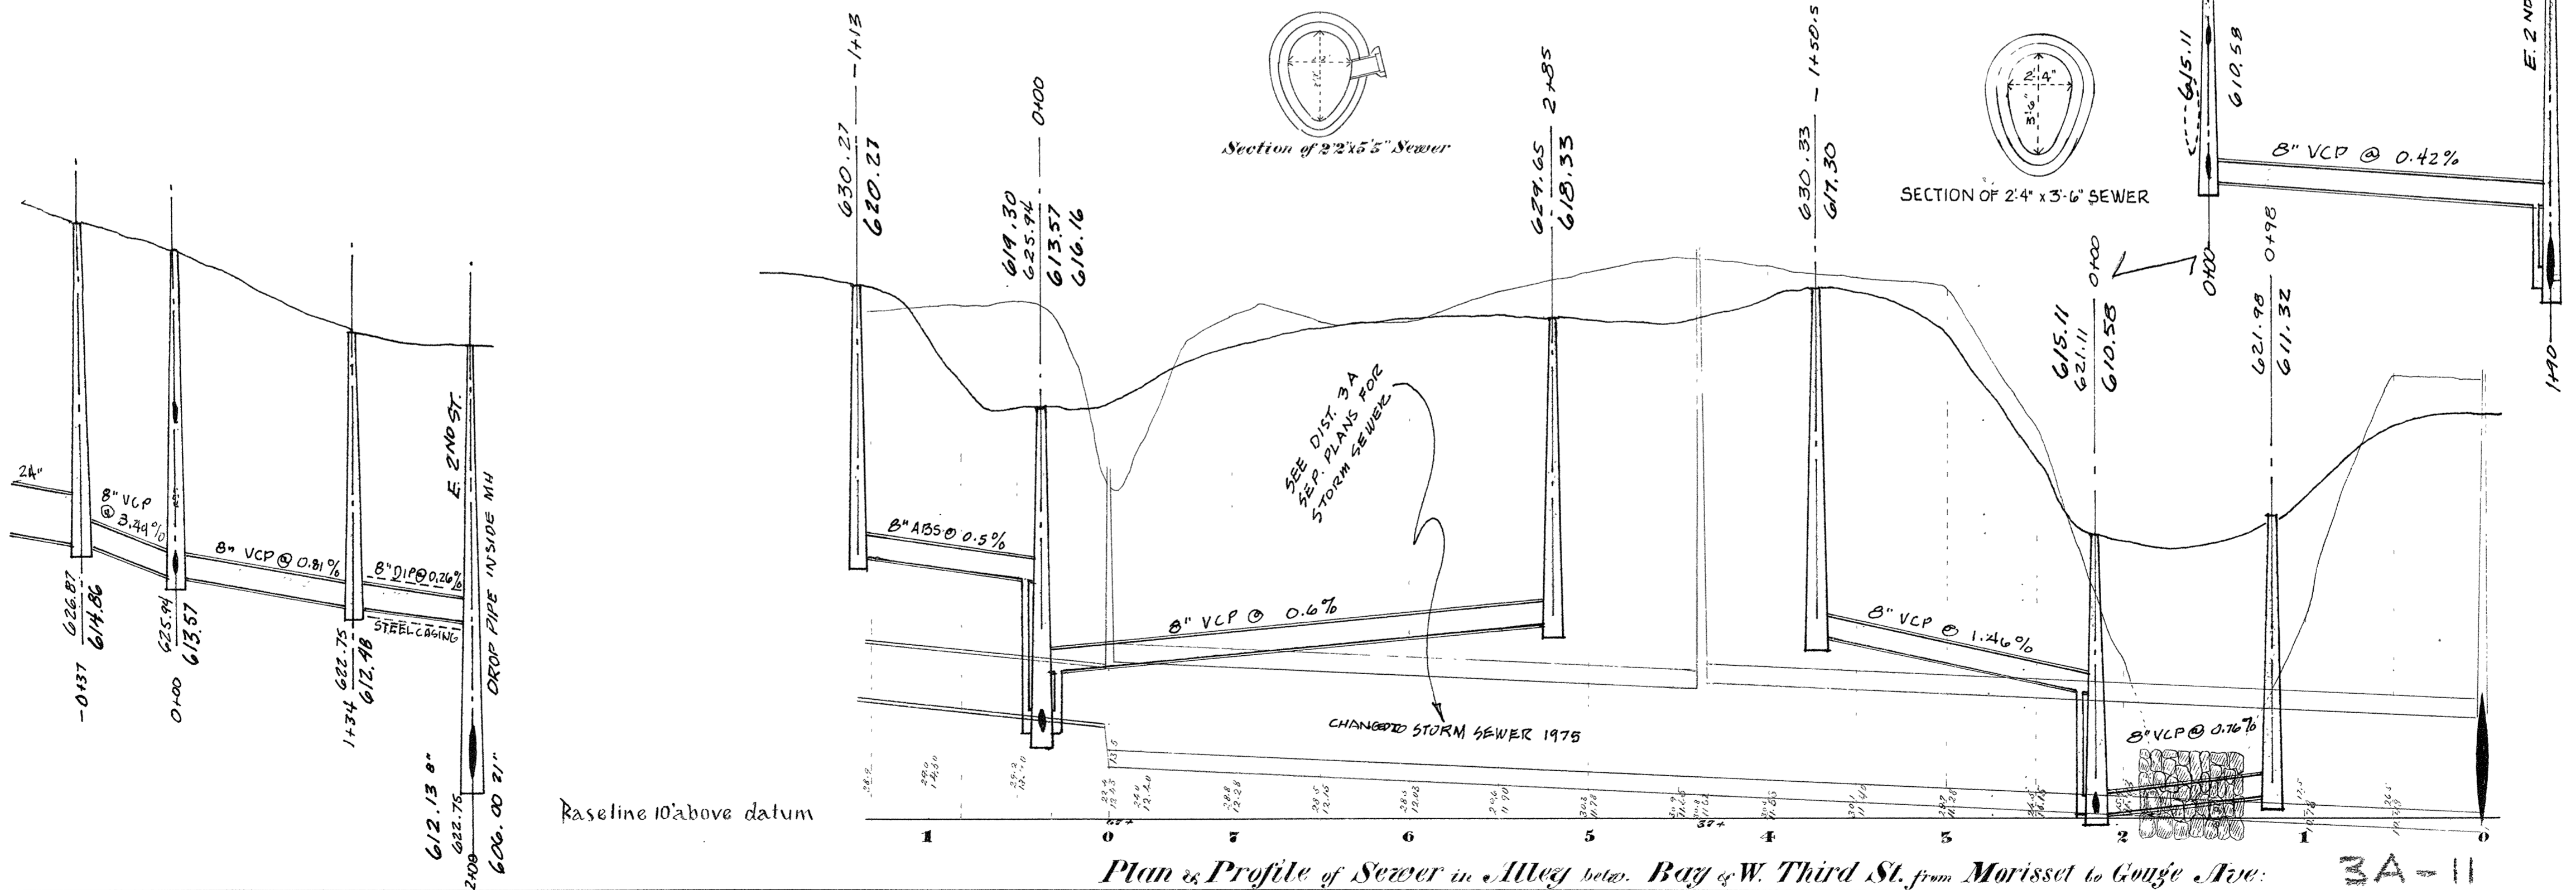

Plan & Profile of Sewer in Alley below Bay & W. Third St. from Morisset to Golge Ave.

3A-11