



E. W. EIGHTH

ST.


15TH AVE. E.  
CADDOTTE AVE.

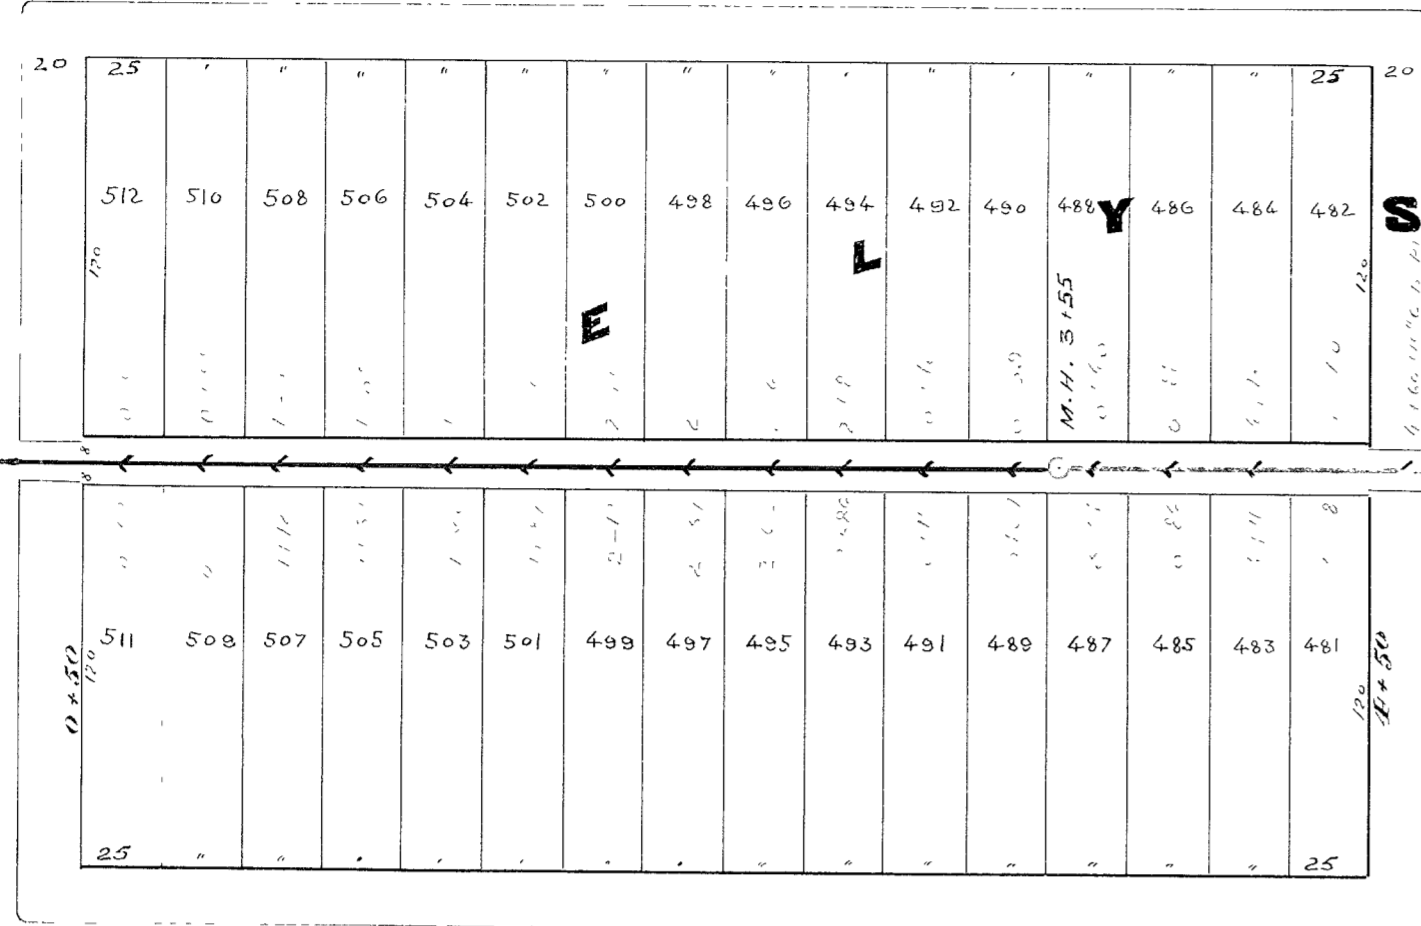

CORCORAN 16TH AVE. E.

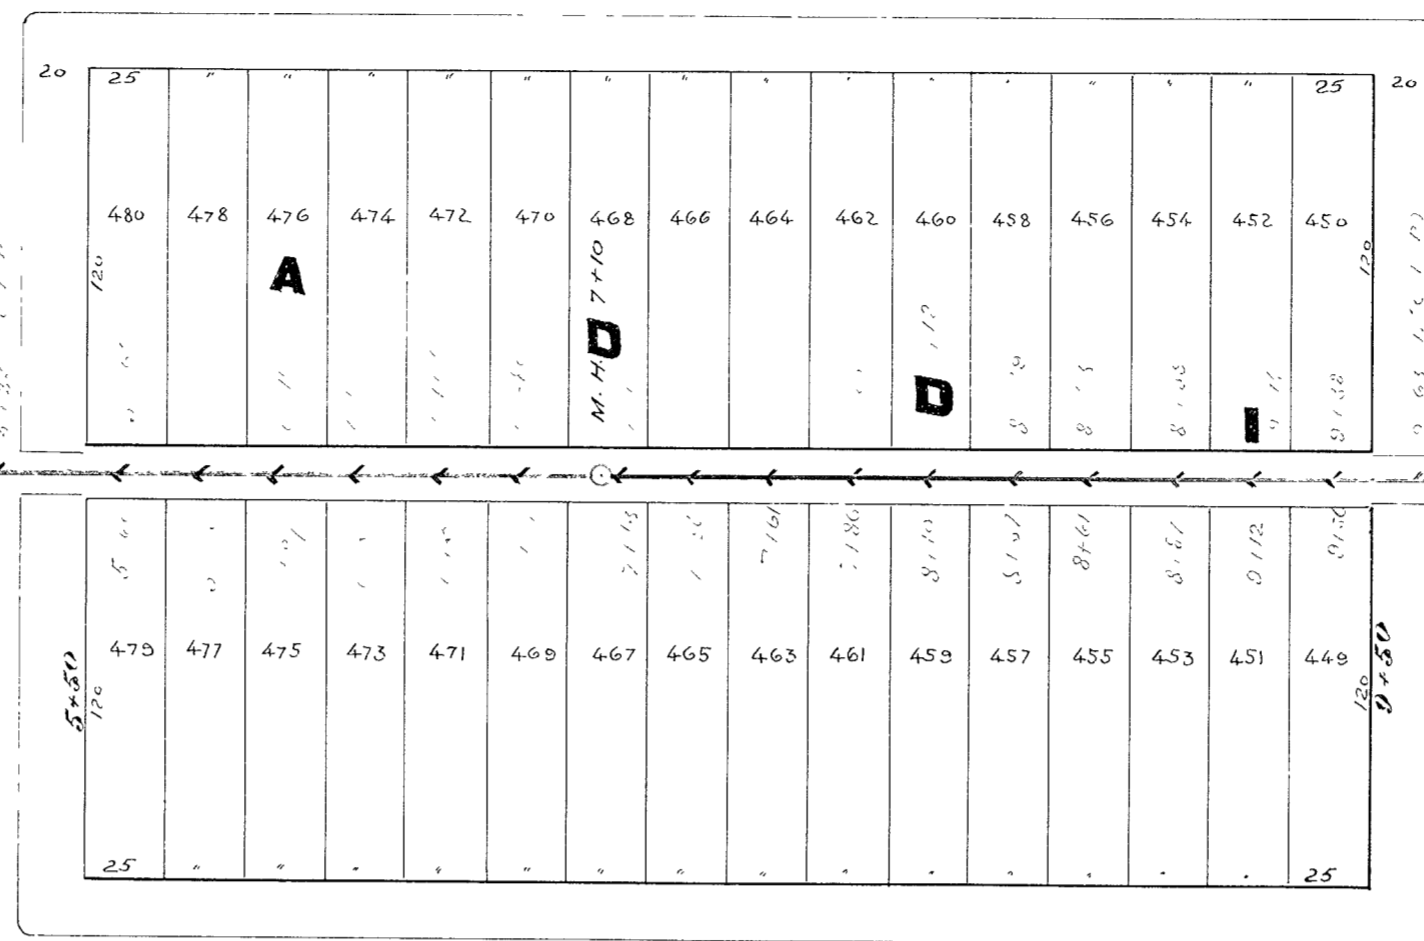

WALBRIDGE 17TH AVE. E.

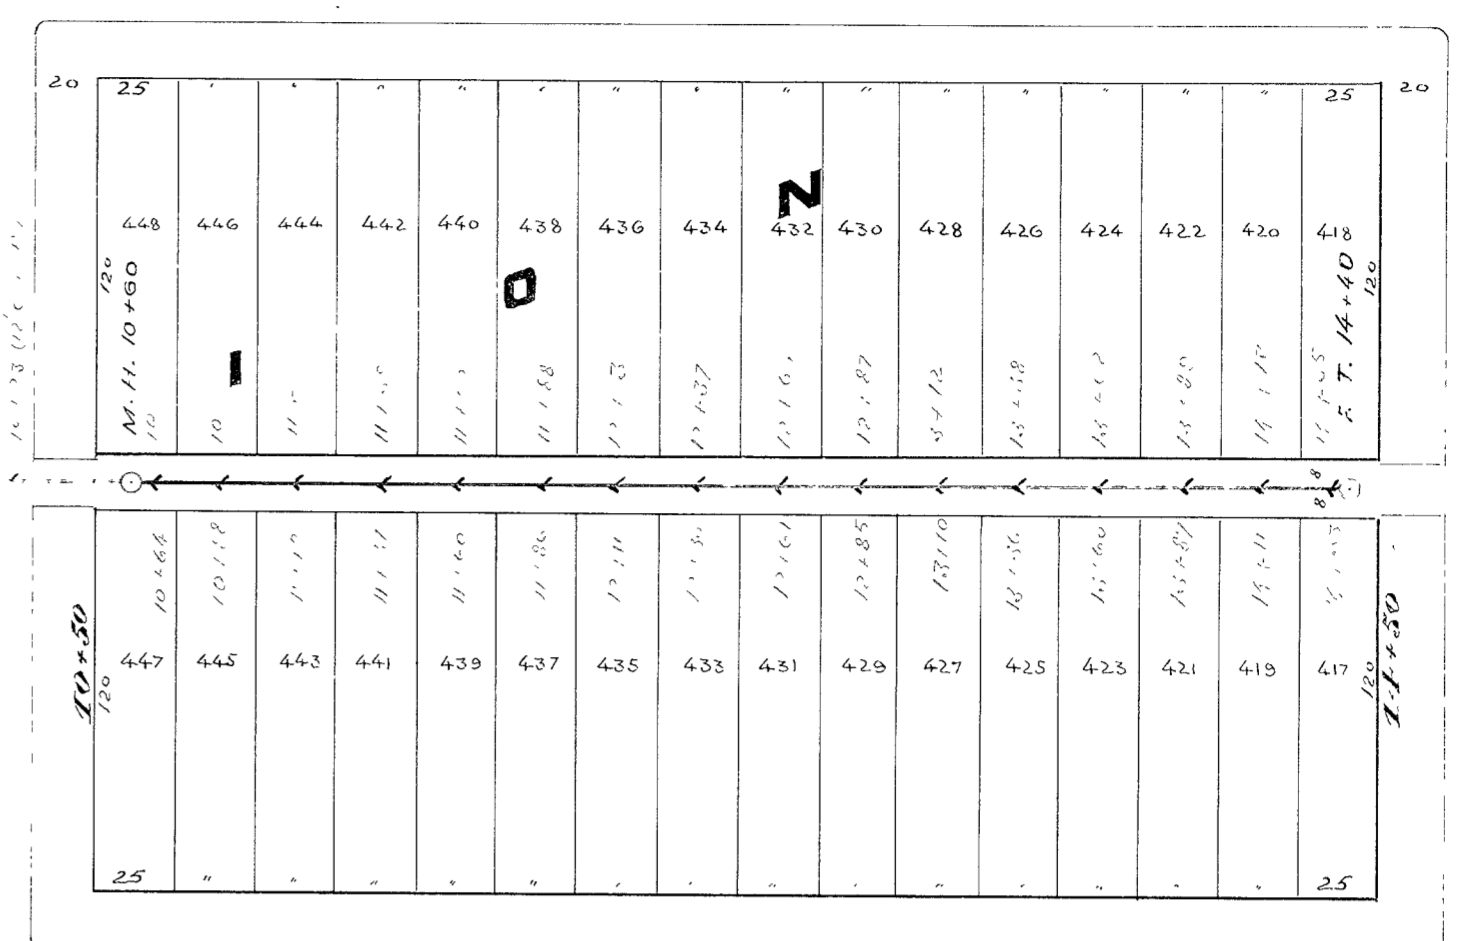


CARLTON 18TH AVE. E.


E. W. NINTH

ST.


# CITY OF SUPERIOR SEWER PLAN

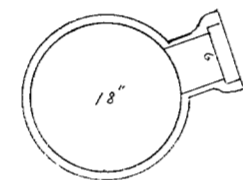

Section of 15" Pipe

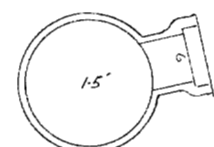

Section of 15" Pipe

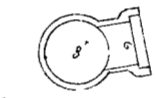


Section of 8" Pipe

1894

Scale { Horizontal 80 ft. = 1 in.  
Vertical 4 ft. = 1 in.  
Section 2 ft. = 1 in.

Contract let April 3, 1891  
" completed Aug. 1, 1891  
Kirkland & Starkes, Contractor  
W. R. Russell, Inspector  
E. B. Banks City Engineer.

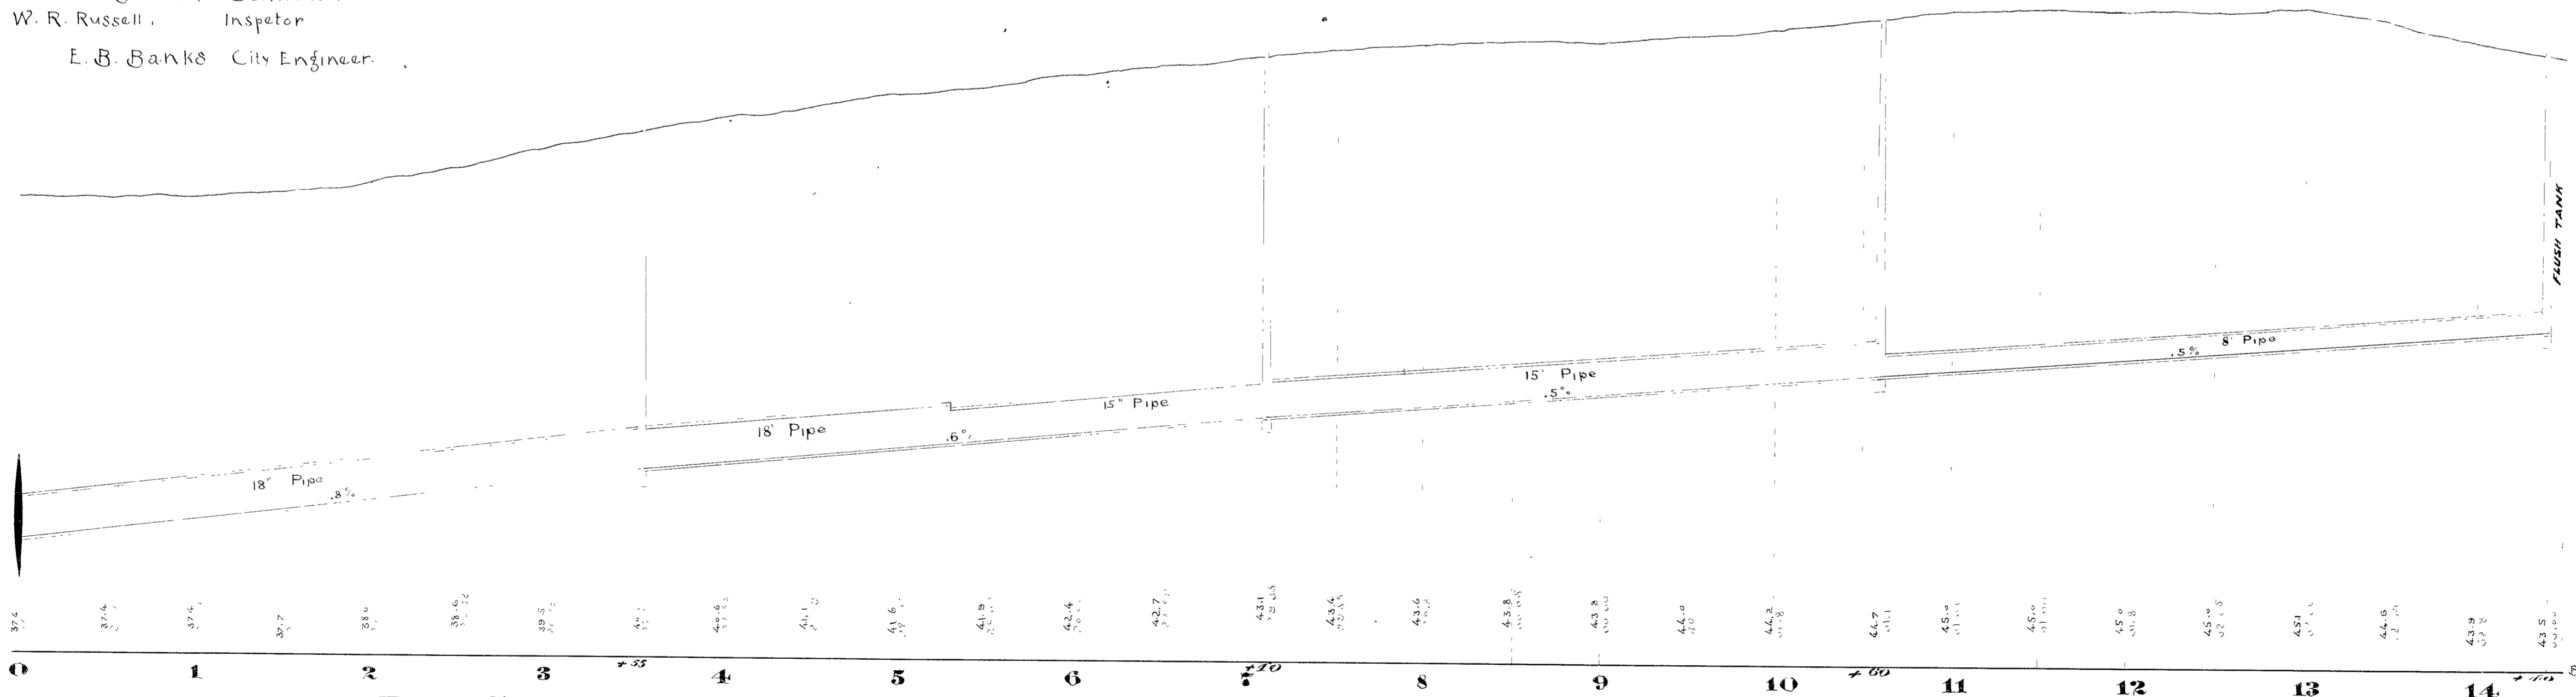

Plan & Profile of Sewer in Alley betw. W. Eighth & W. Ninth St. from Cadotte to Carlton Ave.

3A-10