
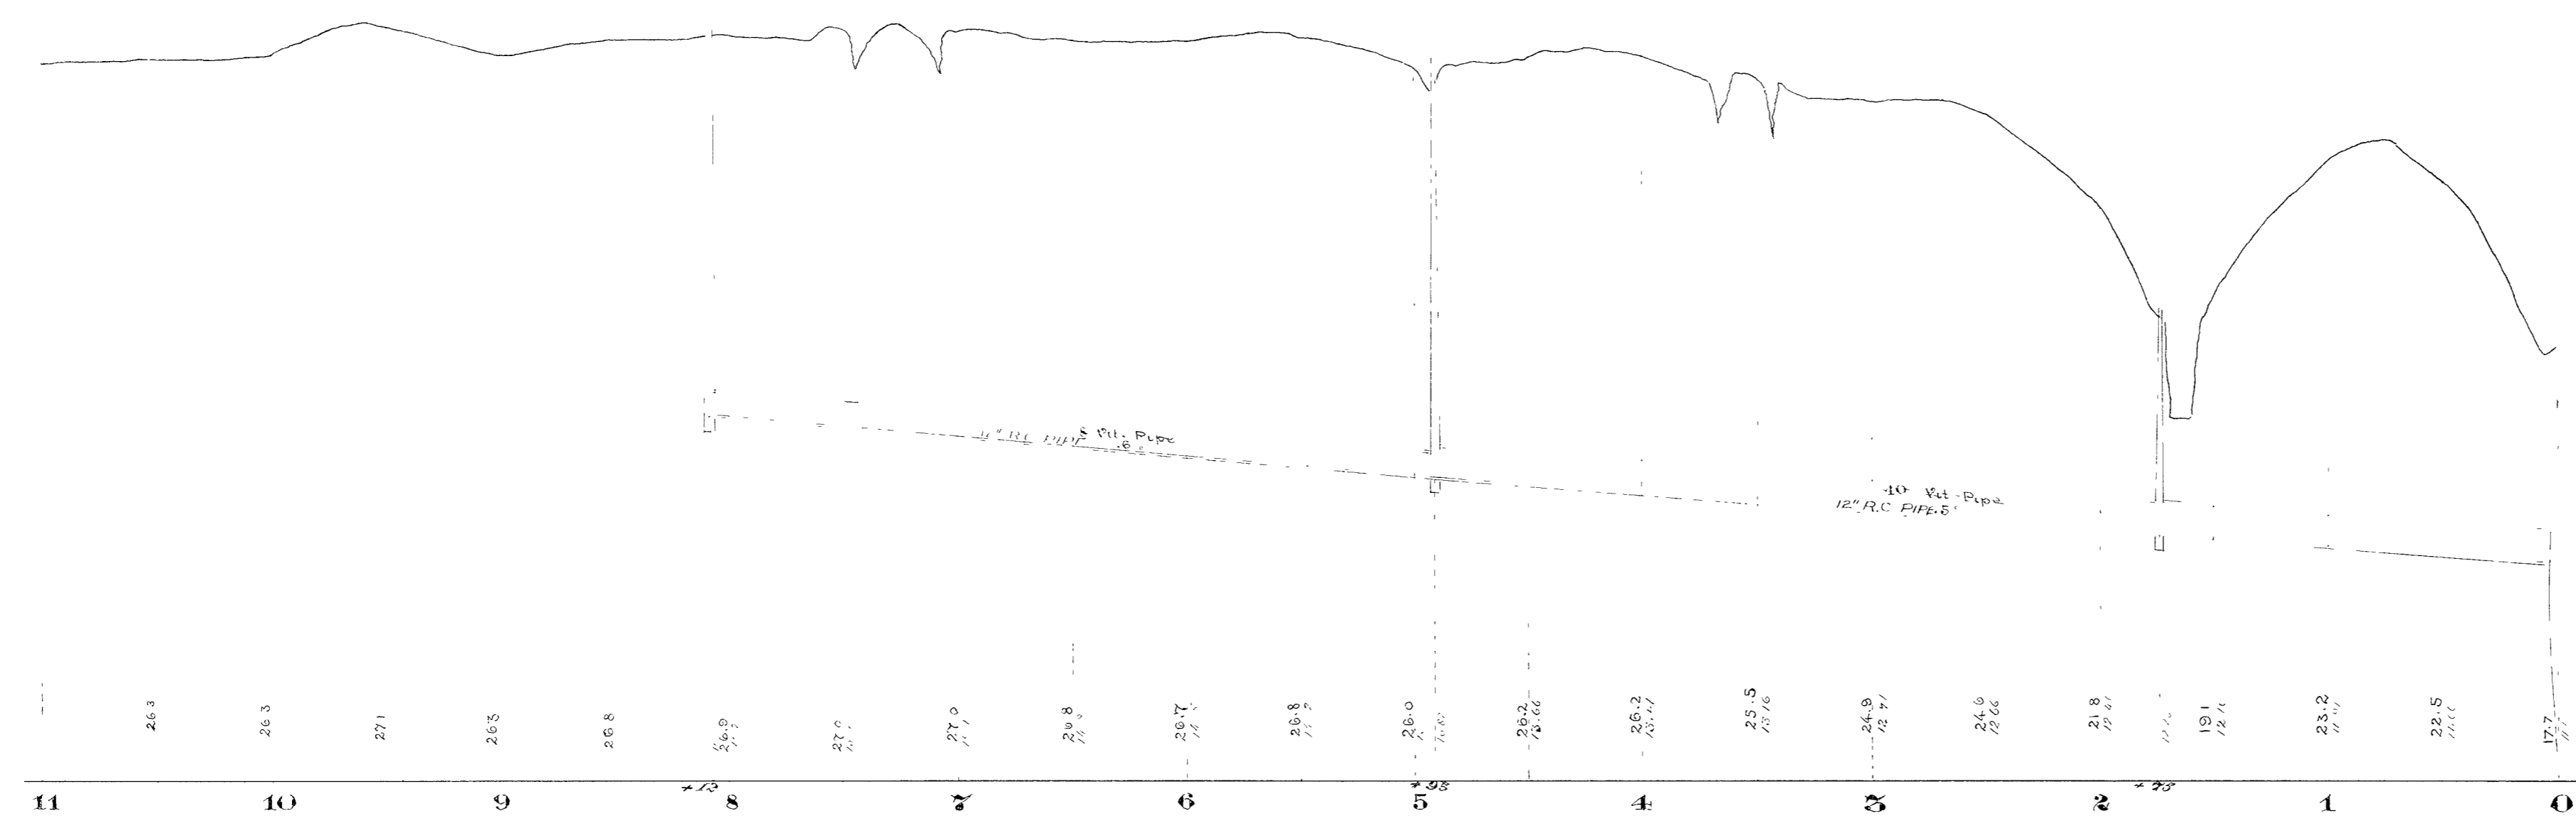


1895

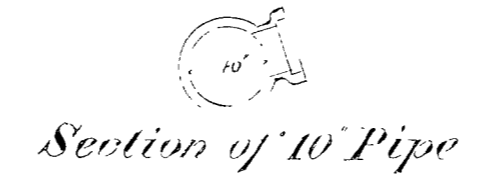

CITY OF SUPERIOR
SEWER PLAN
 Contract let Sept. 28, 1894
 Completed Nov. 26, 1894
 M. C. Burke Contractor
 Jos. P. Duff, Inspector
 A. T. Thomas, City Engineer.

Scale: { Horizontal 60' = 1"
 Vertical 4' = 1"
 Section 2' = 1"

Base line 5ft. above Datum

Plan & Profile of Sewer in Alley between W. Fifth & W. Sixth St. from K St. to H St.

3A-20