

CONTRACT NO  
Sta. 0+00 To 3+10

Contract Let  
Contract Completed  
City Of Superior  
Fred L. Clark  
E.B. Banks


Contractors  
Inspector  
City Engineer

STORM SEWER - BUILT  
IN 1950 BY J.L. SULLIVAN  
& SONS, CONTRACTORS,  
UNDER HIGHWAY CONTRACT. 1895

Section of 8" Pipe

Section of 10" Pipe

Section of 12" Pipe

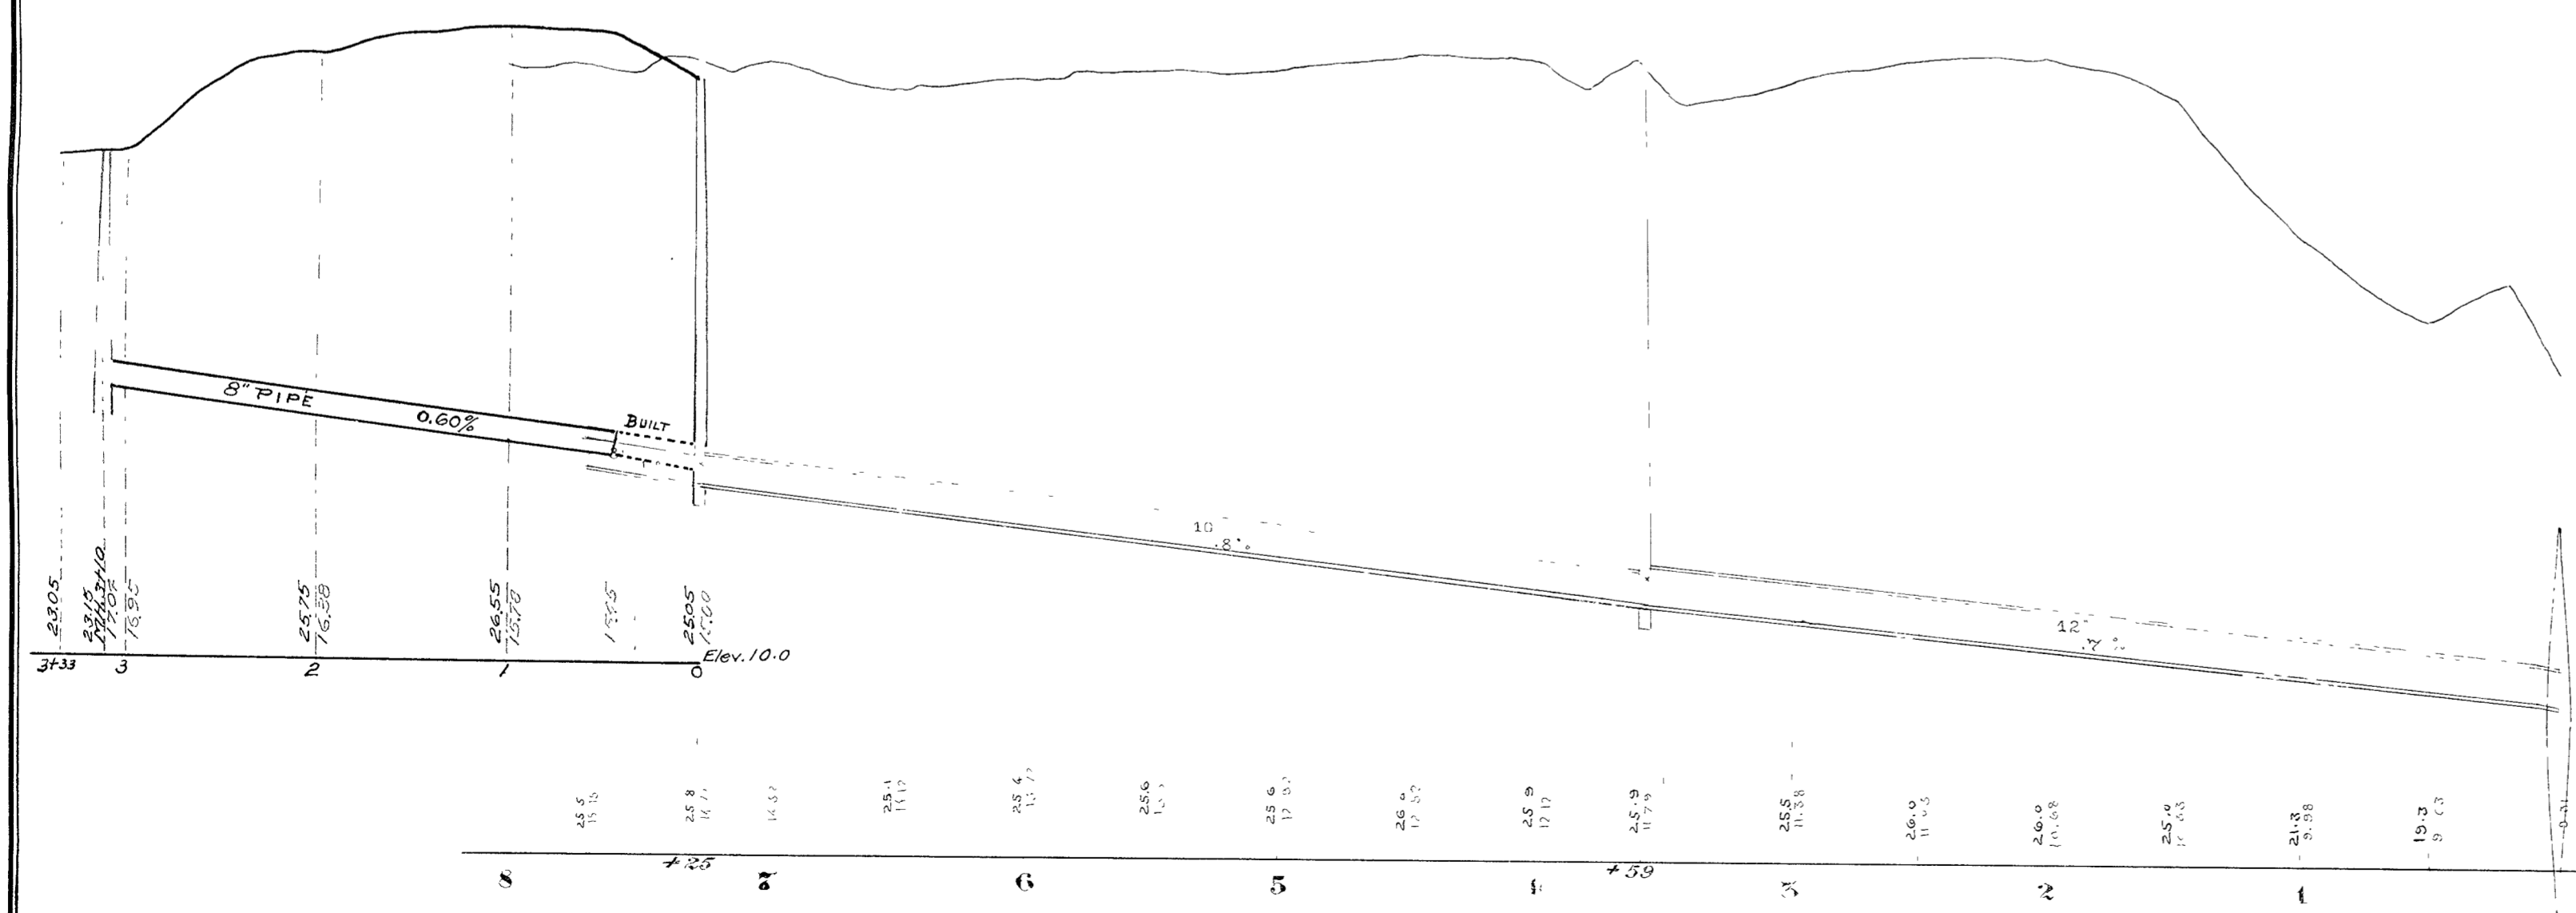

Plan & Profile of Sewer in Alley betw. Bay and Third St. from K to I St.

### CITY OF SUPERIOR SEWER PLAN

Contract let Aug 24 1895  
completed Sep. 1895  
A. Johnson Contractor  
H.H. Smith Inspector  
A.T. Thomas City Engineer

Scale: { Horizontal 80ft. = 1in.  
Vertical 4 ft. = 1in.  
Section 2ft. = 1in.

SEWER RELAID WITH R.C. PIPE  
FROM 0+00 TO 3+59  
LABOR W.P.A.  
JOB COMPLETED MAR. 1936  
H.R. DANN INSPECTOR  
L.W. PELESKE CITY ENGINEER.

3A-21