


**CITY OF SUPERIOR,  
SEWER PLAN.**

Horizontal Scale: 1 in = 60 ft.  
Vertical Scale: 1 in = 4 ft.

CONTRACT N<sup>o</sup> 1107  
 Contract let August 5, 1908.  
 Contract completed November 12, 1908.  
 A. J. M<sup>o</sup> Donald Contractor.  
 E. B. Eldred Inspector.  
 E. B. Banks City Engineer.

STA. 22+63.35 TO STA. 21+82.35  
 24" R.C. PIPE LAID JUNE 1937  
 W. P. A. LABOR  
 M. SKAMSER INSPECTOR  
 L. W. PELESKE CITY ENGINEER

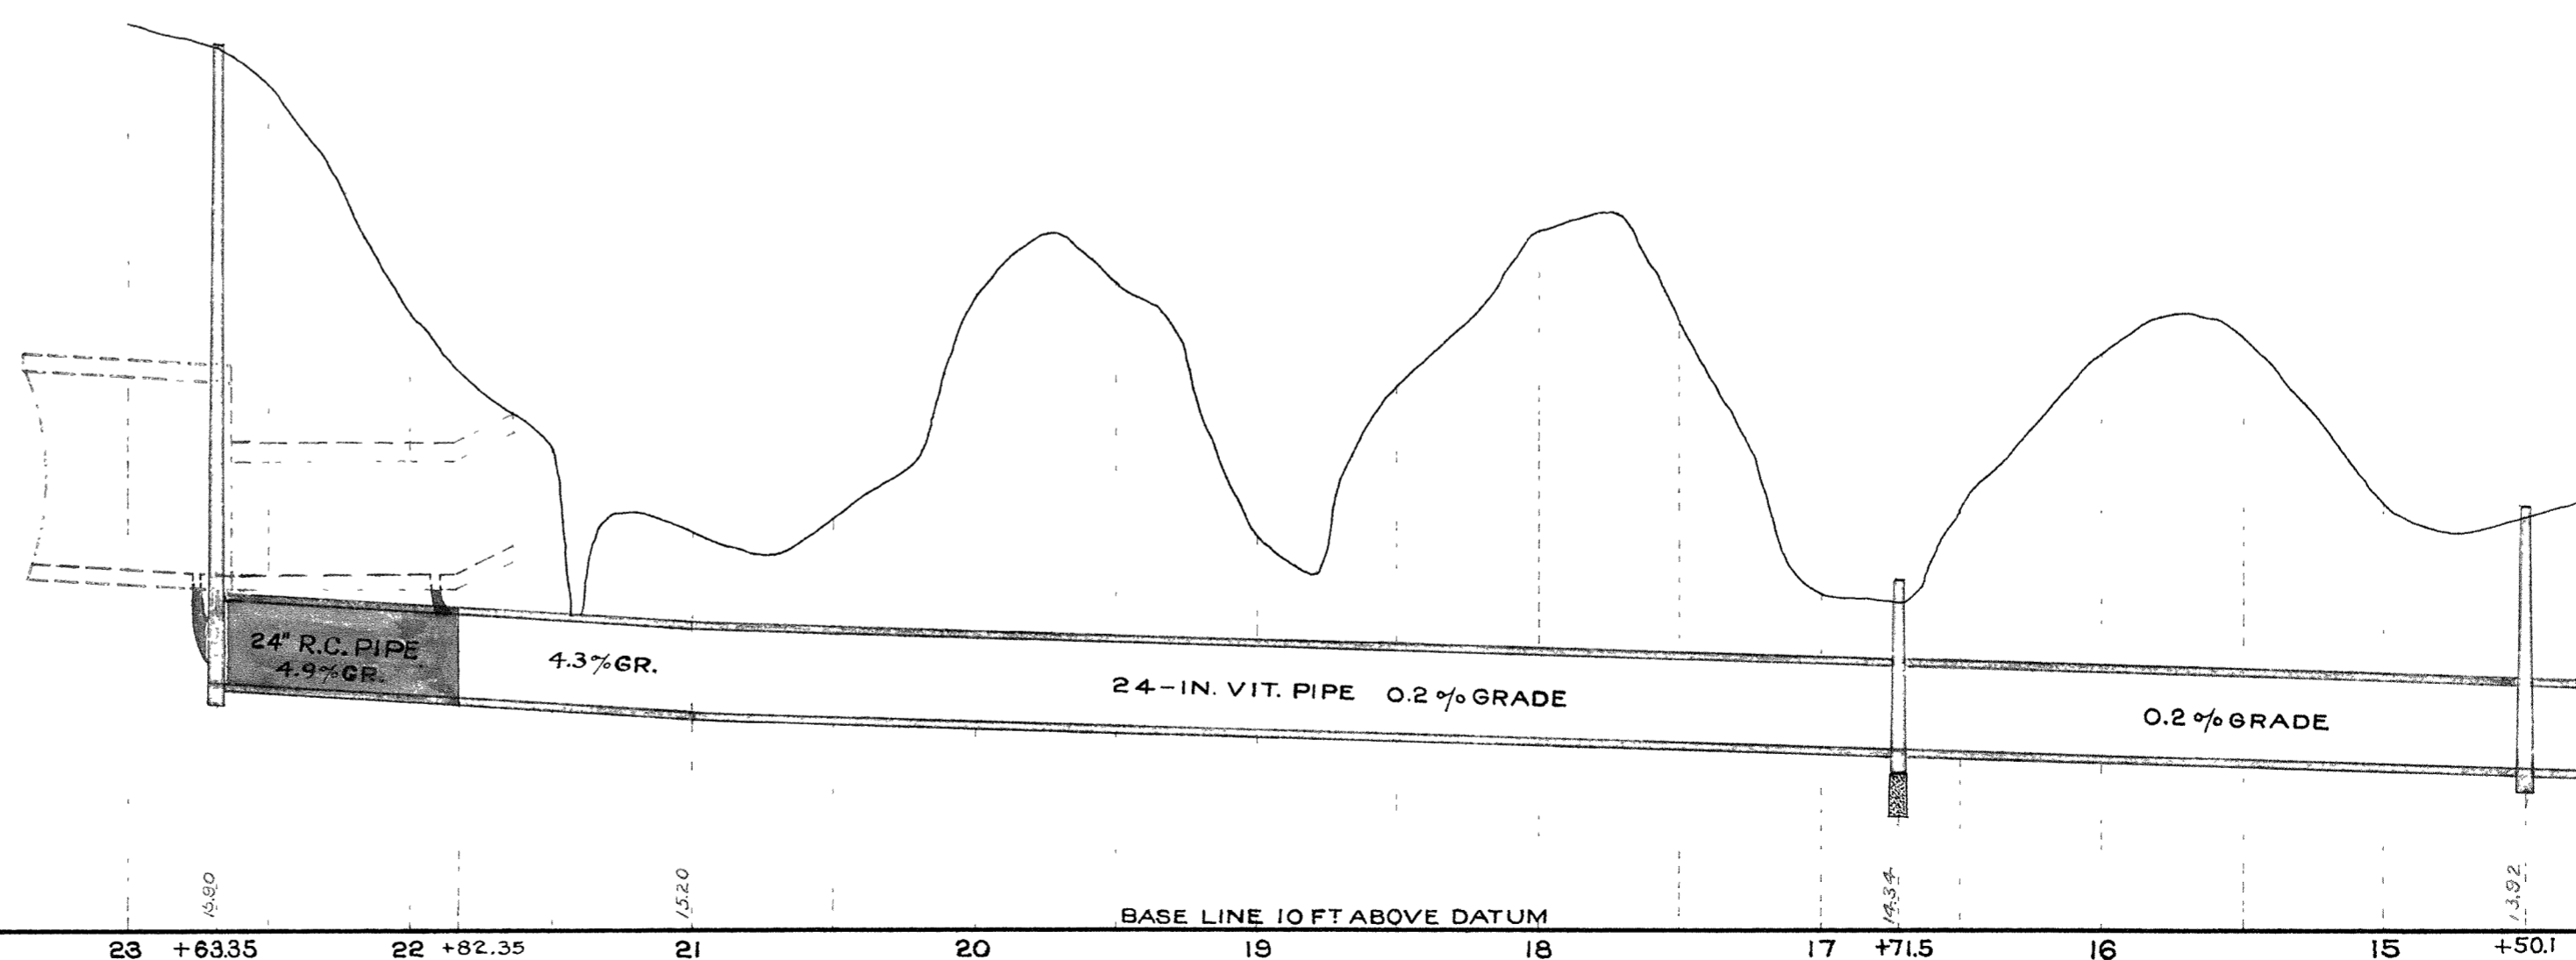

Extension of N. 21st. Street Main Sewer to Laurel Avenue Sewer: 3A-22B