
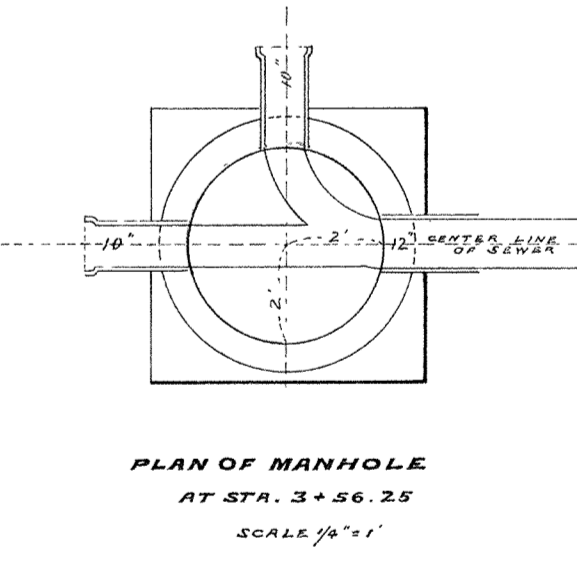
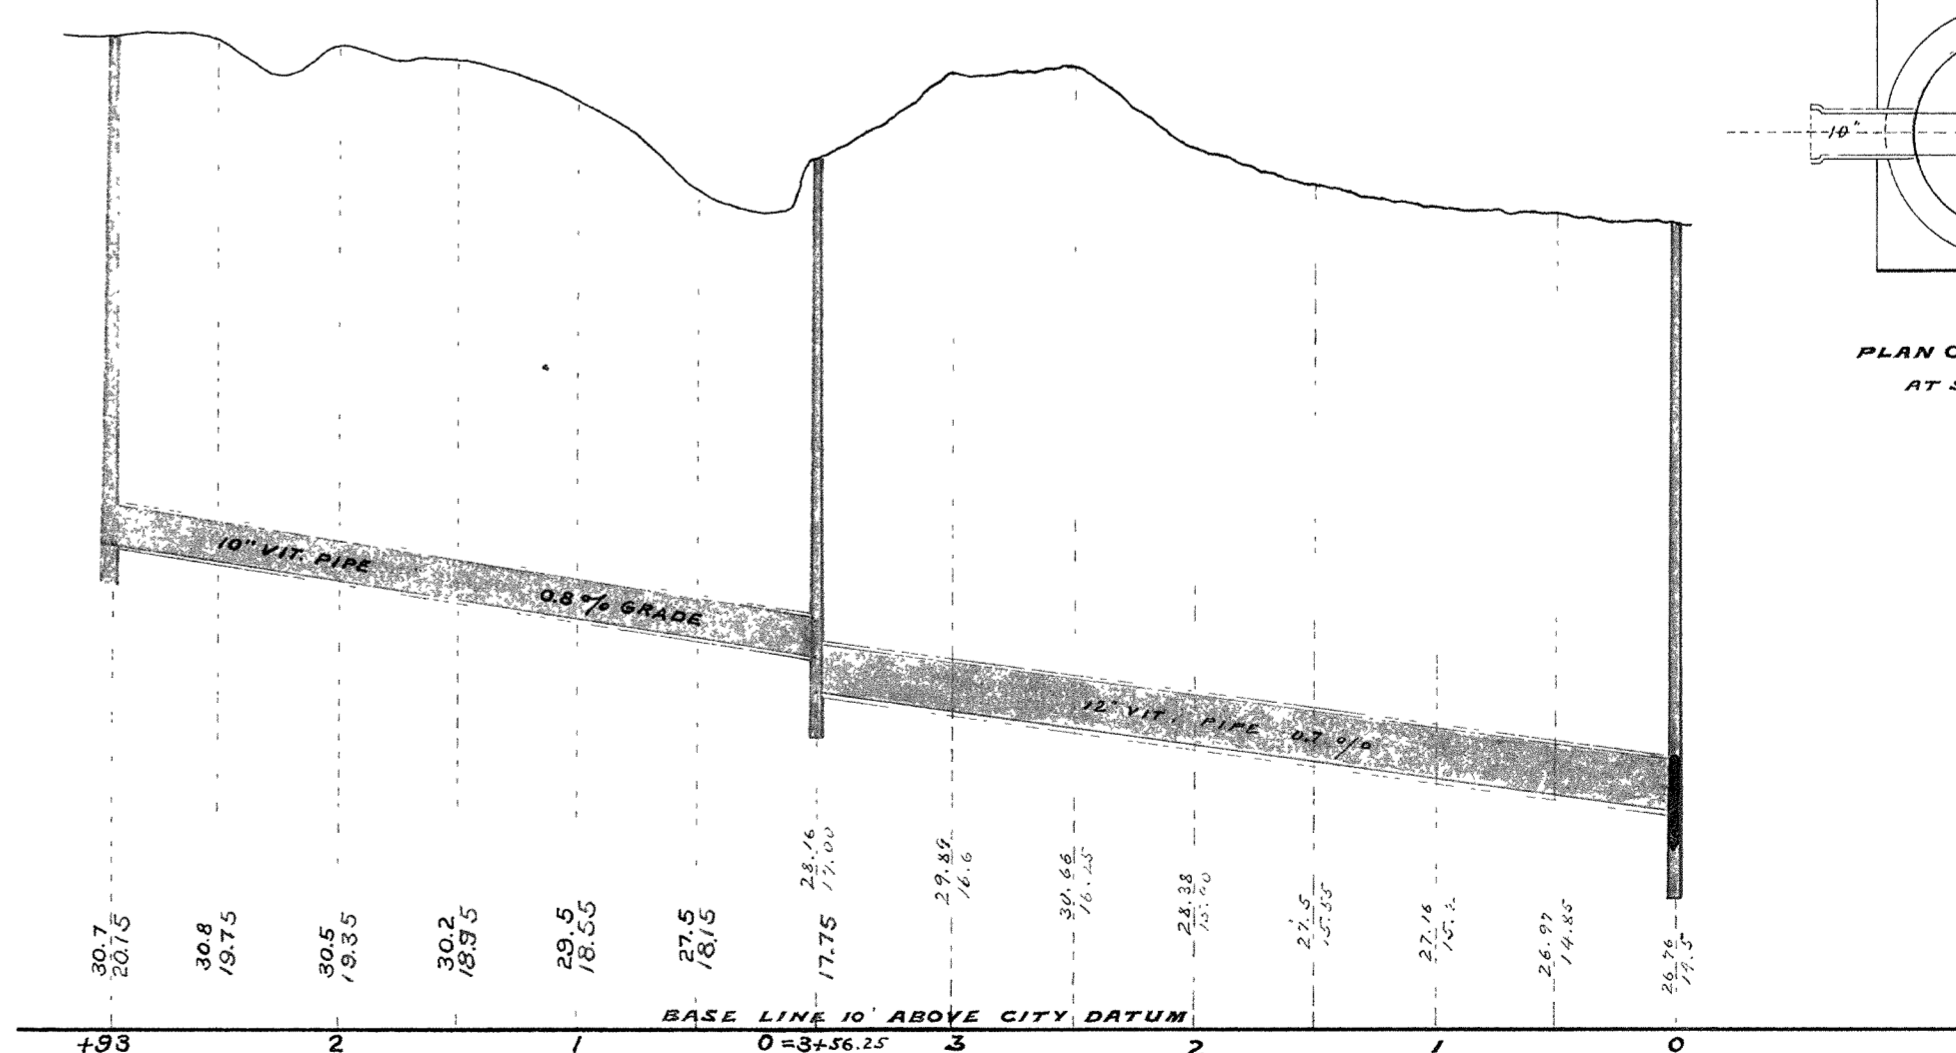


# CITY OF SUPERIOR SEWER PLAN

CONTRACT LET OCT. 24<sup>TH</sup> 1905  
SEWER COMPLETED NOV. 15<sup>TH</sup> 1905  
ANDERSON & JOHNSON CONTRACTORS  
V. COURNOYER INSPECTOR  
S. M. WHITE CITY ENGINEER

SCALE : { HORIZONTAL : 1" = 80'  
VERTICAL : 1" = 4'

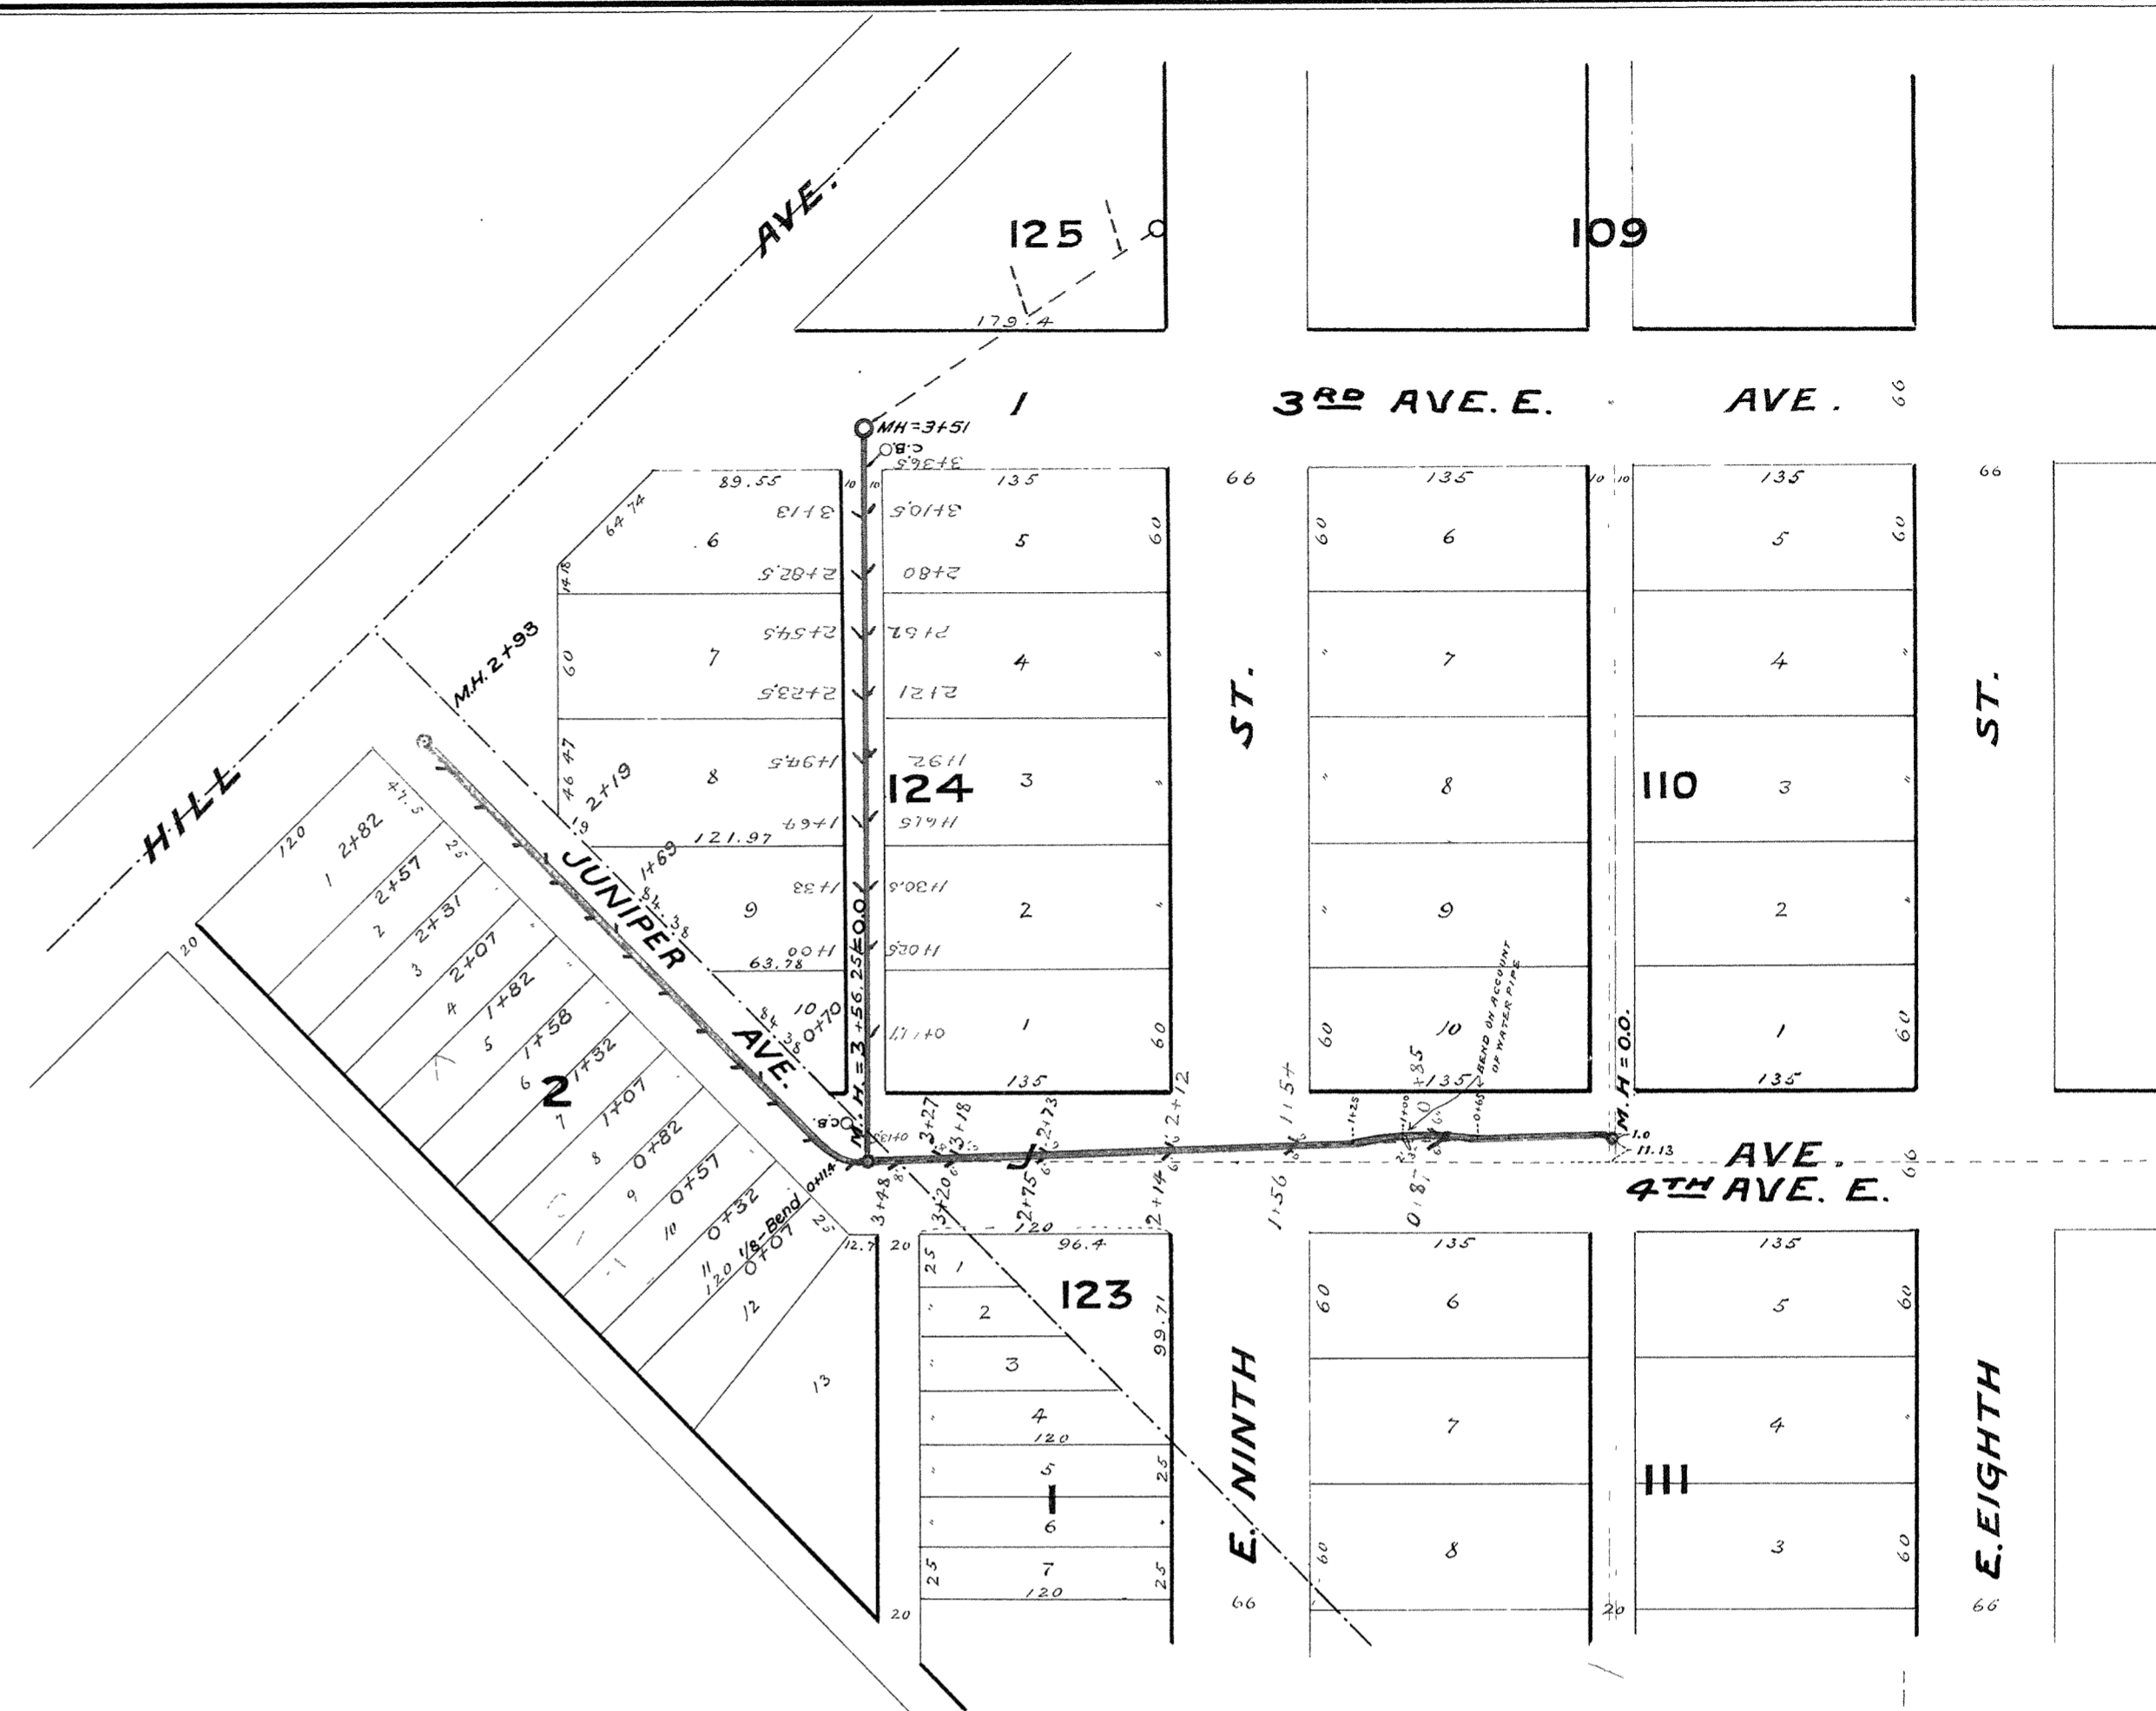

PROFILE OF SEWER IN J AVE. FROM ALLEY BETWEEN 8<sup>TH</sup> & 9<sup>TH</sup> STS TO ALLEY BETWEEN 9<sup>TH</sup> & 10<sup>TH</sup> STS.

3A-24