


CITY OF SUPERIOR SEWER PLAN

Contract let July 27, 1891
 completed Nov. 10, 1891
 G. J. Anderson, Contractor
 F. C. Grant & Co. Duff, Inspectors
 E. B. Banks, City Engineer



6" 2" 1/2" ST.	M. H.	M. H.	M. H.	M. H.	M. H.
Alley betw. 6th & 7th Sts.	at 3+53	at 3+53	at 3+53	at 3+53	at 3+53
Street Sewer	Street Sewer	Street Sewer	Street Sewer	Street Sewer	Street Sewer
15.06	16.08	16.08	16.08	16.08	16.08
Alley betw. (Br.) Sts.	3A-3	3A-3	3A-3	3A-3	3A-3
27.002/14.03	28.004/16.35				

5TH AV. (A) ST.	4TH AV. (C) ST.	3RD AV. (I) ST.	2ND AV. (H) ST.	1ST AV. (J) ST.	Blvd.
West Side	East Side	West Side	East Side	West Side	East Side
Street Sewer	Street Sewer	Street Sewer	Street Sewer	Street Sewer	Street Sewer
11.87	13.81	15.81	16.81	17.08	17.08
Alley betw. 7th & 8th Sts.	Alley betw. 7th & 8th Sts.				
15.06	16.08	16.08	16.08	16.08	16.08

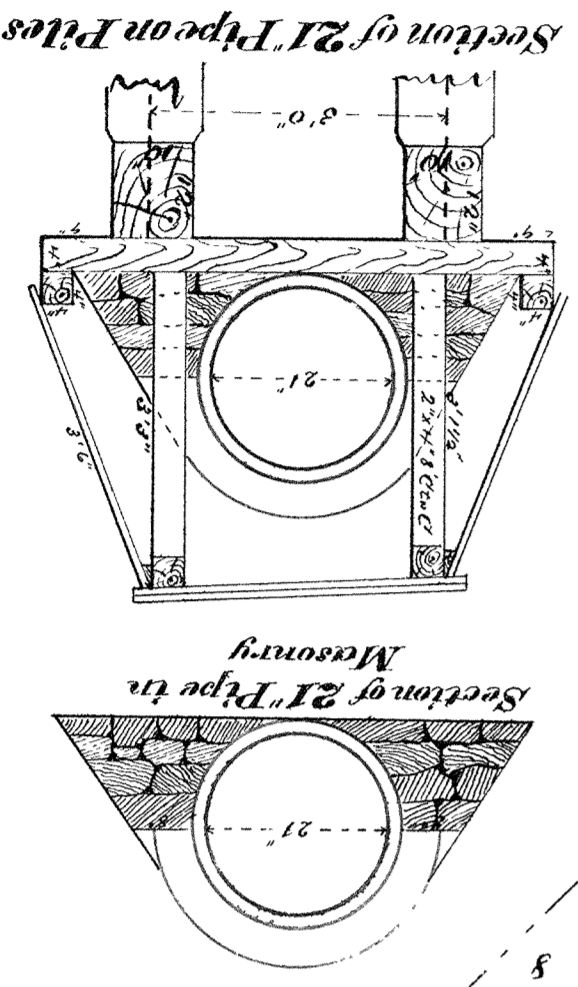

Scale: { Horizontal 1" = 20'
 Vertical 1" = 20'
 Section 1" = 20"