
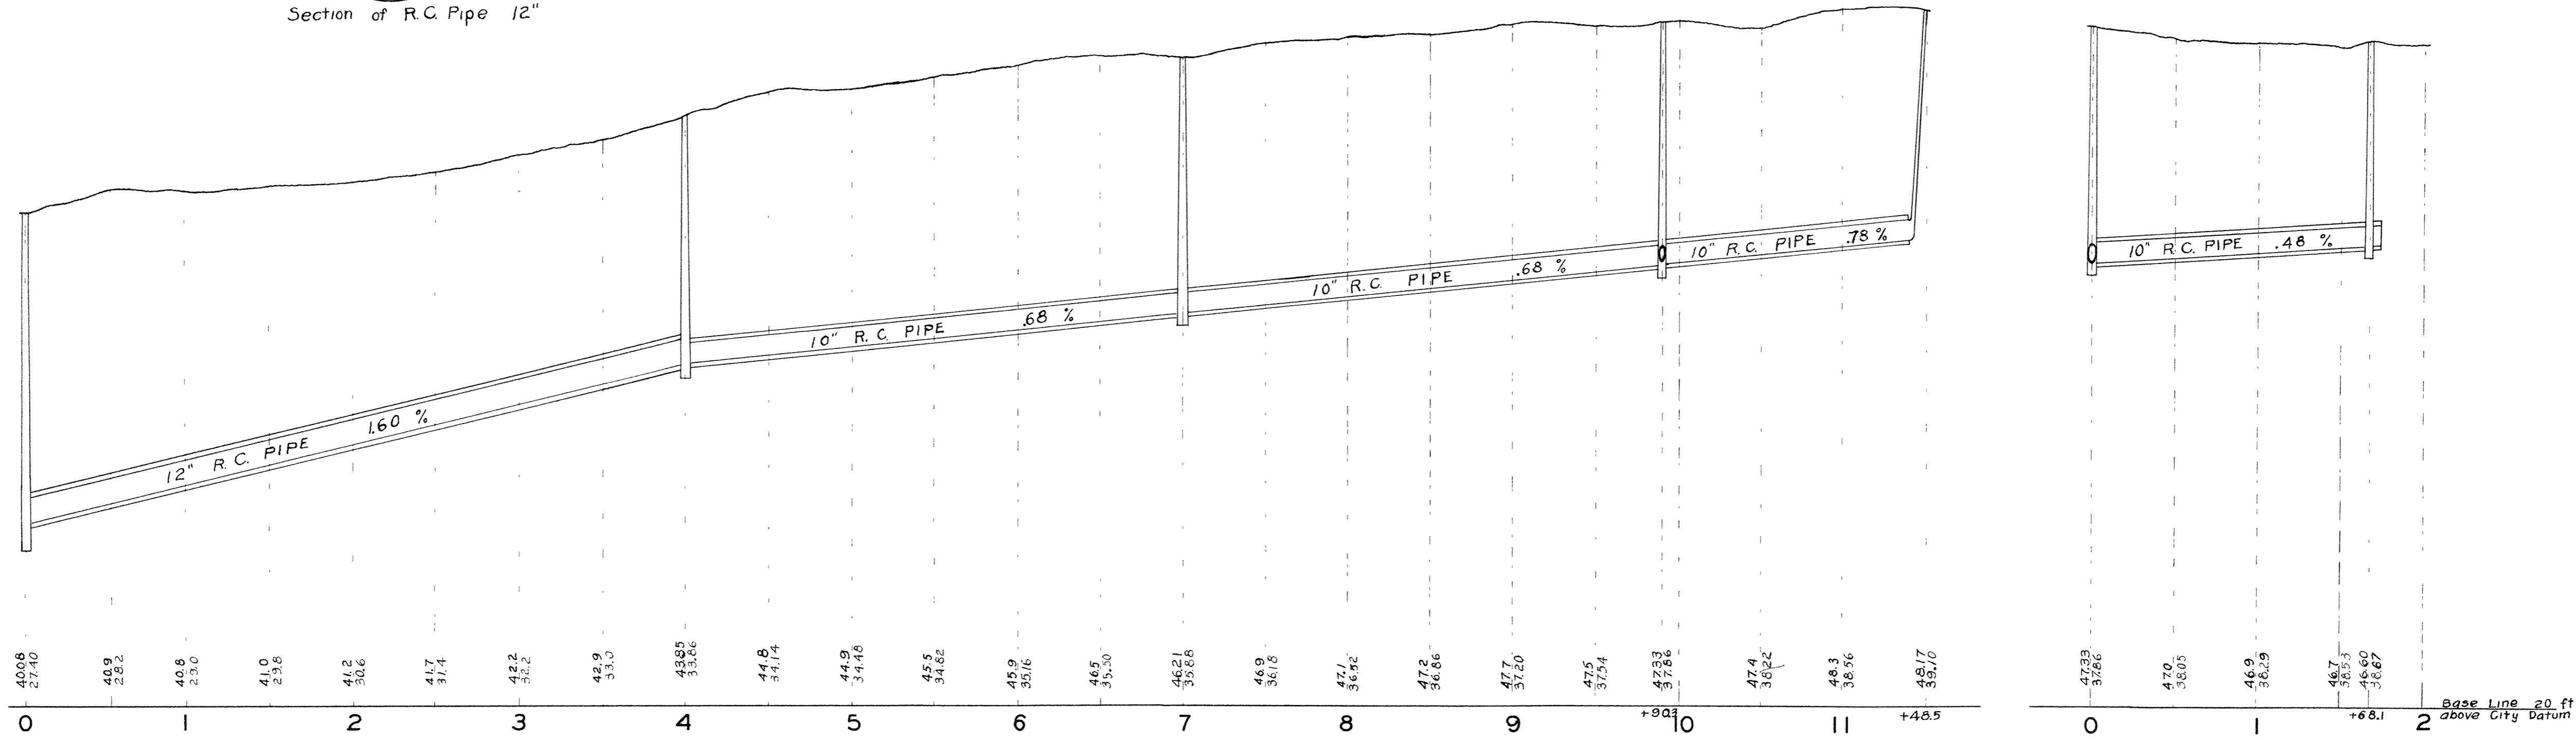


**CITY OF SUPERIOR
SEWER PLAN**

Horizontal Scale: 1 in. = 60 ft.
Vertical Scale: 1 in. = 4 ft.

Job Started Dec. 20, 1935
Job Completed April 20, 1936
W. P. A. Labor
R. H. Dann Inspector
L. W. Peleske City Engineer

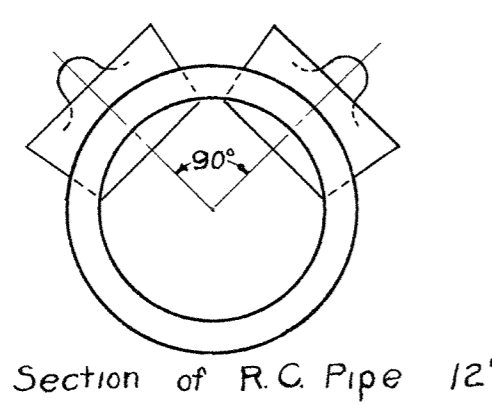

Plan & Profile of Sewer in Alley Bet. E. Tenth & E. Eleventh ST. From 15th Ave. E. TO 17th Ave. E. 3A-31